


Tanks examined dated in black
- tested - - red

T. S. S. "ORONSAY"
630'-0" B.P. (657'-6" O.A.) x 75'-0" x 47'-0" MLD.
CAPACITY SKETCH & TRIM PARTICULARS.
SCALE 1/16 INCH = ONE FOOT.

TONNAGE
GROSS 20043.07 TONS.
NETT. 11352.10 TONS.

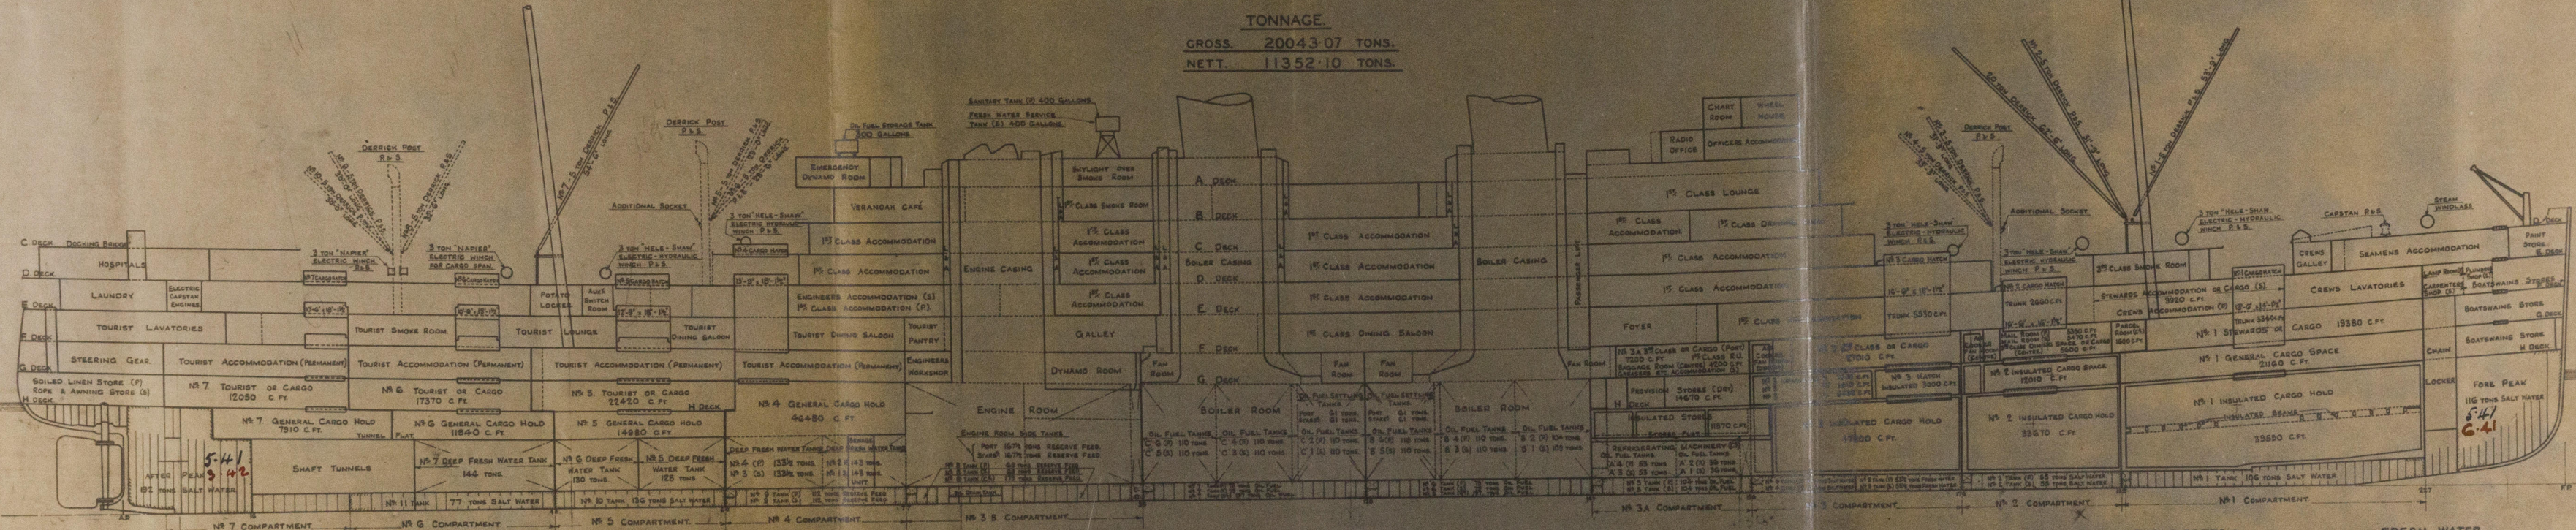

GENERAL CARGO.			
COMPARTMENT.	BALE	EFFECT ON TONNAGE	APPROX.
	CUBIC FT.	UP	DOWN
Nº 4 HOLD.	46480	- 1 1/2	+ 4
5	11840	- 2 1/2	+ 4 1/2
6	11840	- 2 1/2	+ 4 1/2
7	7810	- 3 1/2	+ 5 1/2
1 H. TWEE DECK.	21160	+ 5 1/2	- 2 1/2
TOTAL GENERAL CARGO	102370		

PORTABLE ACCOMMODATION OR CARGO.			
COMPARTMENT.	BALE	EFFECT ON TONNAGE	APPROX.
	CUBIC FT.	UP	DOWN
Nº 5 H. TWEE DECK.	22420	- 1 1/2	+ 4
6	7570	- 2 1/2	+ 4 1/2
7	12050	- 3 1/2	+ 5 1/2
1 G	19580	- 5 1/2	+ 1 1/2
2	5600	+ 4 1/2	- 2
3	42010	+ 3 1/2	- 1 1/2
5A	7200	- 2 1/2	- 1 1/2
1 F	9920	+ 5	- 2 1/2
TOTAL PORTABLE ACCOMMODATION OR CARGO	120950		

INSULATED CARGO.			
COMPARTMENT.	CUBIC FT.	EFFECT ON TONNAGE	APPROX.
		UP	DOWN
Nº 1 HOLD.	39550	- 5 1/2	+ 2 1/2
2	33670	- 4 1/2	+ 1 1/2
3	47800	- 3 1/2	+ 1 1/2
2 H. TWEE DECK.	12010	- 4 1/2	+ 2
3	7550	- 3 1/2	+ 1 1/2
3	6630	- 3 1/2	+ 1 1/2
3	1810	- 3 1/2	+ 1
3	3000	- 3 1/2	+ 1
TOTAL INSULATED CARGO	52000		

TRUNKED HATCHES.			
COMPARTMENT.	BALE	EFFECT ON TONNAGE	APPROX.
	CUBIC FT.	UP	DOWN
Nº 1 TRUNKED HATCH G TO E DECK.	3340		
2	2660		
3	2660		
4	2660		
TOTAL TRUNKED HATCHES	11350		

MAILS, BAGGAGE & PARCELS.			
COMPARTMENT.	CUBIC FT.	EFFECT ON TONNAGE	APPROX.
		UP	DOWN
Nº 2 COMP. MAIL ROOM.	5590		
3	5470		
PARCEL ROOM.	1600		
3A	4200		
TOTAL MAILS, BAGGAGE & PARCELS	16660		

SUMMARY OF CARGO.			
ITEM.	CUBIC FT.	EFFECT ON TONNAGE	APPROX.
GENERAL CARGO.	102370		
PORTABLE ACCOMMODATION OR CARGO.	120950		
TRUNKED HATCHES.	11350		
MAILS, BAGGAGE & PARCELS.	16660		
TOTAL GENERAL CARGO.	251510		
INSULATED CARGO.	152000		
TOTAL CARGO.	403510		

INSULATED STORES.			
COMPARTMENT.	CUBIC FT.	EFFECT ON TONNAGE	APPROX.
		UP	DOWN
FRUIT & VEGETABLE ROOM.	2130		
CHEESE & BACON ROOM.	870		
HANDLING ROOM.	640		
WEEKLY MEAT ROOM.	220		
BUTTER ROOM.	5120		
BULK MEAT ROOM.	710		
BULK SUNDRIES ROOM.	860		
POULTRY ROOM.	1880		
FISH ROOM.	220		
ICE ROOM.	220		
TOTAL INSULATED STORES	11570		

DRY PROVISION STORES.			
COMPARTMENT.	CUBIC FT.	EFFECT ON TONNAGE	APPROX.
		UP	DOWN
FLOUR STORE.	1730		
BULK STORE.	6120		
BULK STORE.	440		
BONDED STORE.	810		
BEER & MINERALS.	3440		
TORACCO STORE.	290		
WINE ROOM.	1840		
TOTAL DRY PROVISION STORES	14670		

SALT WATER BALLAST.			
COMPARTMENT.	TONS	EFFECT ON TONNAGE	APPROX.
		UP	DOWN
Nº 1 DOUBLE BOTTOM TANK.	106	- 5 1/2	+ 5 1/2
2	55	- 2 1/2	+ 1
3	55	- 2 1/2	+ 1
4	64	- 2 1/2	+ 1
5	64	- 2 1/2	+ 1
10	136	- 2 1/2	+ 5 1/2
11	77	- 2 1/2	+ 3 1/2
TOTAL SW BALLAST IN DB	557		
FOR PEAK TANKS	116	- 7 1/2	+ 4 1/2
AFTER	192	- 7 1/2	+ 11 1/2
TOTAL SALT WATER BALLAST	865		


OIL FUEL BUNKERS.			
COMPARTMENT.	TONS	EFFECT ON TONNAGE	APPROX.
		UP	DOWN
A 1 BUNKER	36	- 1	+ 1
A 2	36	- 1	+ 1
A 3	36	- 1	+ 1
A 4	36	- 1	+ 1
B 1	109	- 2 1/2	+ 2 1/2
B 2	104	- 2 1/2	+ 2 1/2
B 3	110	- 2 1/2	+ 2 1/2
B 4	110	- 2 1/2	+ 2 1/2
B 5	110	- 2 1/2	+ 2 1/2
B 6	110	- 2 1/2	+ 2 1/2
C 1	110	- 2 1/2	+ 2 1/2
C 2	110	- 2 1/2	+ 2 1/2
C 3	110	- 2 1/2	+ 2 1/2
C 4	110	- 2 1/2	+ 2 1/2
C 5	110	- 2 1/2	+ 2 1/2
C 6	110	- 2 1/2	+ 2 1/2
TOTAL OIL FUEL BUNKERS	1241		
TOTAL OIL FUEL CAPACITY	7645		

OIL FUEL IN DOUBLE BOTTOM.			
COMPARTMENT.	TONS	EFFECT ON TONNAGE	APPROX.
		UP	DOWN
Nº 5 DOUBLE BOTTOM TANK.	104	- 5 1/2	+ 5 1/2
5	104	- 5 1/2	+ 5 1/2
6	75	- 3 1/2	+ 3 1/2
6	75	- 3 1/2	+ 3 1/2
7	197	- 4 1/2	+ 4 1/2
7	197	- 4 1/2	+ 4 1/2
7	79	- 4 1/2	+ 4 1/2
7	197	- 4 1/2	+ 4 1/2
TOTAL OIL FUEL IN DOUBLE BOTTOM	910		

OIL FUEL SETTLING TANKS.			
COMPARTMENT.	TONS	EFFECT ON TONNAGE	APPROX.
		UP	DOWN
TOTAL OIL FUEL SETTLING TANKS	244		

FRESH WATER.			
COMPARTMENT.	TONS	EFFECT ON TONNAGE	APPROX.
		UP	DOWN
Nº 1 DEEP FRESH WATER TANK.	143	- 1 1/2	+ 4 1/2
2	143	- 1 1/2	+ 4 1/2
3	133 1/2	- 1 1/2	+ 4 1/2
4	133 1/2	- 1 1/2	+ 4 1/2
5	128	- 2 1/2	+ 5 1/2
6	130	- 2 1/2	+ 5 1/2
7	144	- 3 1/2	+ 6 1/2
3 DOUBLE BOTTOM TANK.	53 1/2	- 2 1/2	+ 5 1/2
3	53 1/2	- 2 1/2	+ 5 1/2
TOTAL FRESH WATER	1062		

RESERVE FEED WATER.			
COMPARTMENT.	TONS	EFFECT ON TONNAGE	APPROX.
		UP	DOWN
SIDE TANK IN ENGINE ROOM.	167 1/2	- 1 1/2	+ 4 1/2
8	167 1/2	- 1 1/2	+ 4 1/2
8	69	- 1 1/2	+ 4 1/2
8	179	- 1 1/2	+ 4 1/2
9	112	- 1 1/2	+ 4 1/2
9	112	- 1 1/2	+ 4 1/2
TOTAL RESERVE FEED WATER	876		

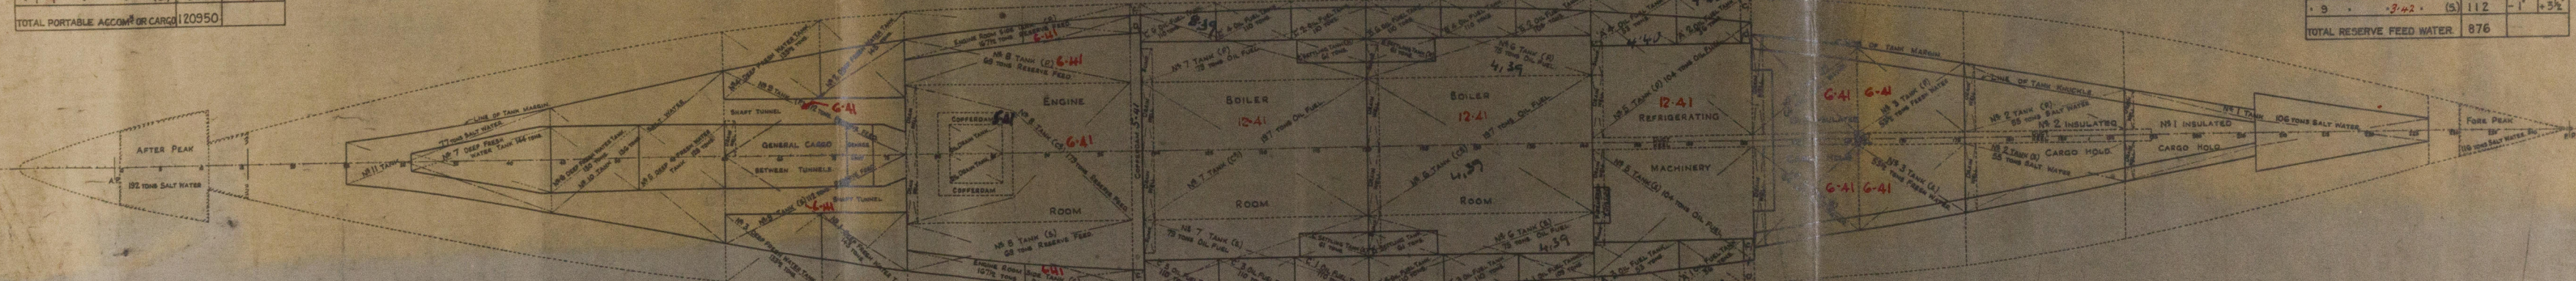

S.S. "Oronsay" (built 1925-1)

Gl. 44328.

Capacity plan & trim particulars (for progressive
Survey of tanks)

File in plan bag

W107-0015



© 2019

Lloyd's Register
Foundation