

T.S. 500-


630'-0" B.P. + 75'-0" M<sup>2</sup> + 47'-0" NLP

LOWER OROP DECKS G & H

SCALE 1/2" = 1' FT.

NOTE: L<sup>2</sup>

WHEN DECK PLATED AT END AND LESS THAN  
KILE WIDTH A 1/2" STRENGTH THE ADJACENT SPACE  
TO BE INCREASED IN PROPORTION

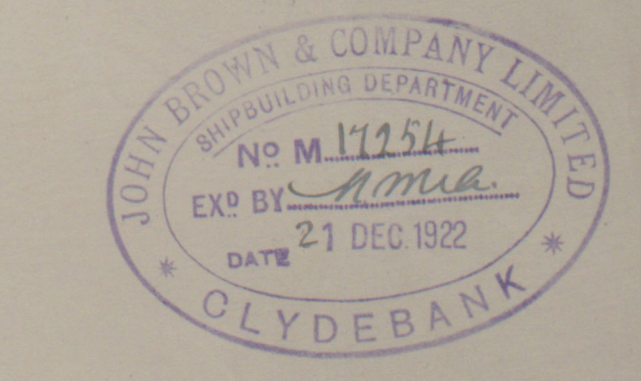



LOWER DECK G

RYETING

TO BE SPACED AT 12" ON CENTER. TO BE DOUBLE RIVETED.  

APPROVED  
LLOYD'S REGISTER OF SHIPPING  
J. H. G. 6.1.23

OROP DECK

  



G & H. DECKS

- T. S. S. 500 -

John Brown & Co

GLASGOW REPORT No. 44328

J. D. D. "Oronsay"

W107-0018



© 2020

Lloyd's Register  
Foundation