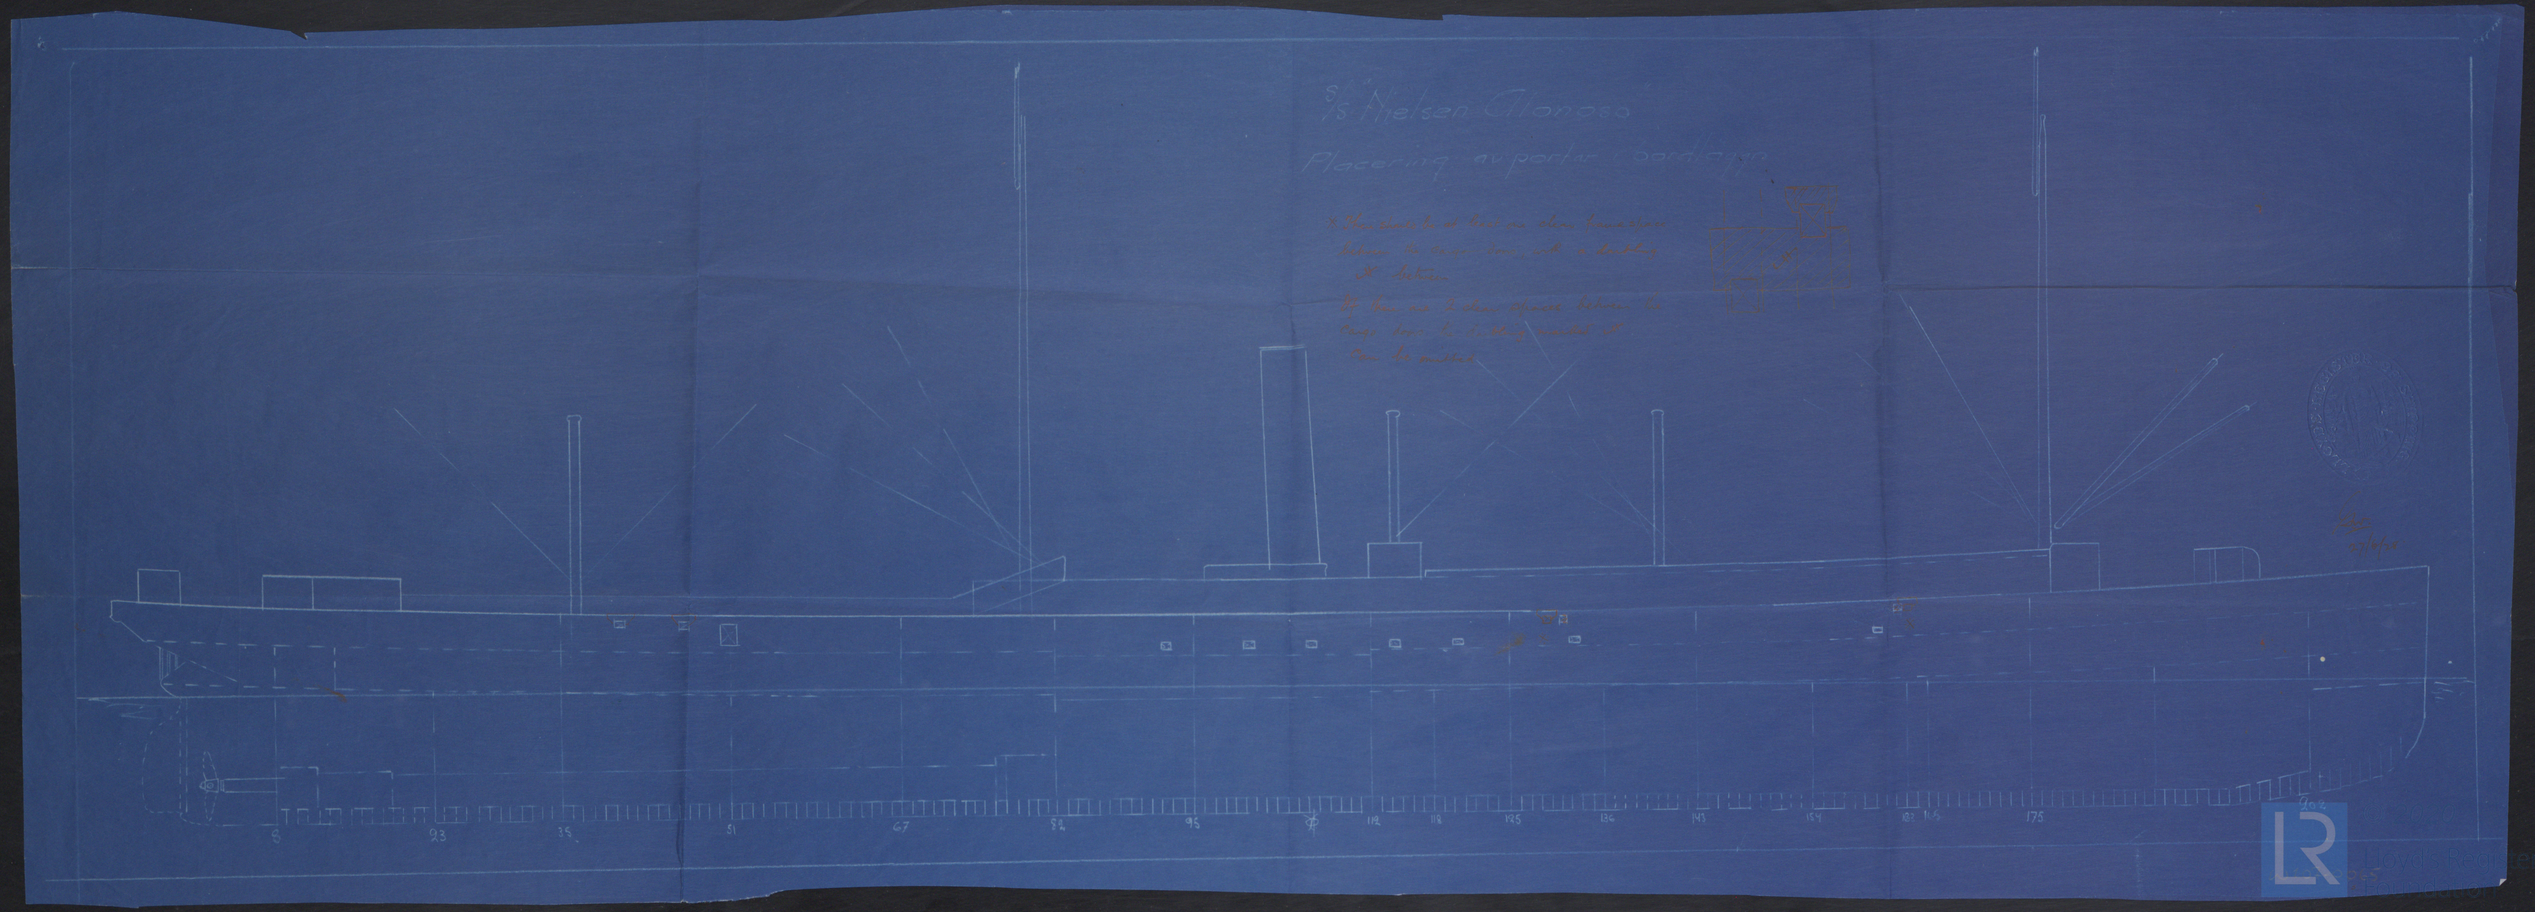
S/S "Nielsen Alonso"
Placering av porter i oordlagen
8
23
35
51
67
82
95
112
118
125
136
143
154
175