#54069

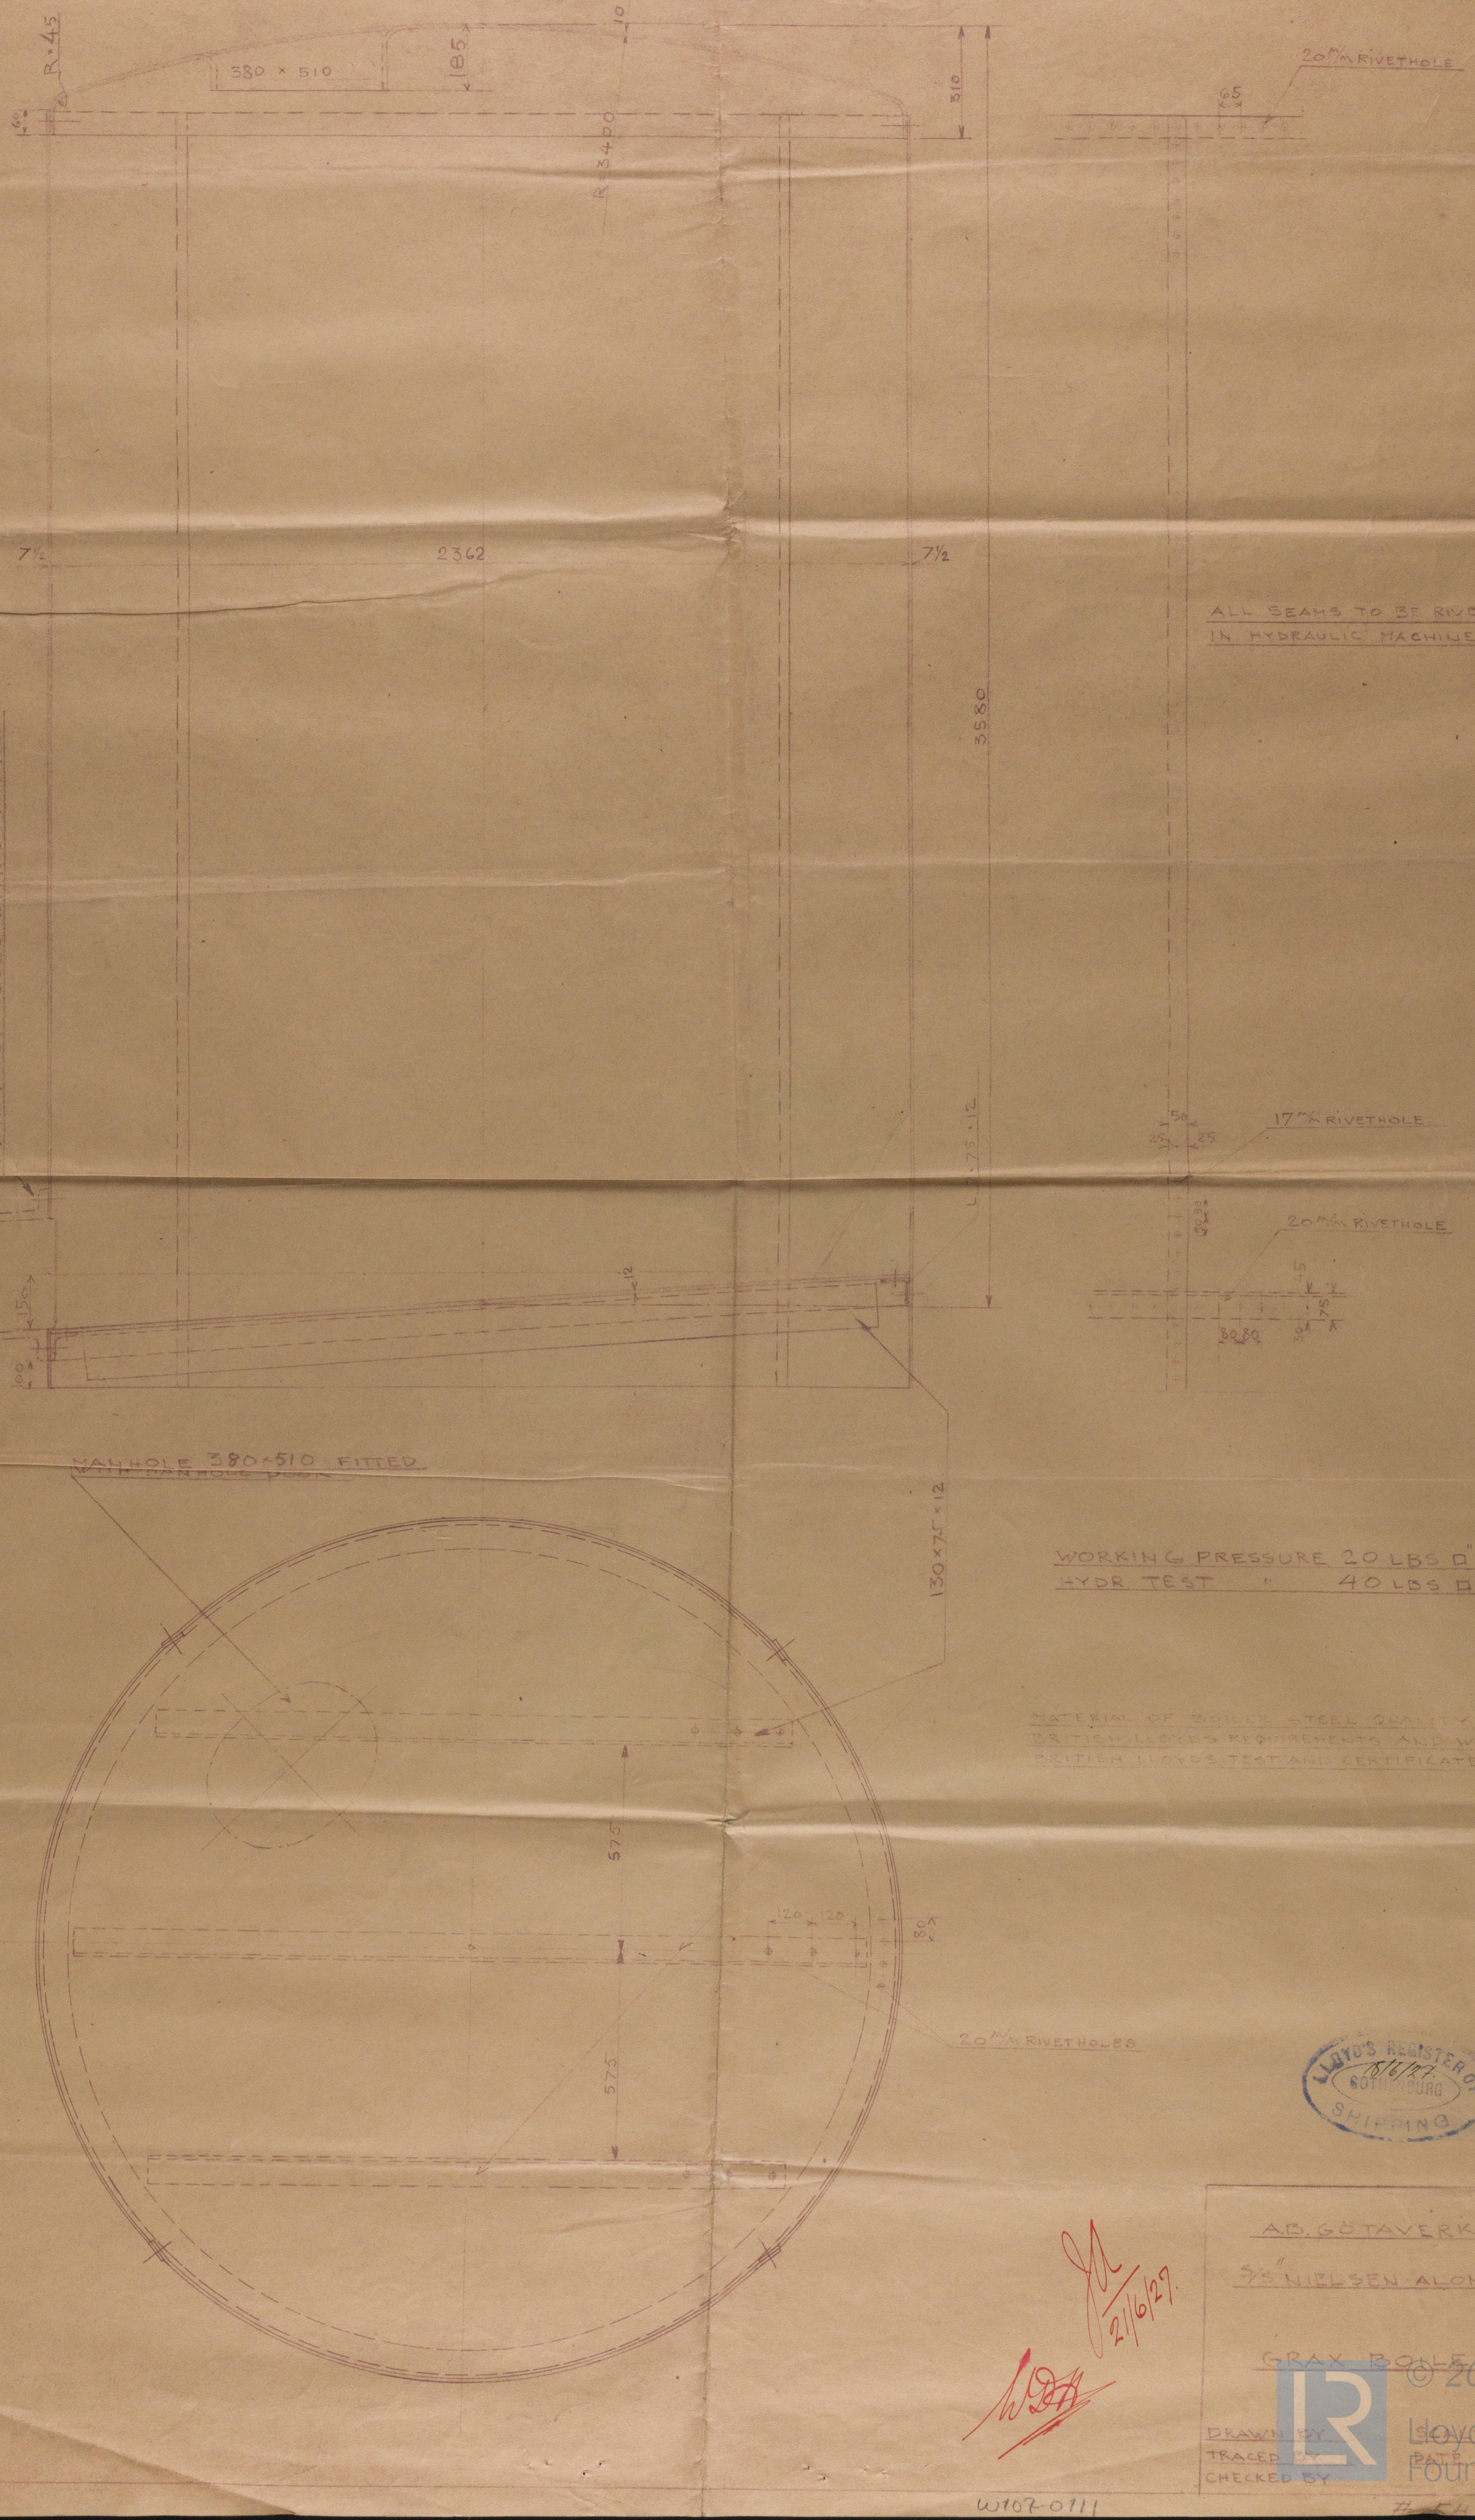

ALL SEAMS TO BE RIVETED IN HYDRAULIC MACHINE

WORKING PRESSURE 20 LBS □"
HYDR TEST " 40 LBS □"

MATERIAL OF BOILER STEEL QUALITY TO BRITISH LLOYDS REQUIREMENTS AND WITH BRITISH LLOYDS TEST AND CERTIFICATE

LLOYD'S REGISTER OF SHIPPING GOTHENBURG 15/6/27.

21/6/27.

AB. GÖTAVERKEN

S/S "NIELSEN ALONSO"

GRAX BOILER

DRAWN BY
TRACED BY
CHECKED BY
DATE 18/6/27

© 2019 Lloyd's Register Foundation

#54069

W107-0111

#54069