
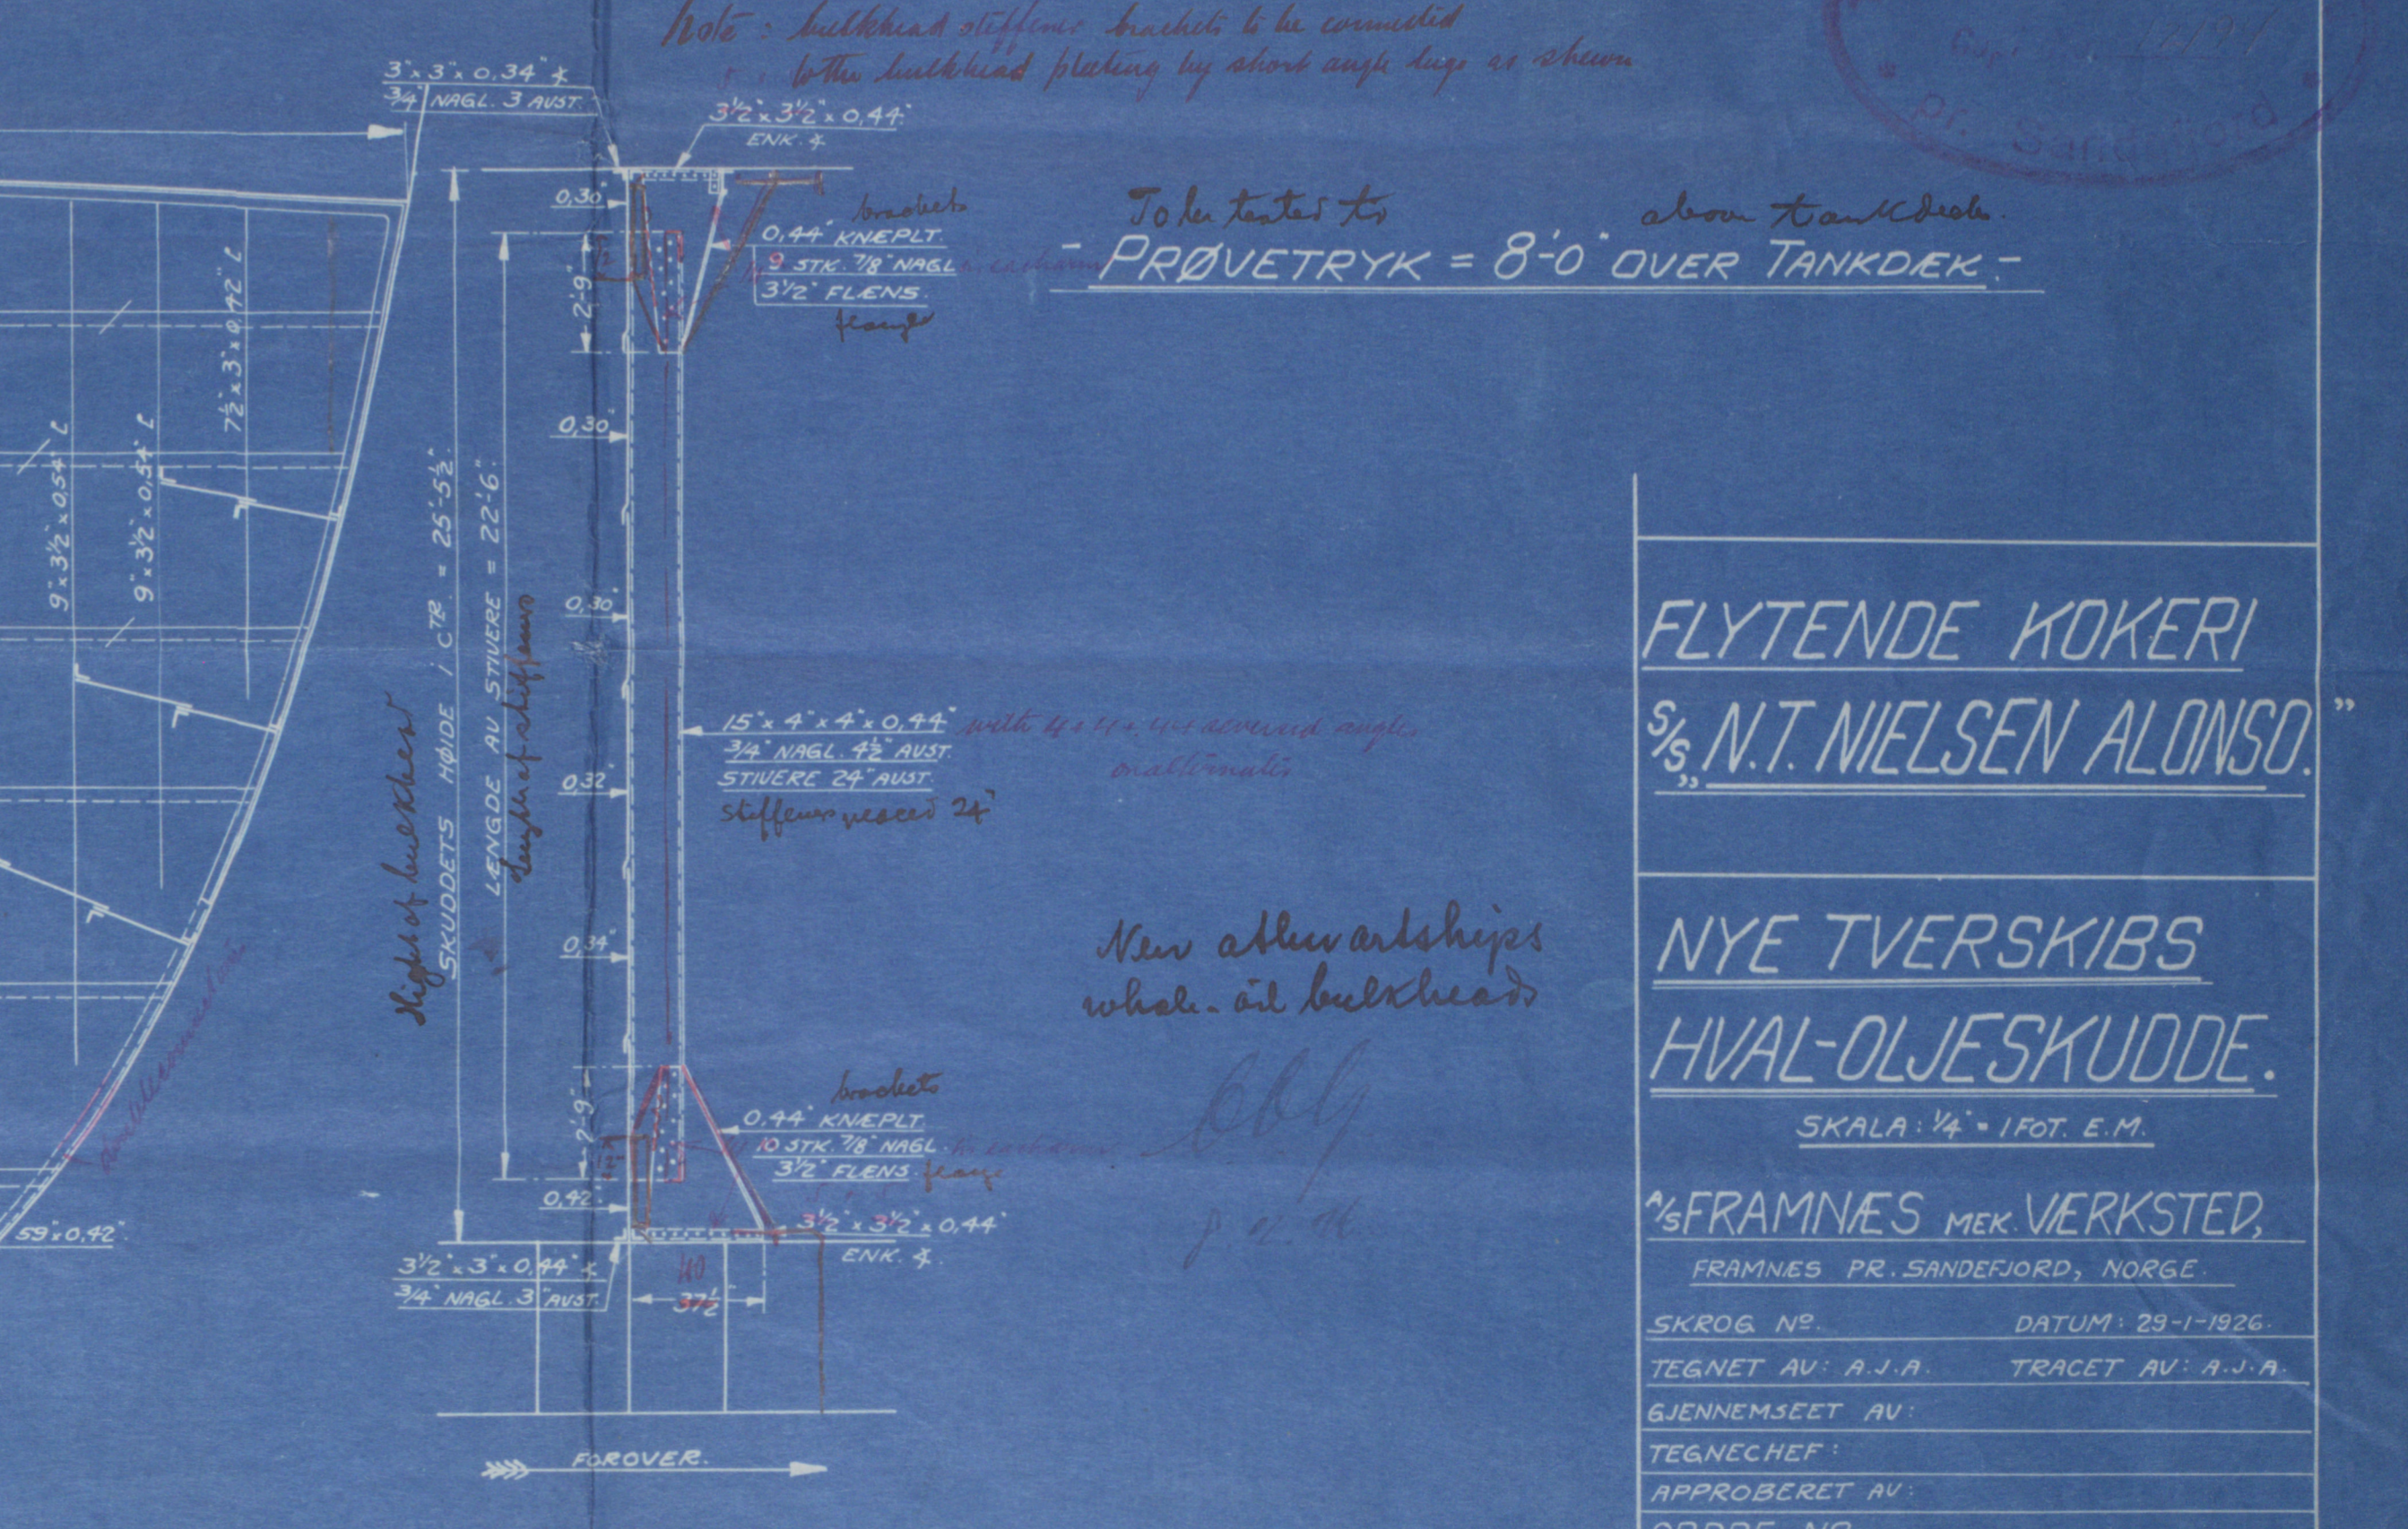
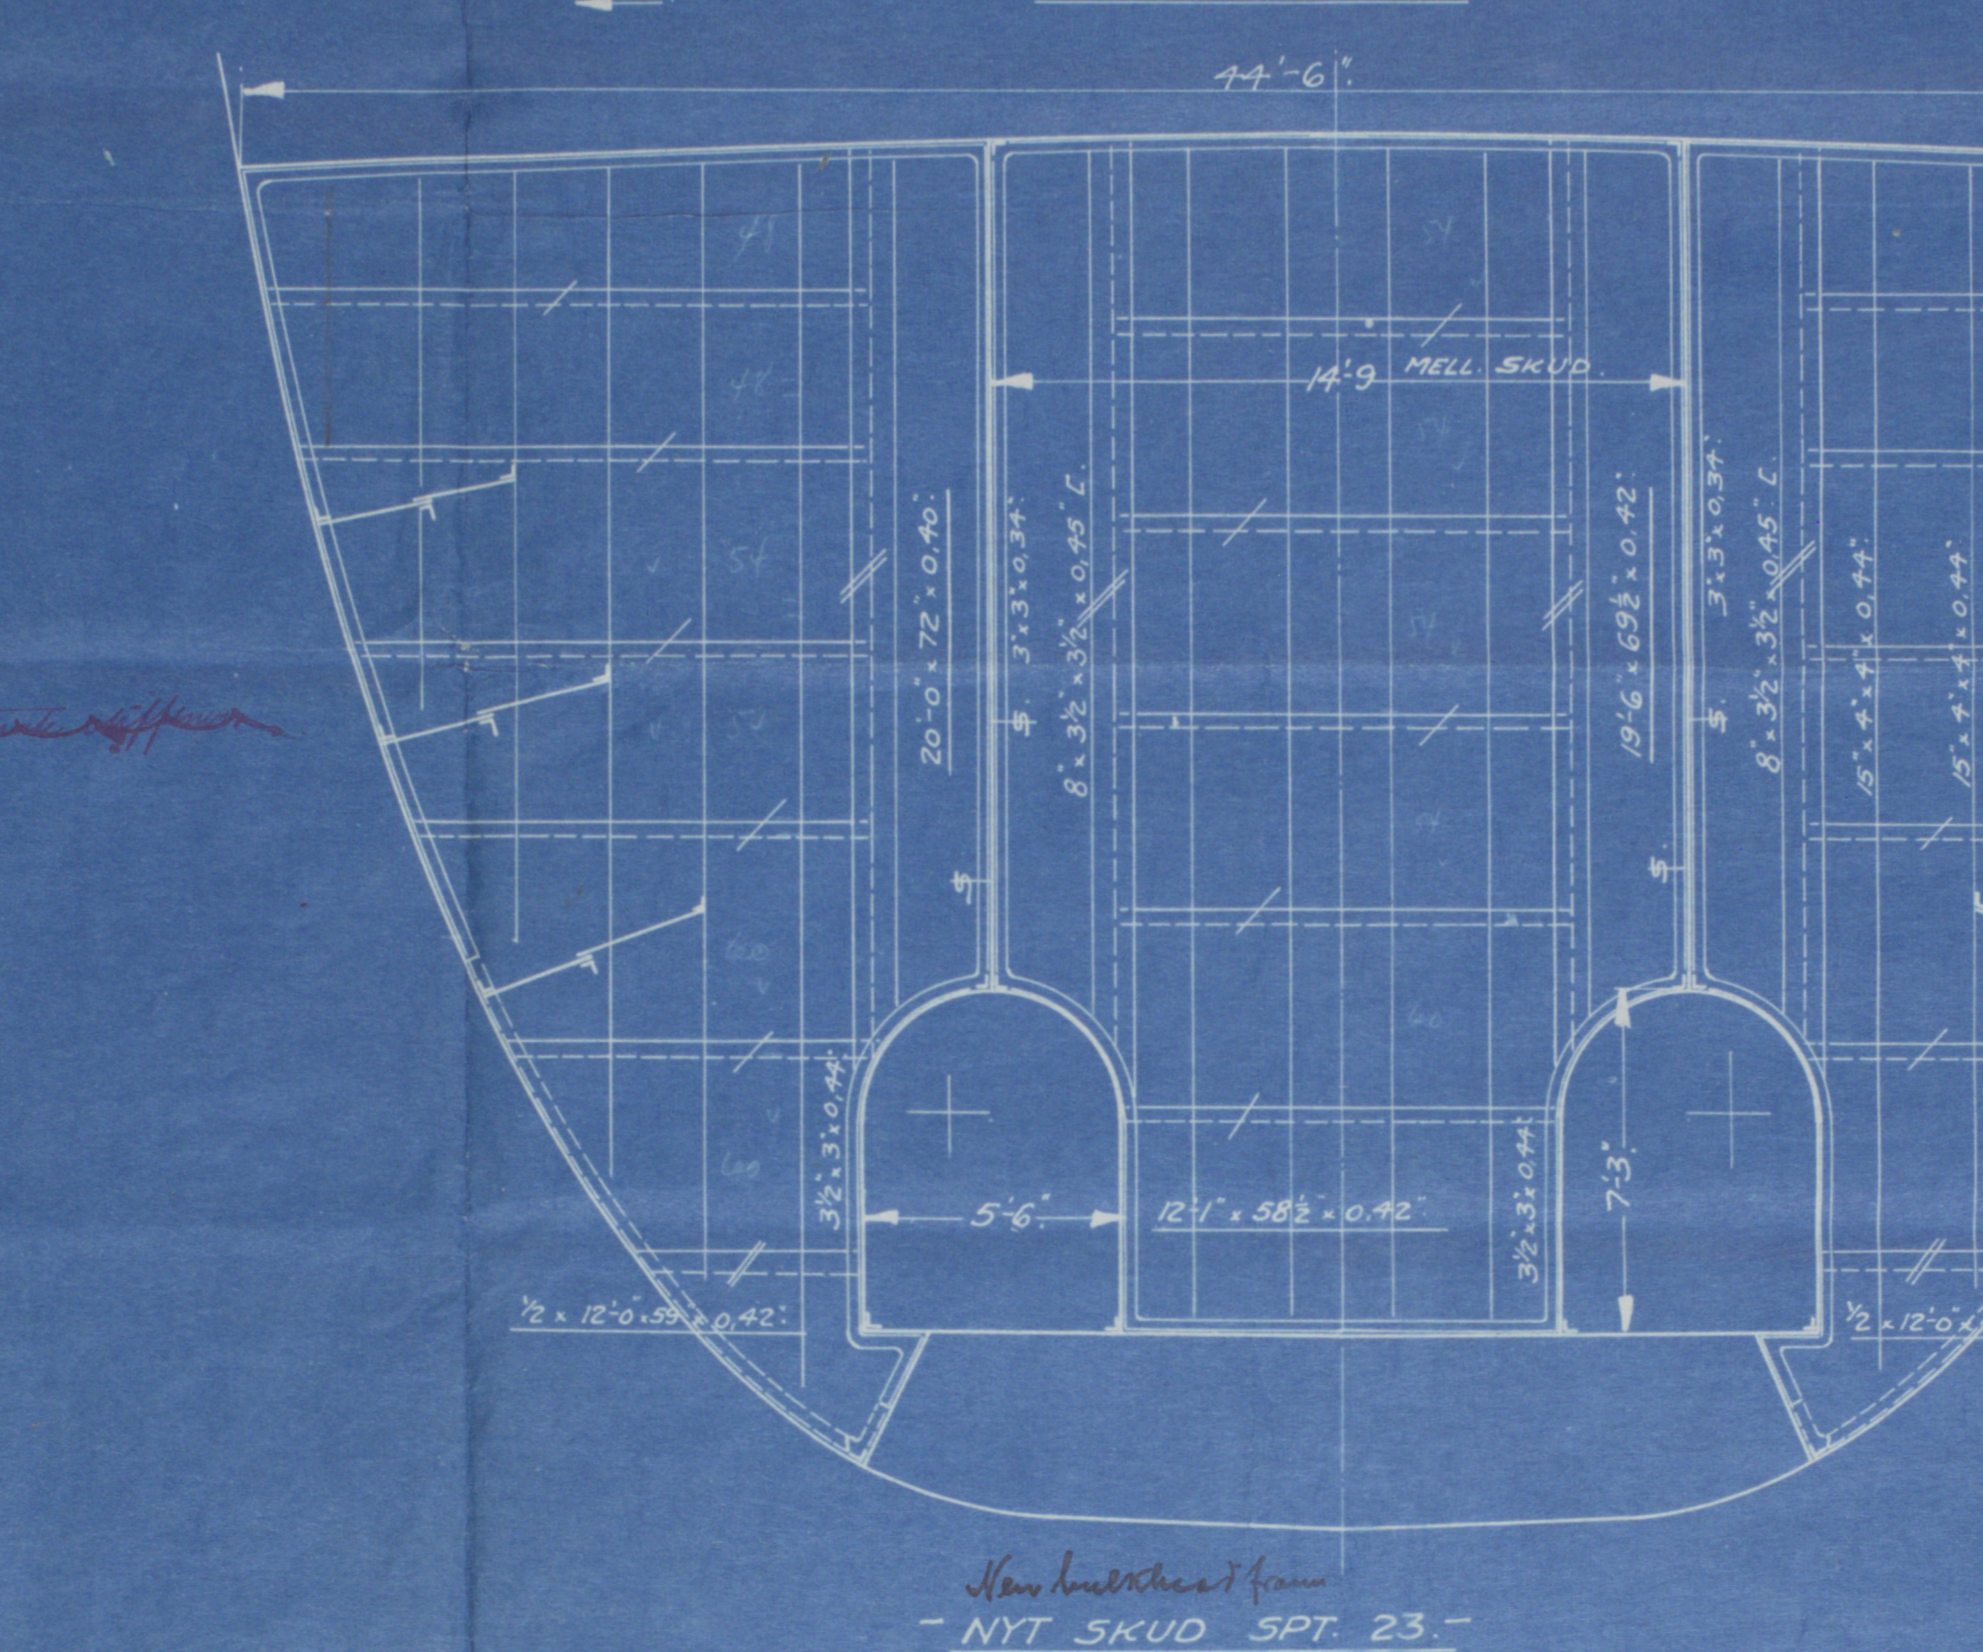
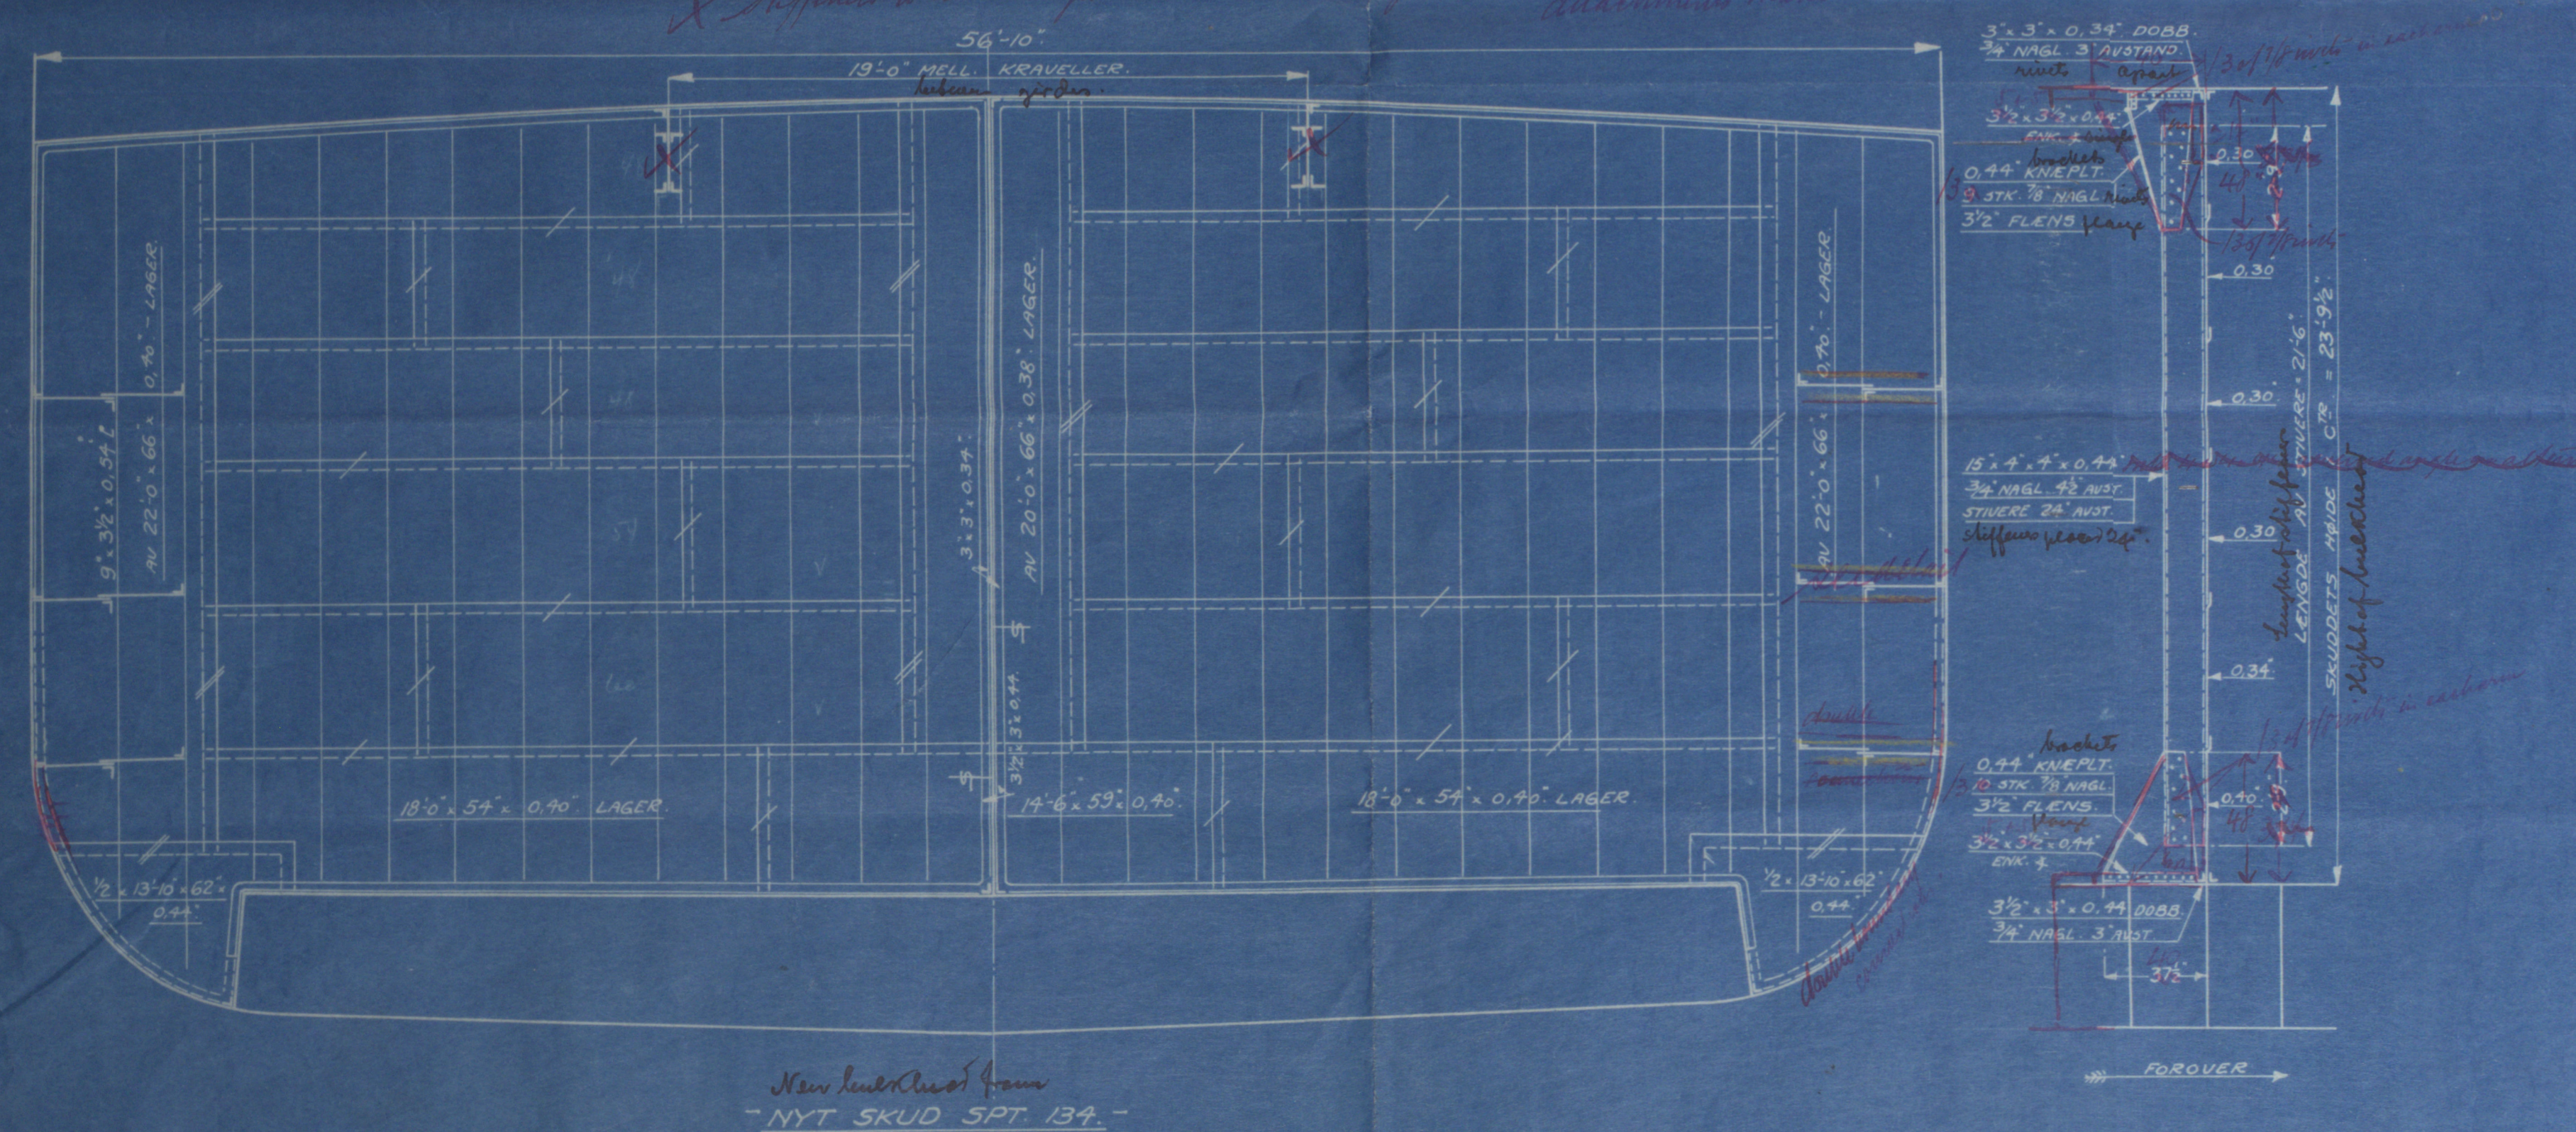
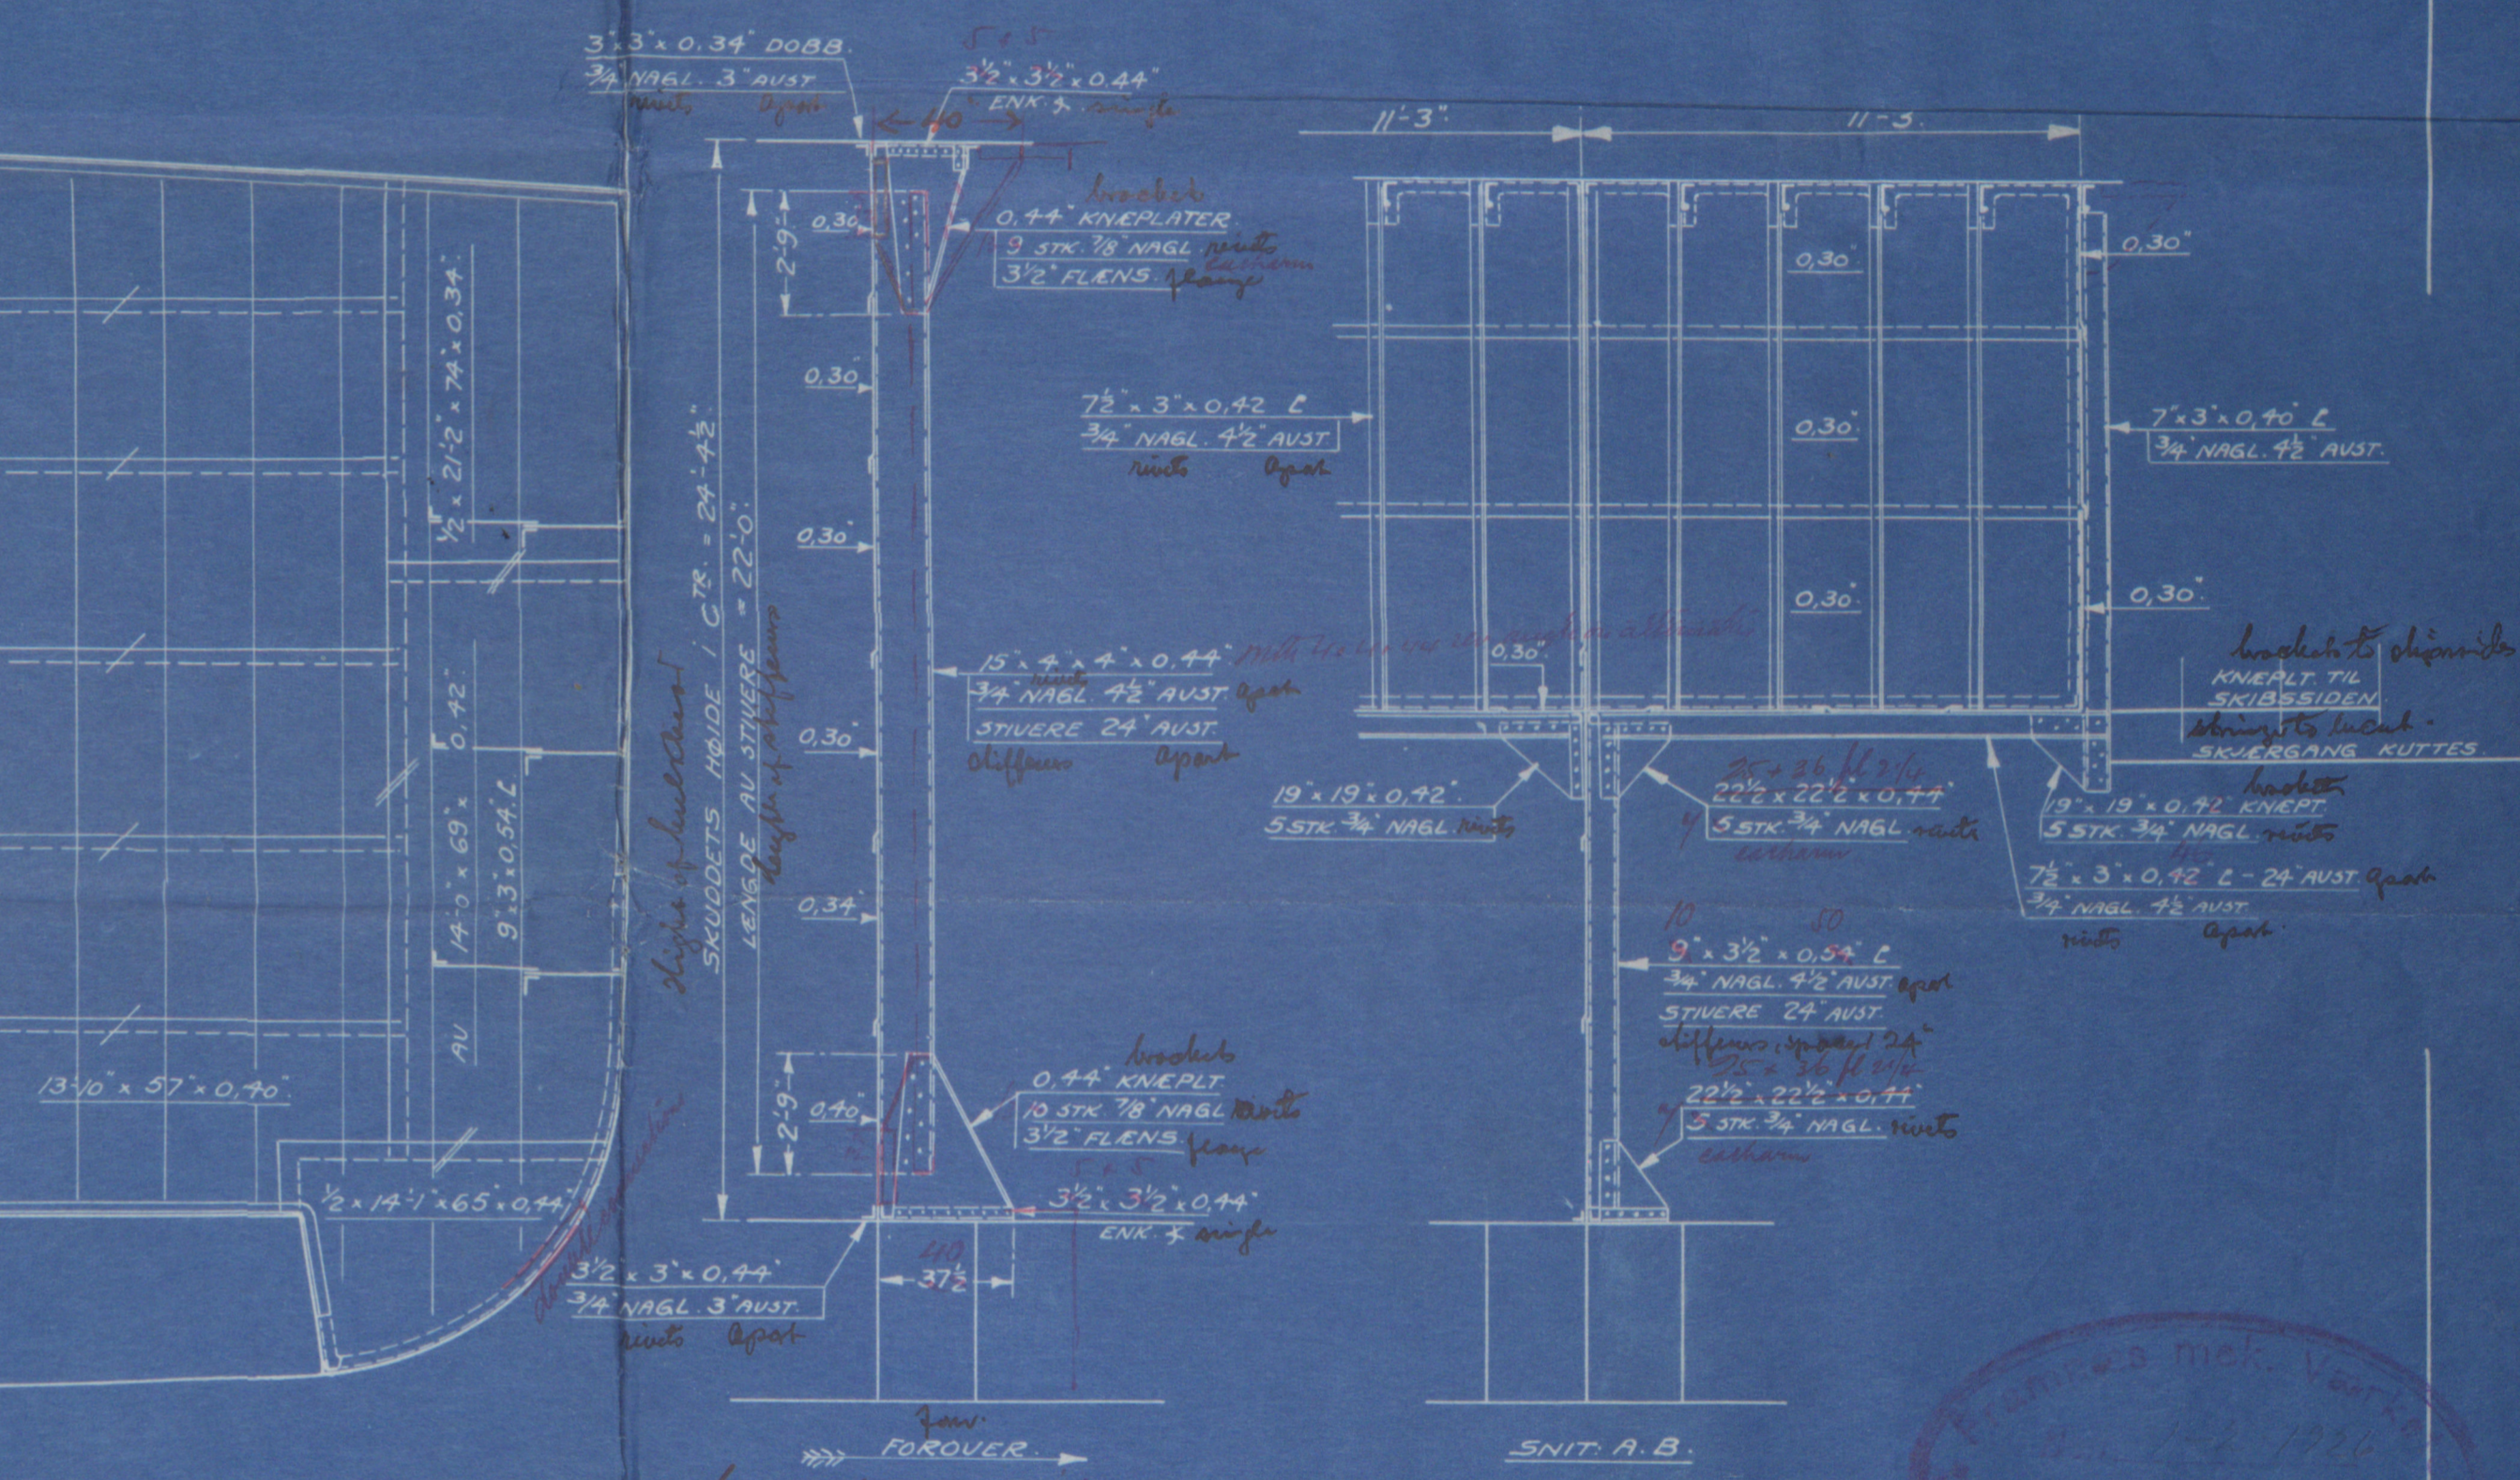
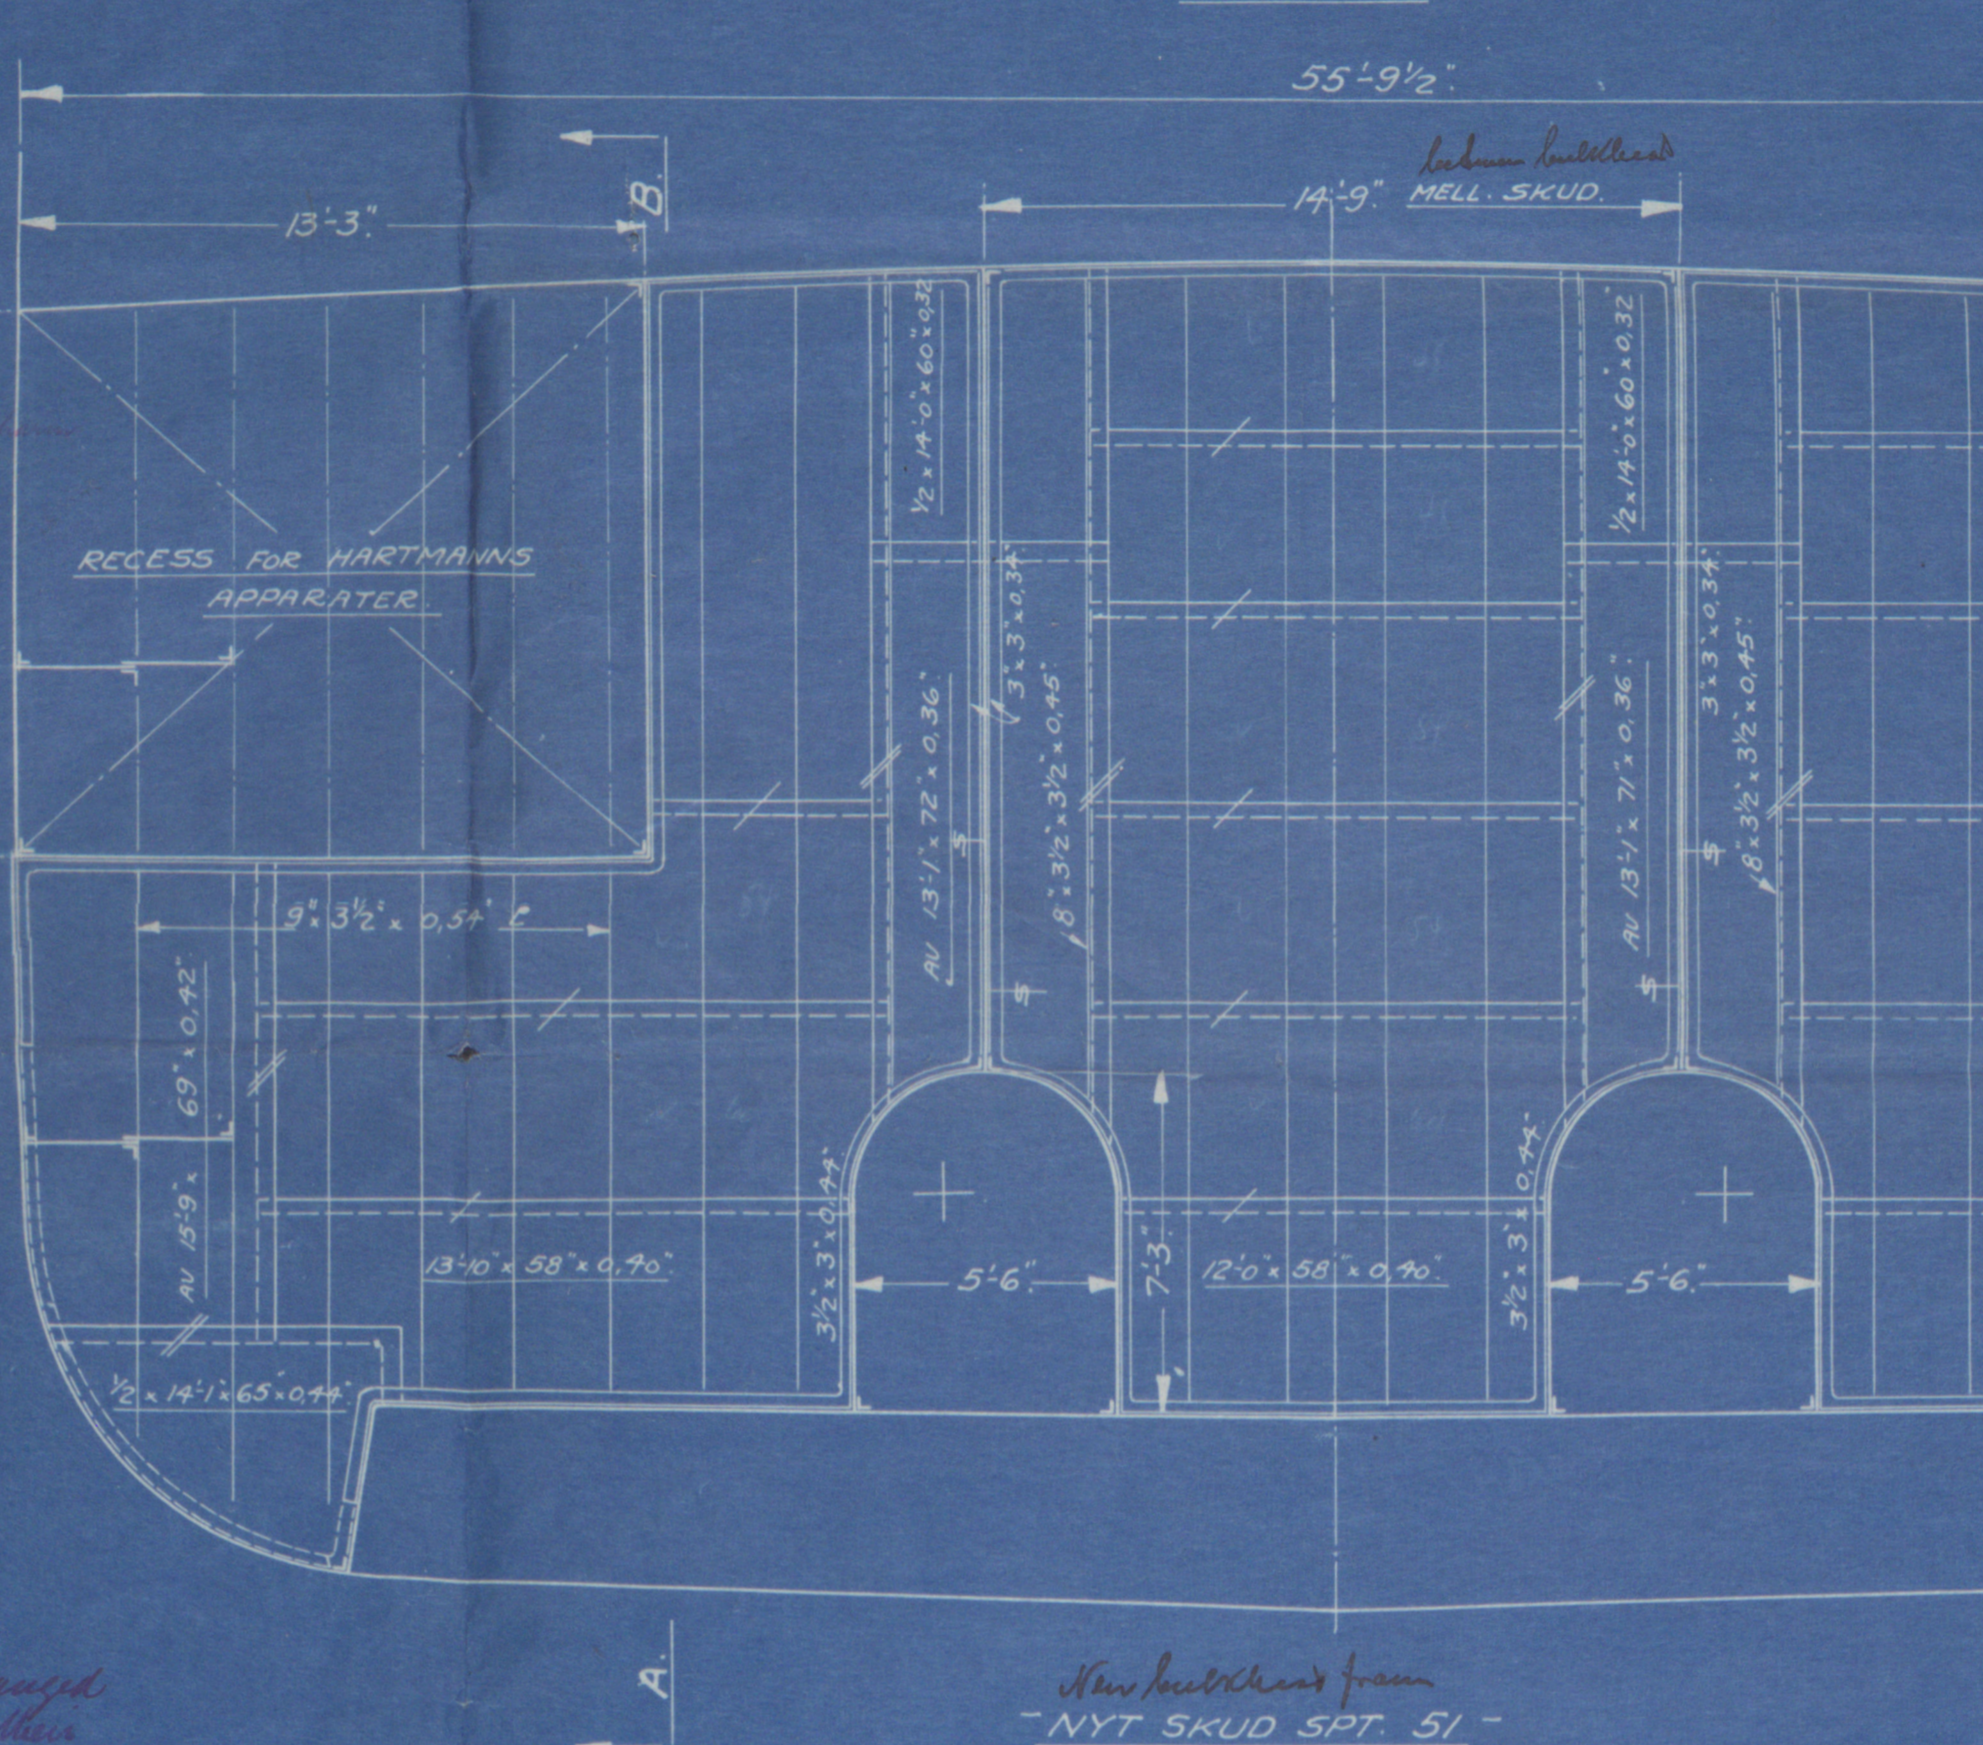


ANB. JAR		ANB. DATED	
ANB.	FORANDRINGER	DATUM	ANB.
1			
2			
3			
4			
5			

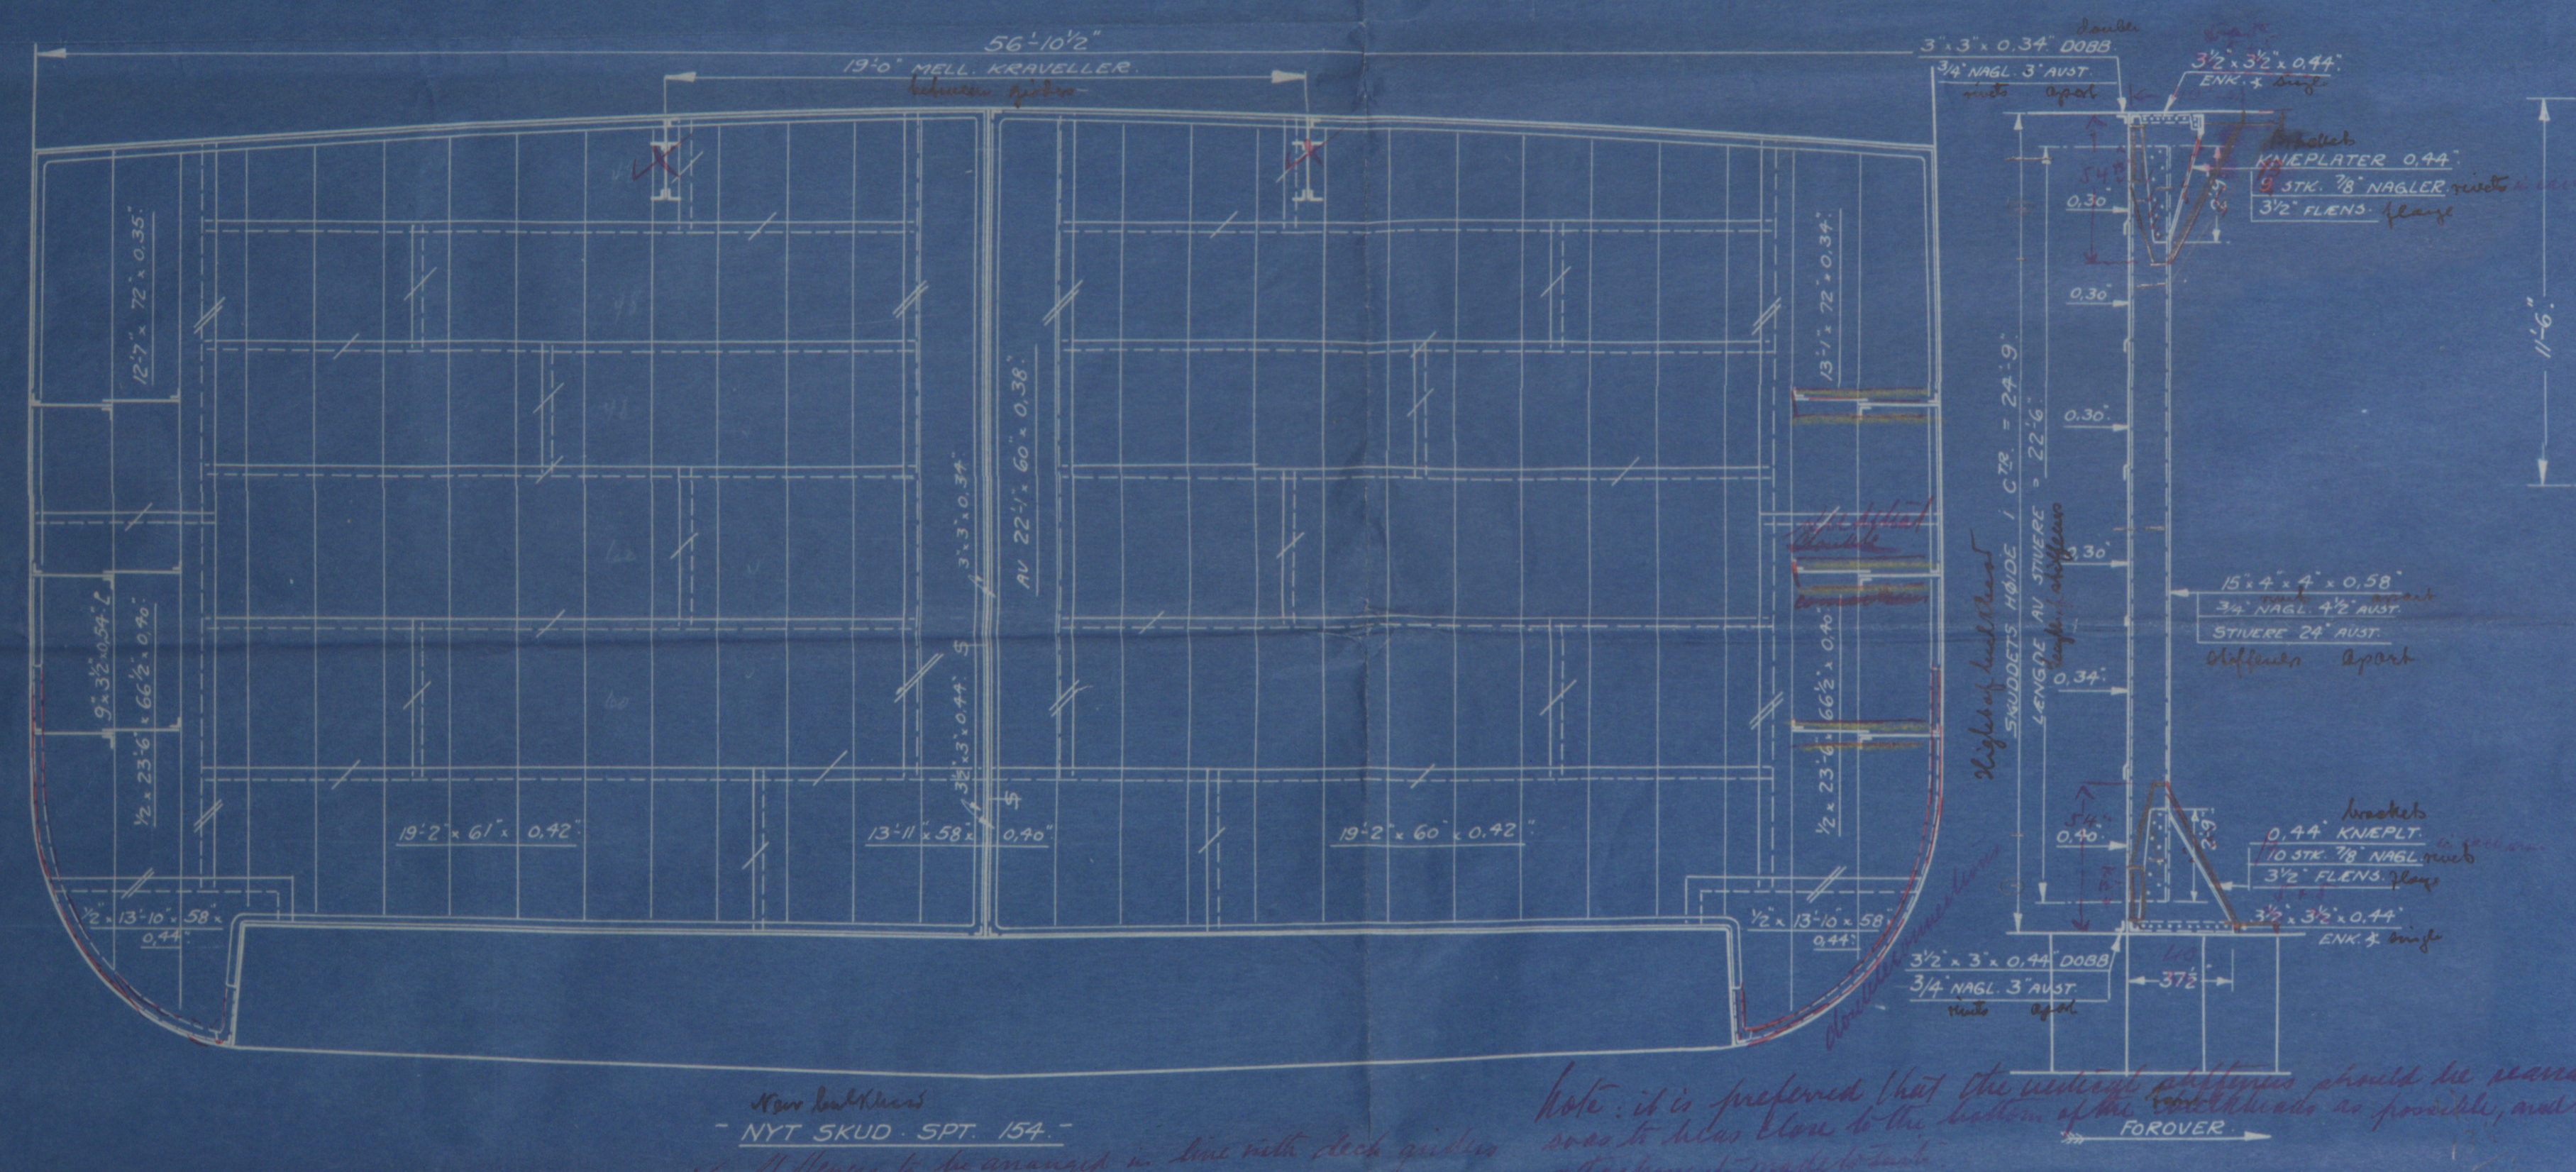

FLYTENDE KOKERI
N.T. NIELSEN ALONSO.

NYE TVERSKIBS
HVAL-OLJESKUDDE.

SKALA: 1/4" = 1'0" E.M.

FRAMNES MEK. VERKSTED.
FRAMNES PR. SANDEFJORD, NORGE.


SKROG N^o DATUM: 29-1-1926.
TEGNET AV: A.J.A. TRACET AV: A.J.A.
GJENNEMSEET AV:
TEGNEHEF: APPROBERET AV:
ORDRE N^o

TRACING N^o
SKUD

How Transverse Blids

Whalio's Taulio

W107-0185

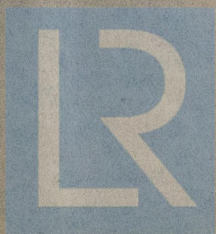

© 2020

Lloyd's Register
Foundation