

10.6.98


Plan view showing Girders, Beams, Stanchions, Web Frames etc

under the Lower Deck

Steel Twin Screw Steamer No 252

Scale 1/8" = one foot

No 1. Lower Beam & Girder 20 x 13

 

18M

20/5/98

10/6/98



C. Connell No: 252


" " " " " "  
S.S. "Custodian"

n.n. "N.T. Nielsen-Monaco"

Glasgow Report

No. 17720

W107-0211

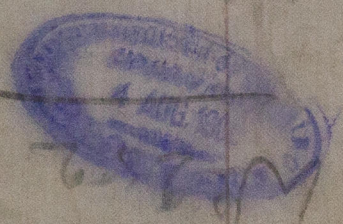

© 2020

Lloyd's Register  
Foundation