


PROFILE *S/S Lowland Firth*
STEEL SCREW STEAMER No. 60
DIMENSIONS 135'-0" B.P. x 23'-3" x 10'-6" M/L
CLASS 100 A1
Scale 1/4" = 1 Foot.

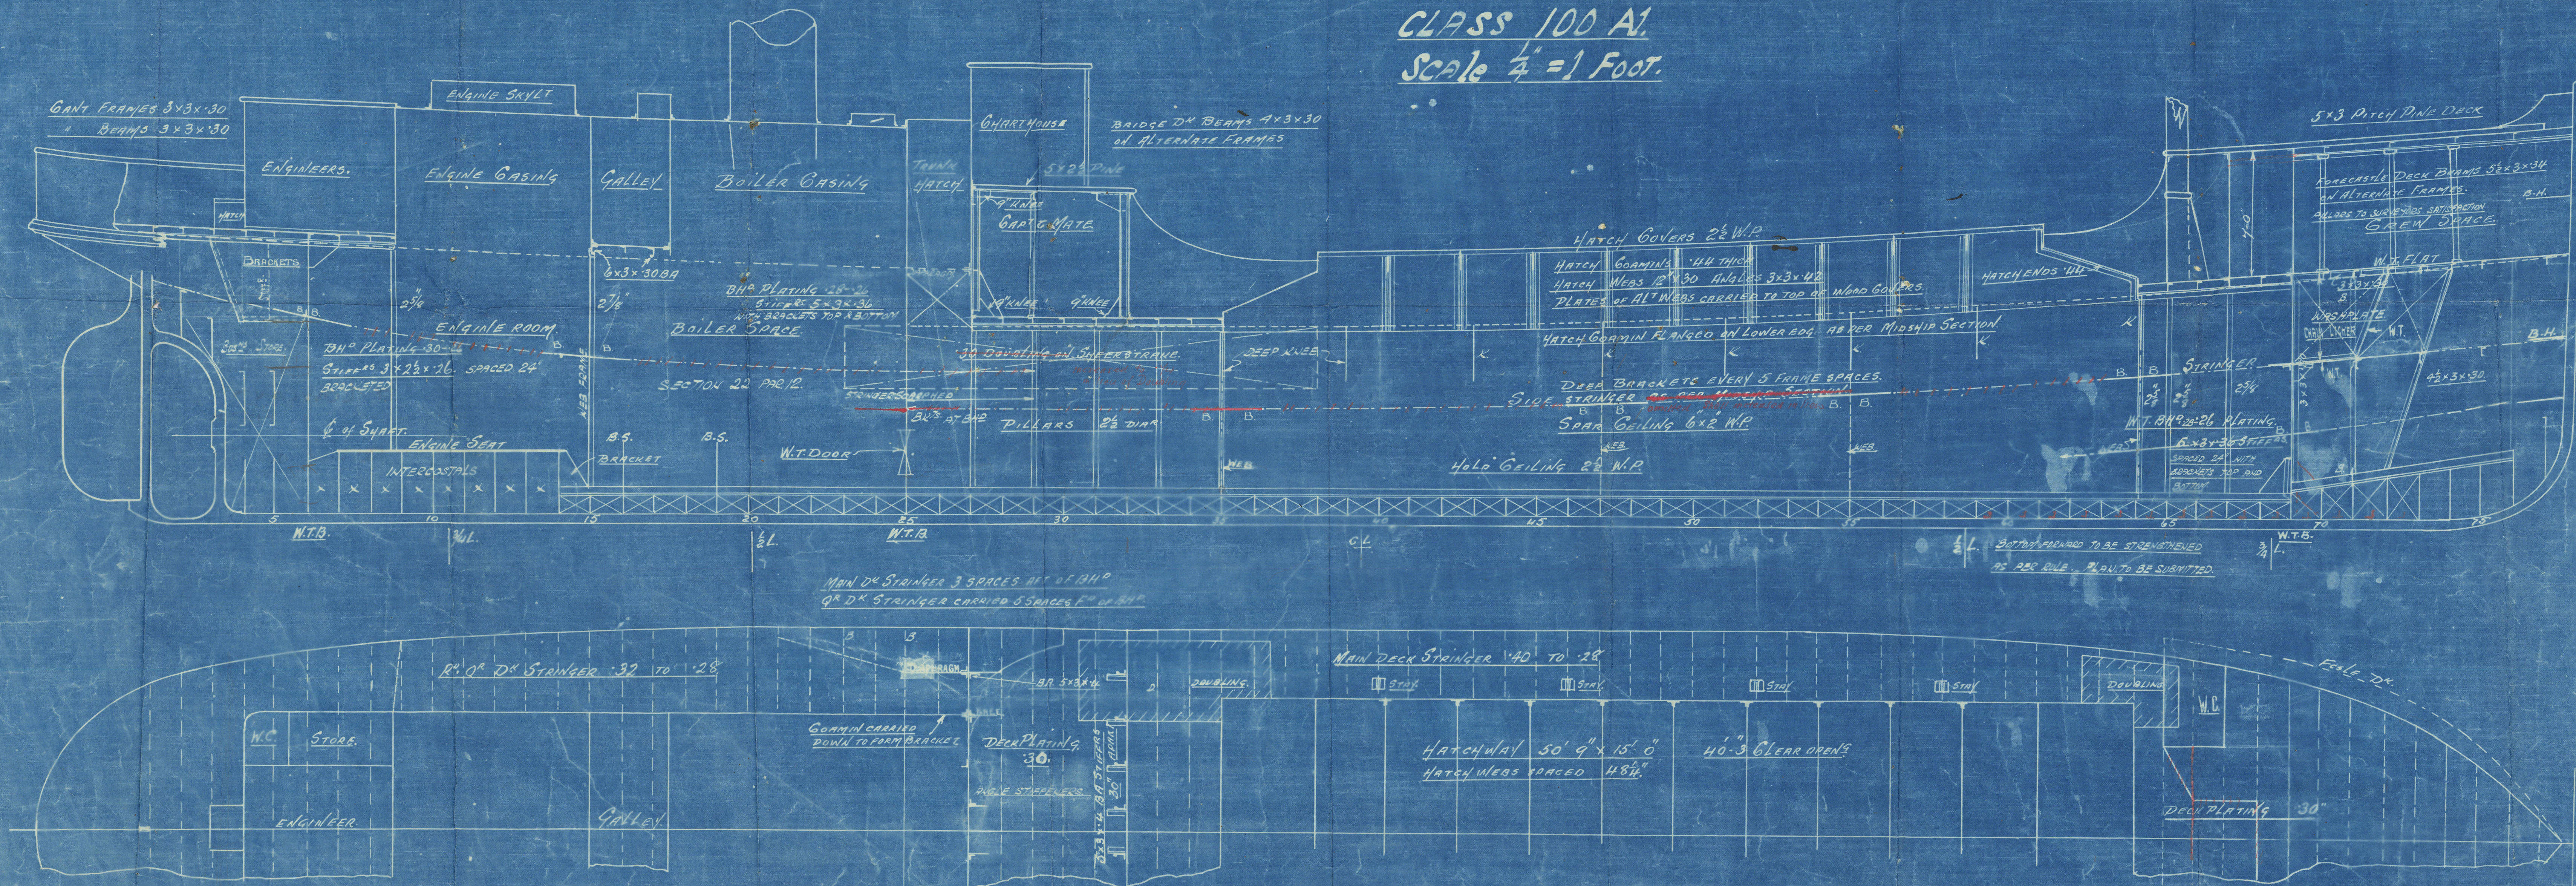

"SNOWCRETE"
S/S "LOWLAND
FIRTH"

PROFILE AS FITTED

NEWCASTLE ON TYNE.

Report No. 74232

"WARREN GROVE X"



© 2020
W1070-0307

Lloyd's Register

W1070-0307