

5800-101M

N°182

PROFILE & DECK PLAN


DIMNS:- 164'-0" x 24'-6" x 10'-6" MLD

SCALE:- 1/4" = 1' FOOT

TO CLASS 100 A1 CARRYING PETROLEUM IN BULK

STIFFENING UNDER WINDLASS, WINCHES
ETC. TO SURVEYORS SATISFACTION

STEEL DECK FORECASTLE 30"
STRINGER BAR 2 1/2" x 3/4"

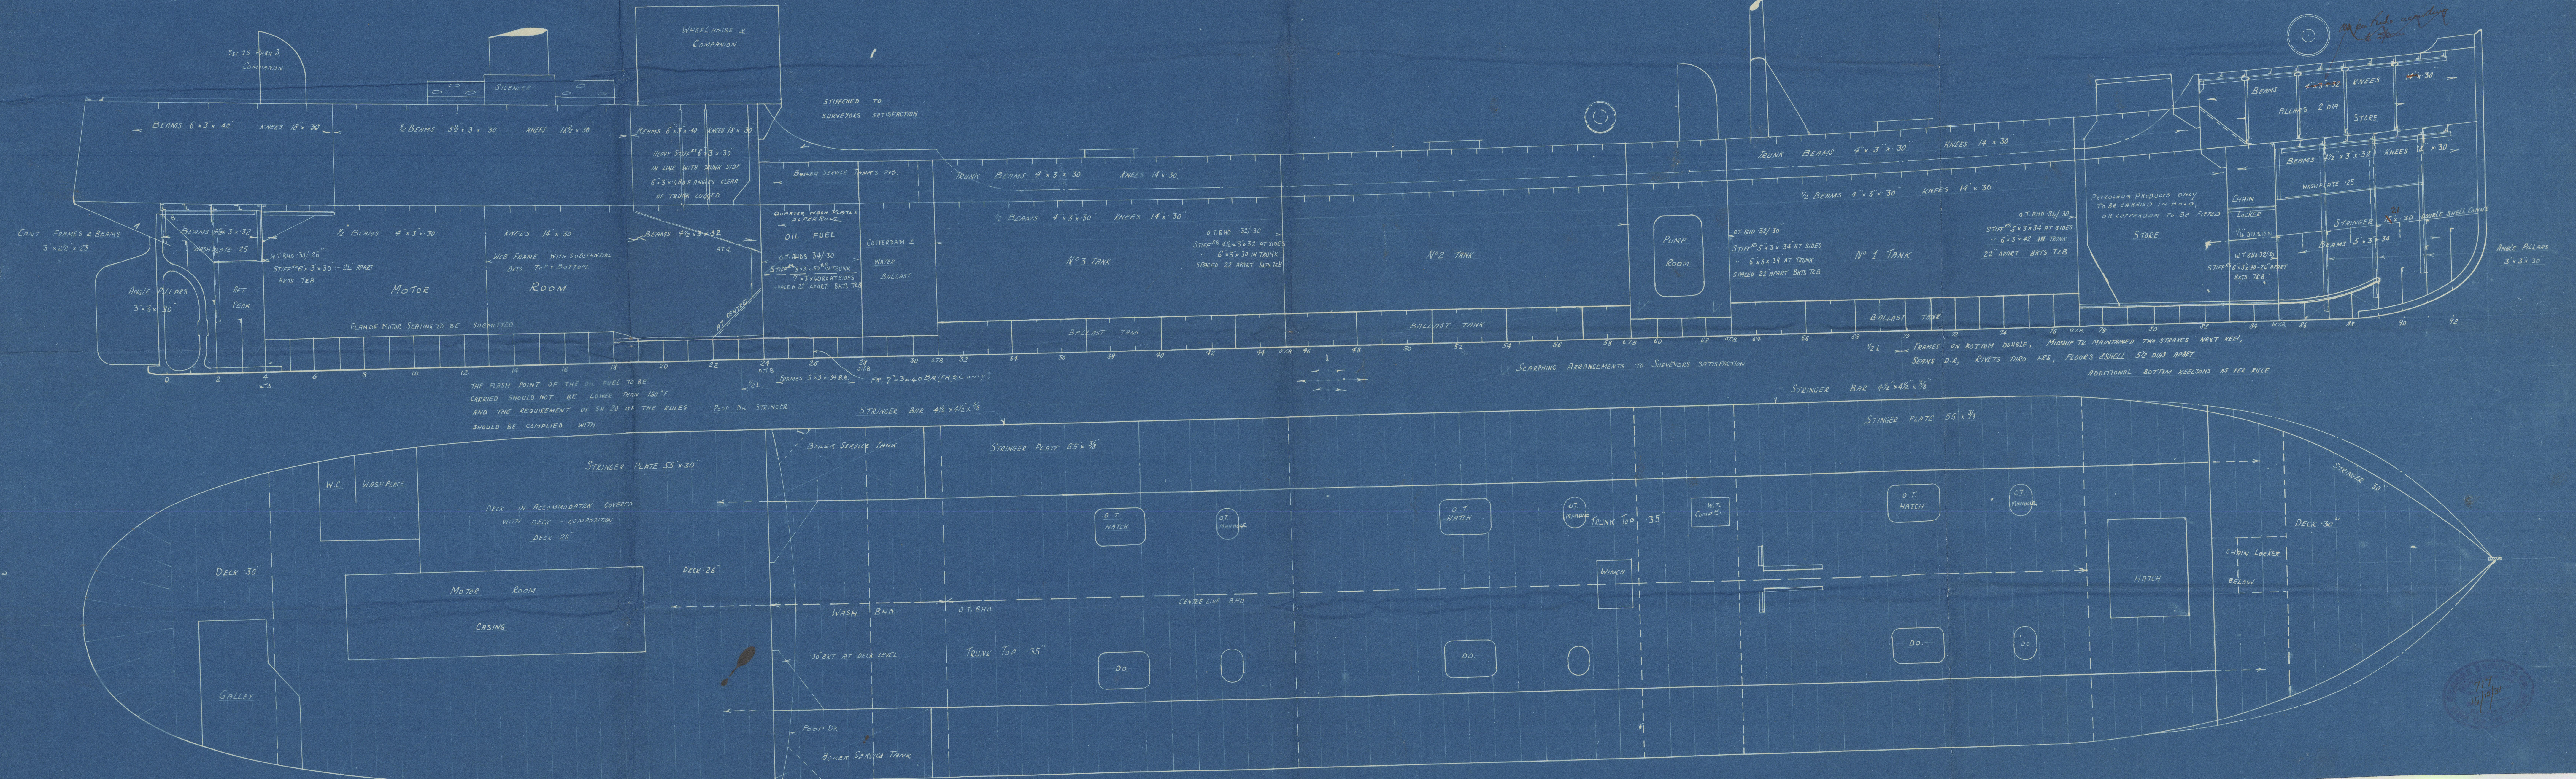

717
15/15/31

MESSRS. G. BROWN & CO'S

Nº 182.

PROFILE & DECK PLAN
(As Built.)

M.V. "Acclivity"

Sub. 1st Entry Refect. 1/1-19370.



© 2020

W1071-0083

Lloyd's Register
Foundation