

24: 10: 05

No 1504 Multitubular Boiler for
Messrs Goole Shipbuilding Co. Ltd. 1885/1901

W. Pressure 130 lbs per sq. inch

Scale 1" = 1 foot

Tested to Lloyds Requirements

Material

all plates, rivets & stays of steel
Tubes & uptake of iron

Shell Riveting



1 1/2" holes 4 3/4" apart



Manhole 14x13 Ring 7x1

Heating Surface

Tubes	993 sq. ft.
Furnaces	128
b.b. chambers	160
Tube Plates	47
Total	1328 sq. ft.

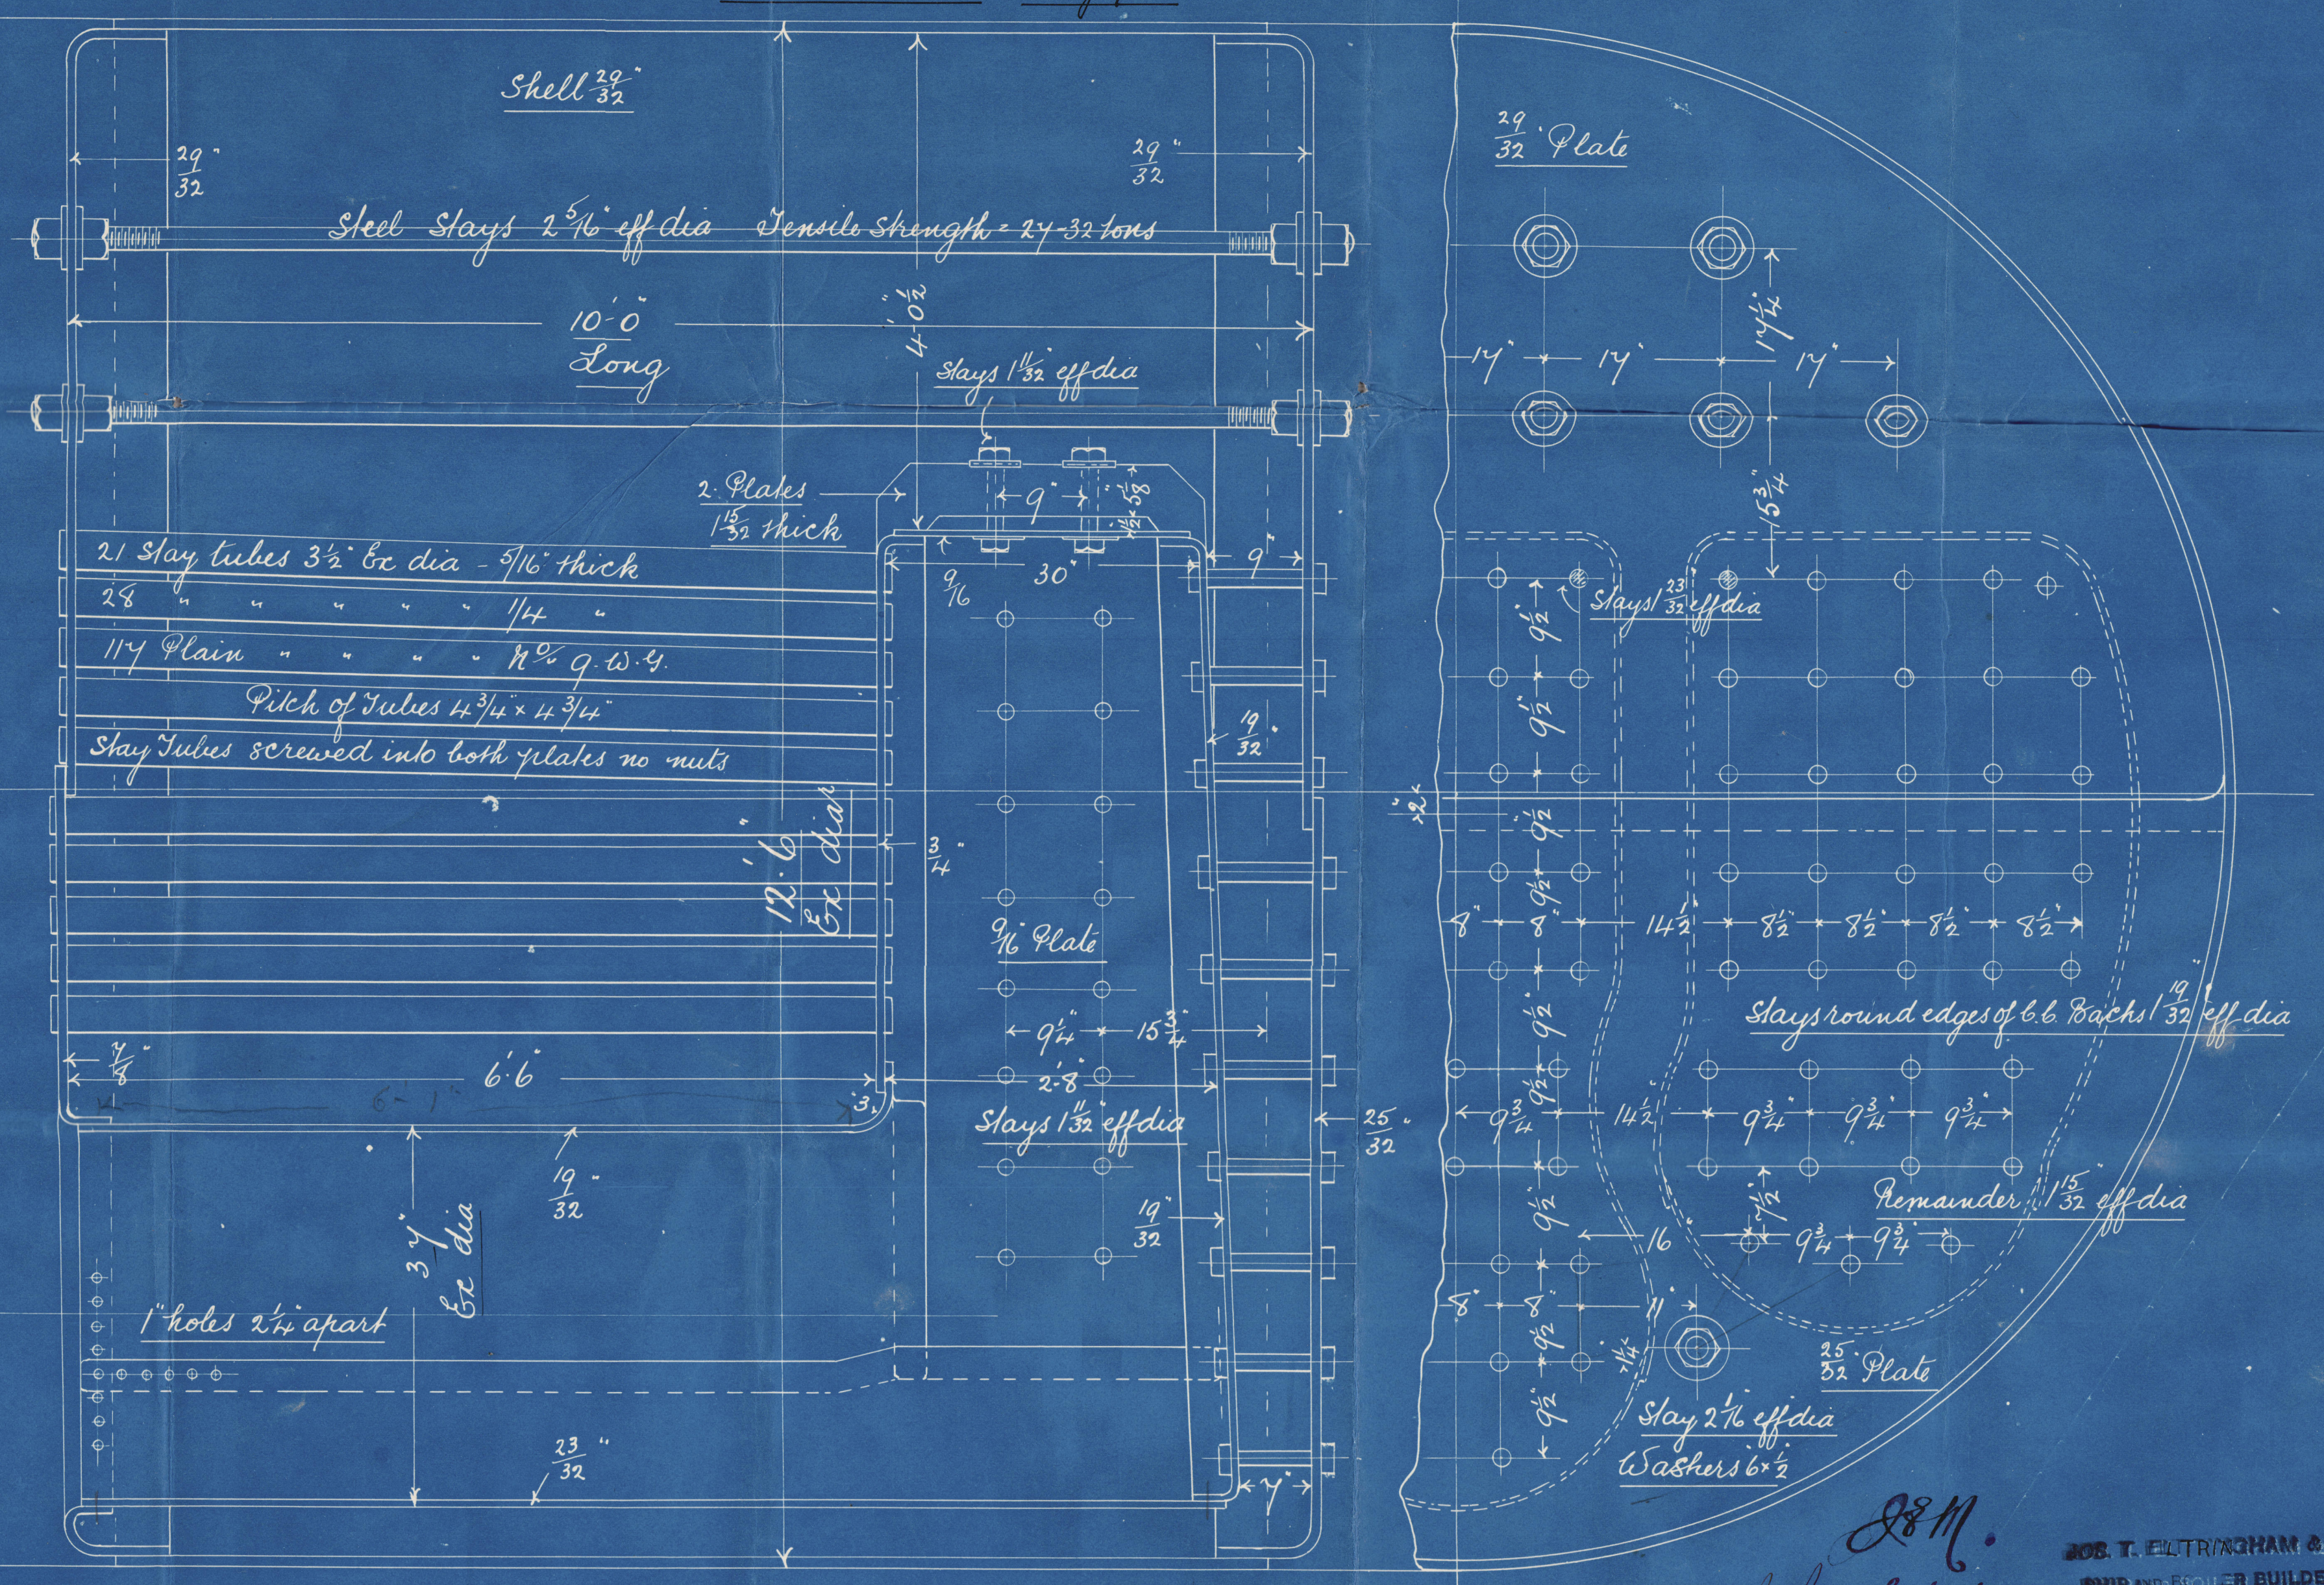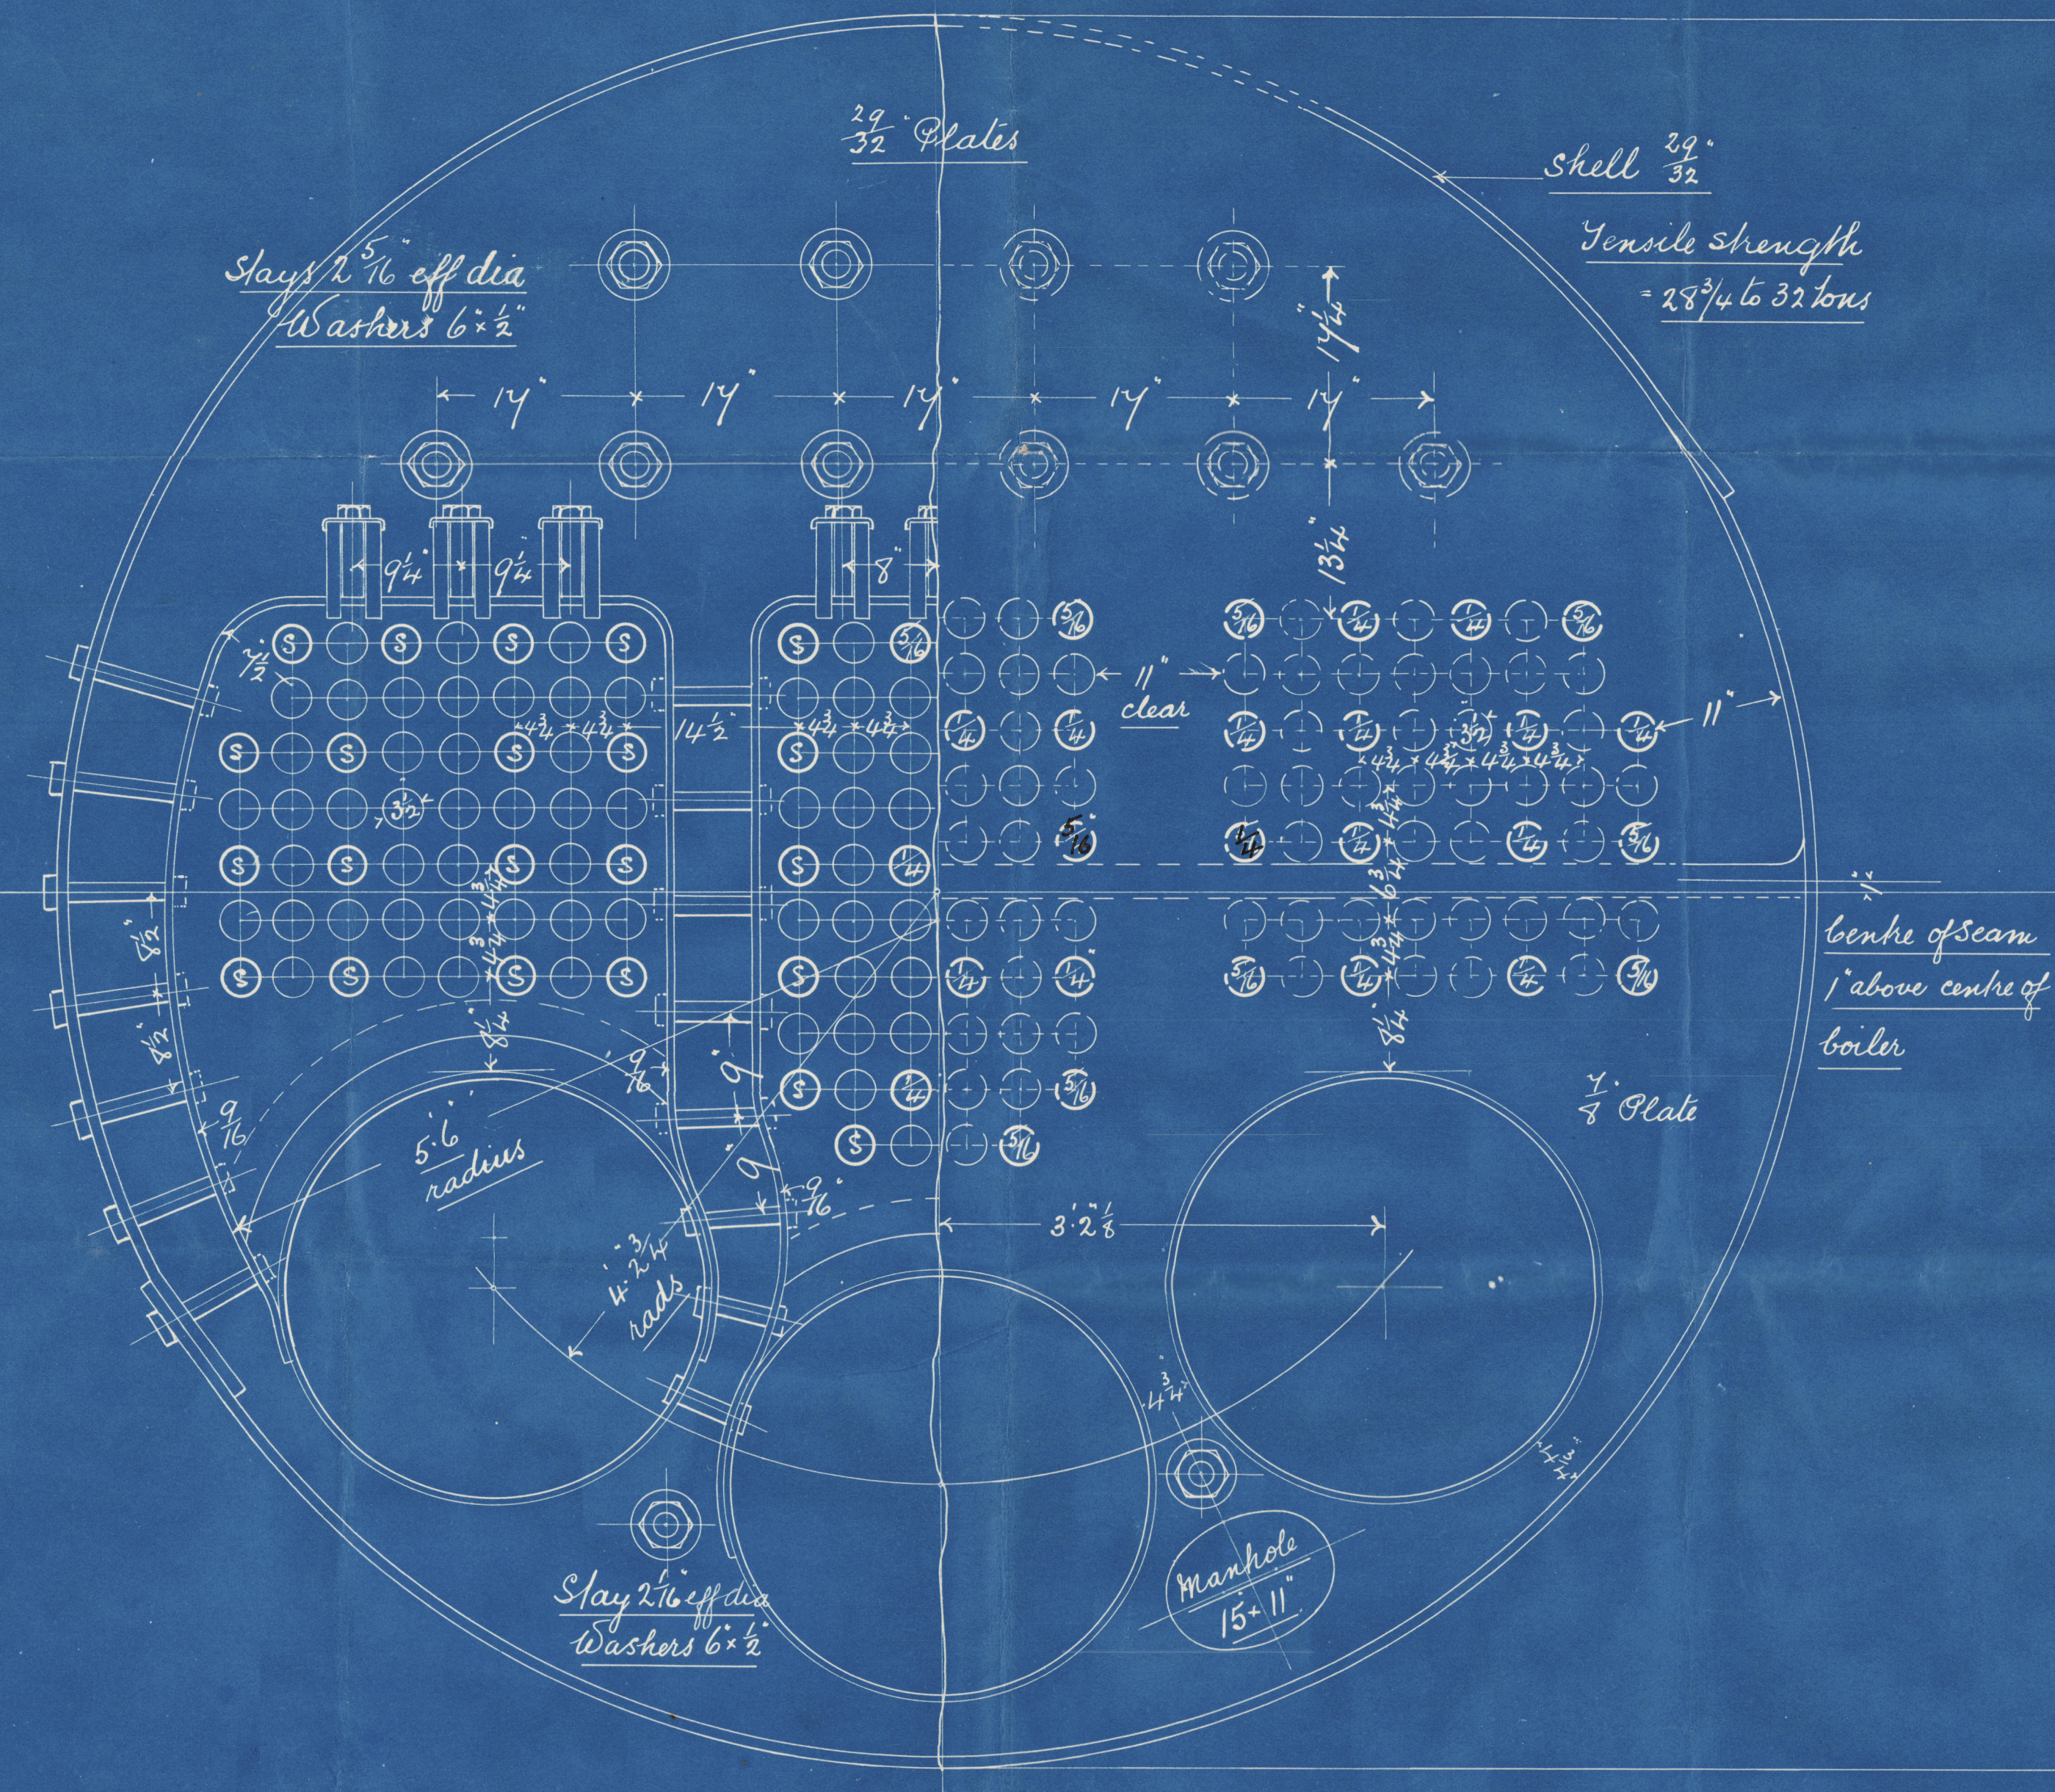

24/10/05
J.S.
24.10.05
J.B.M.
24/10/05
R. T. ELTRINGHAM & CO.,
SHIP AND BOILER BUILDERS,
SOUTH SHIELDS.
DRAWING NO. 941
DATE 20-10-05


W1073-0273

J. J. E. Birmingham & Co.

Boiler No. 1507

Goole Shipbuilding Co. Ltd. P. S. No. 85

W.P. 130 lb

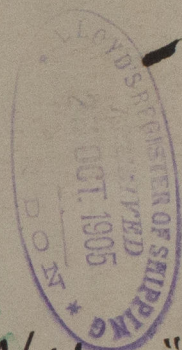

"Miltrop"

Newcastle Report No. 50904

No. 7182.
Lloyd's Test.
260 lbs.
27.2.06
J.E.S.

s/s Liliar


Hull Report No. 18000

Newcastle-on-Tyne

21-10-05

G.A.D.S.

W1073-0273

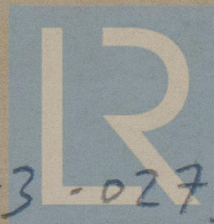

Lloyd's Register
Foundation