


24.11.05
13.1.06

S.S. N° 85.

PROFILE & DECK PLAN

DIMS:- 134'-0" B.P. x 24'-0" x 11'-3" MOULDED.

SCALE 1/4" = 1 FOOT.

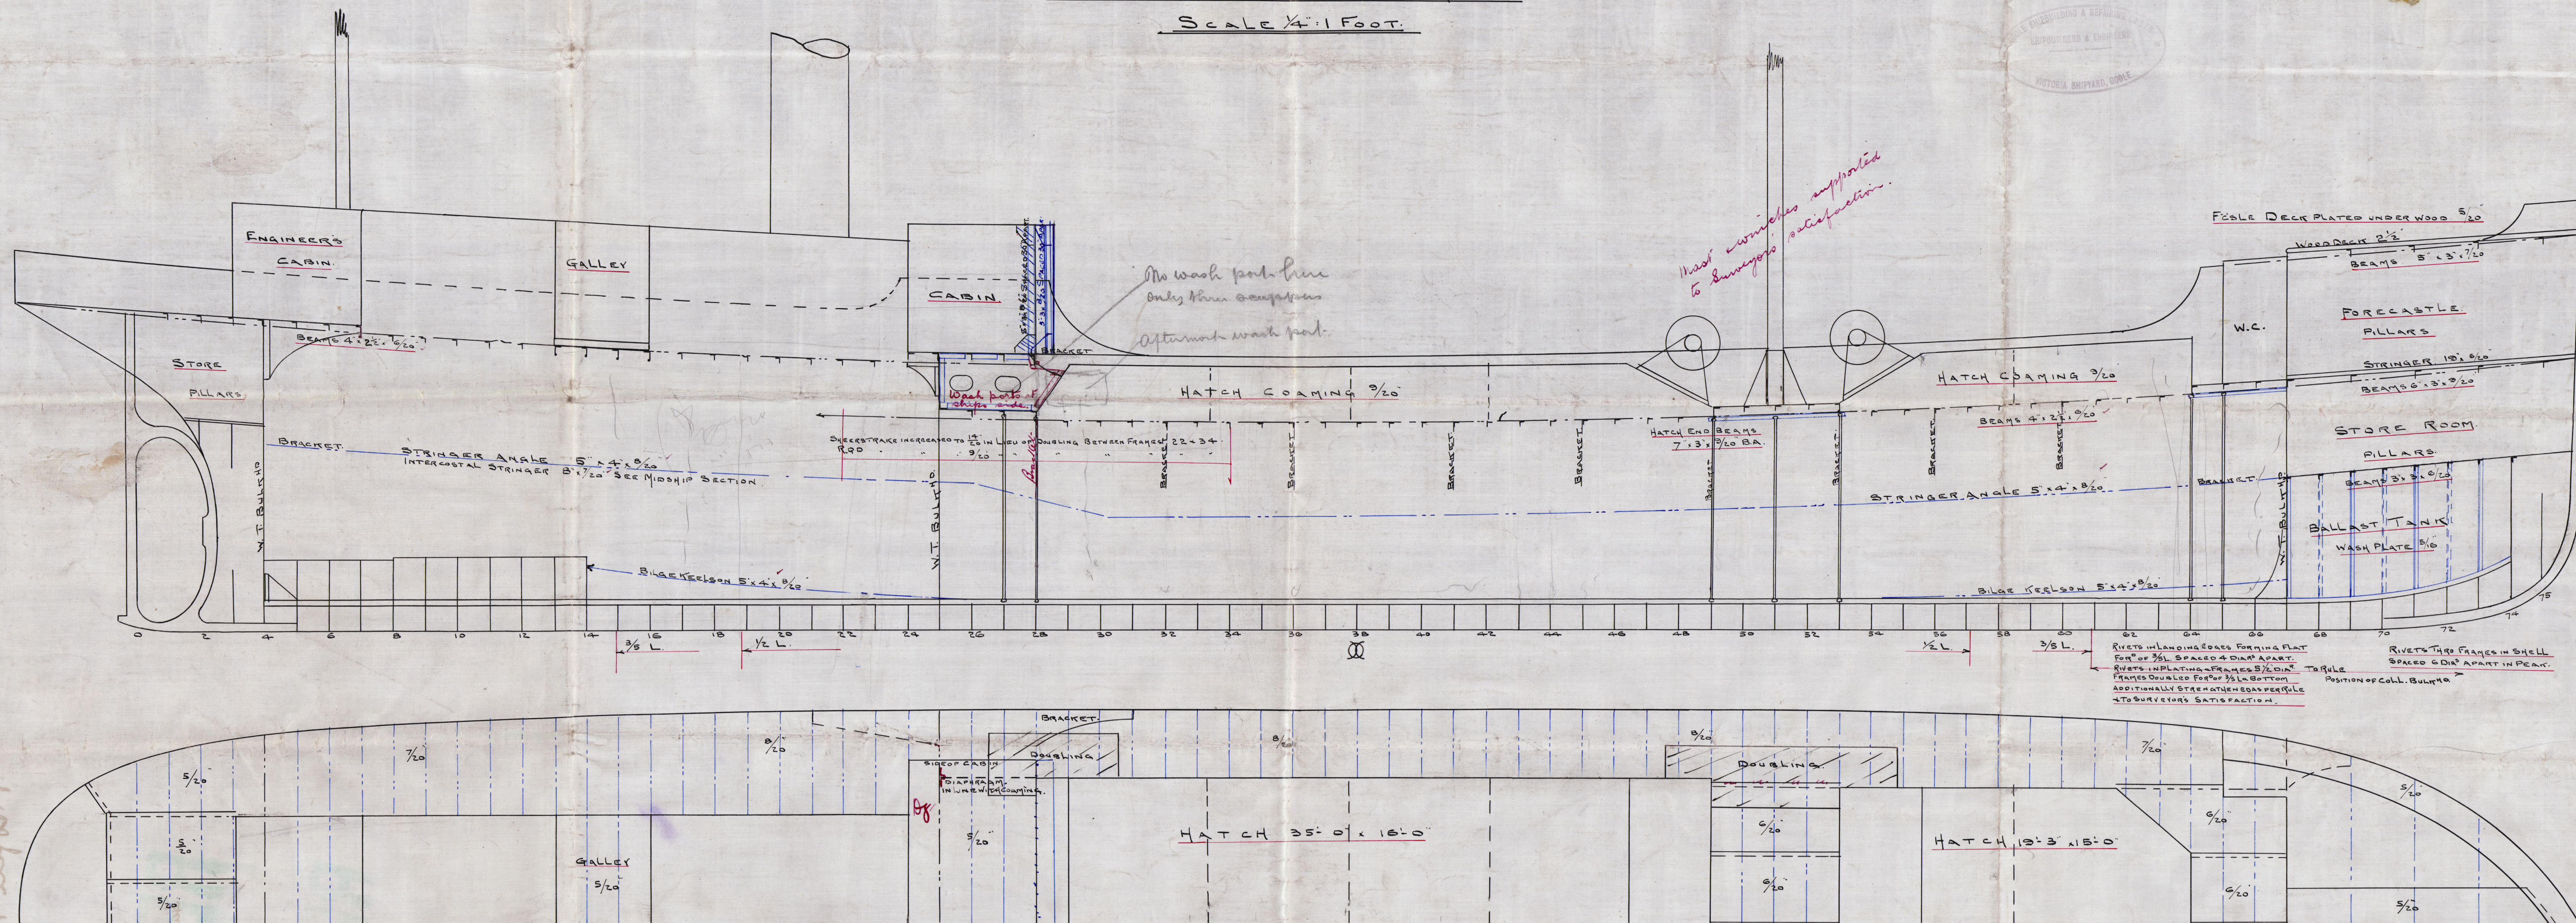

for power 2 x 16 C.S.
11.8.05
Laid down 11.8.05
Laid down 11.8.05
Laid down 11.8.05

C.F.
24/11/05

The Essoe S. & R. Co.
No 85

Amended.
Profile + Deck Plan

"Miltrap"

ex.
% Lilian

Hull Rpt No. 18000



© 2021

W. H. D. Register
Foundation