

Lloyd's Register of British & Foreign Shipping.

 (Report on Vessel No. 18000 Port Hull
s/s Libian)

 No. 410A **SHIP FORGINGS OR CASTINGS.**



I have to report that the undermentioned Iron or Steel Forgings or Castings, manufactured by Messrs. J.S. Foster & Co. Ltd. of Pallim. for the Vessel No. 85, being built by The Goole S.B. Co. of Goole. have been inspected by me as set forth below and found to be, so far as can be seen, Sound.

Mark on Forgings.

Lloyd's
No. 410AF.C.Frank Cook.
Sunderland
26-4-06

	STERN FRAME.	RUDDER FRAME.	STEM.
Material* ...	<u>Scrap.</u>	<u>Scrap.</u>	
How made ...	<u>Forged.</u>	<u>Forged & built</u>	
Dimensions ...	<u>6 1/4 x 3"</u>	<u>4" to 3 1/2" dia</u>	
Progress on Inspection ...	<u>Forged & smithed.</u>	<u>Forged & machined</u>	
Date when Inspected {	<u>11/12/05 to 4/1/06.</u>	<u>21/2/06 to 30/3/06.</u>	

SKETCHES OF FRAMES SHOWING POSITION AND DESCRIPTION OF WELDS OF FORGINGS, OR PARTICULARS OF TESTS APPLIED TO CASTINGS.

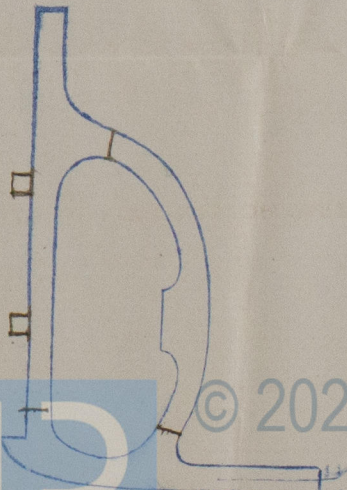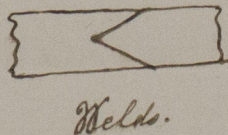

Fee (if any chargeable) £ : :

To be paid at

* If of Iron, state whether scrap or puddled Iron.