7'-4¾" OVERALL LENGTH OF LINER

6'-8" OVERALL LENGTH OF STERN TUBE

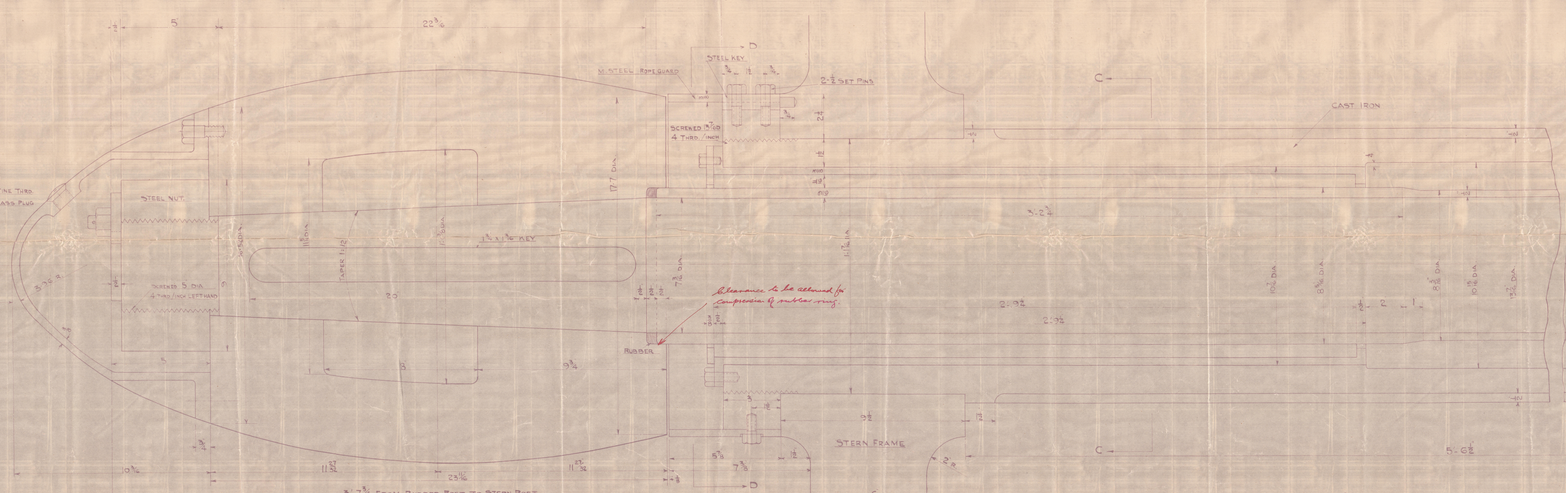

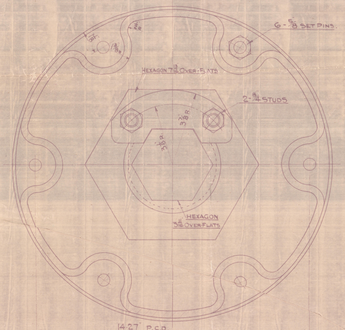

VIEW ON PROPELLER NUT WITH CONE REMOVED

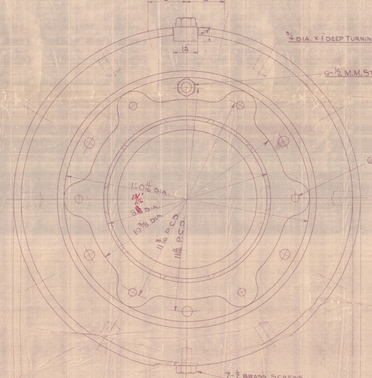

SECTION D D

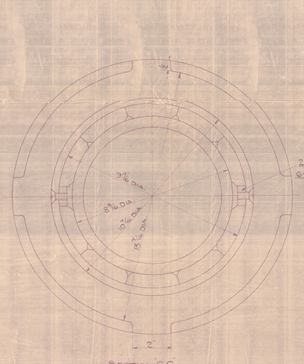

SECTION C C

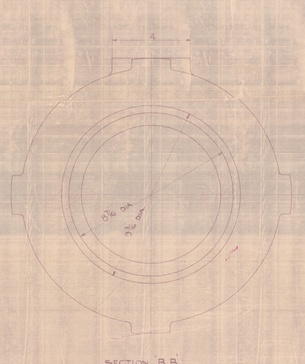

SECTION B B

SECTION A A

SHIP Nº 782 ENG. Nº 506

Messrs The Hong Kong & Whampoa Dock Co

STERN TUBE & TAIL SHAFT for Yard Nº 142

Motorship Suniwa

SCALE HALF SIZE

Plan of Stern tube & Shafting

APPROVED

H. K. & W. DOCK CO. LTD.

DRAWING OFFICE

14 OCT. 37

R. L. Burdess

Noted R.M. 23-11-37

HULL DOCK XXXXX

DRAWING Nº 1687

6-37

RETD
RETD