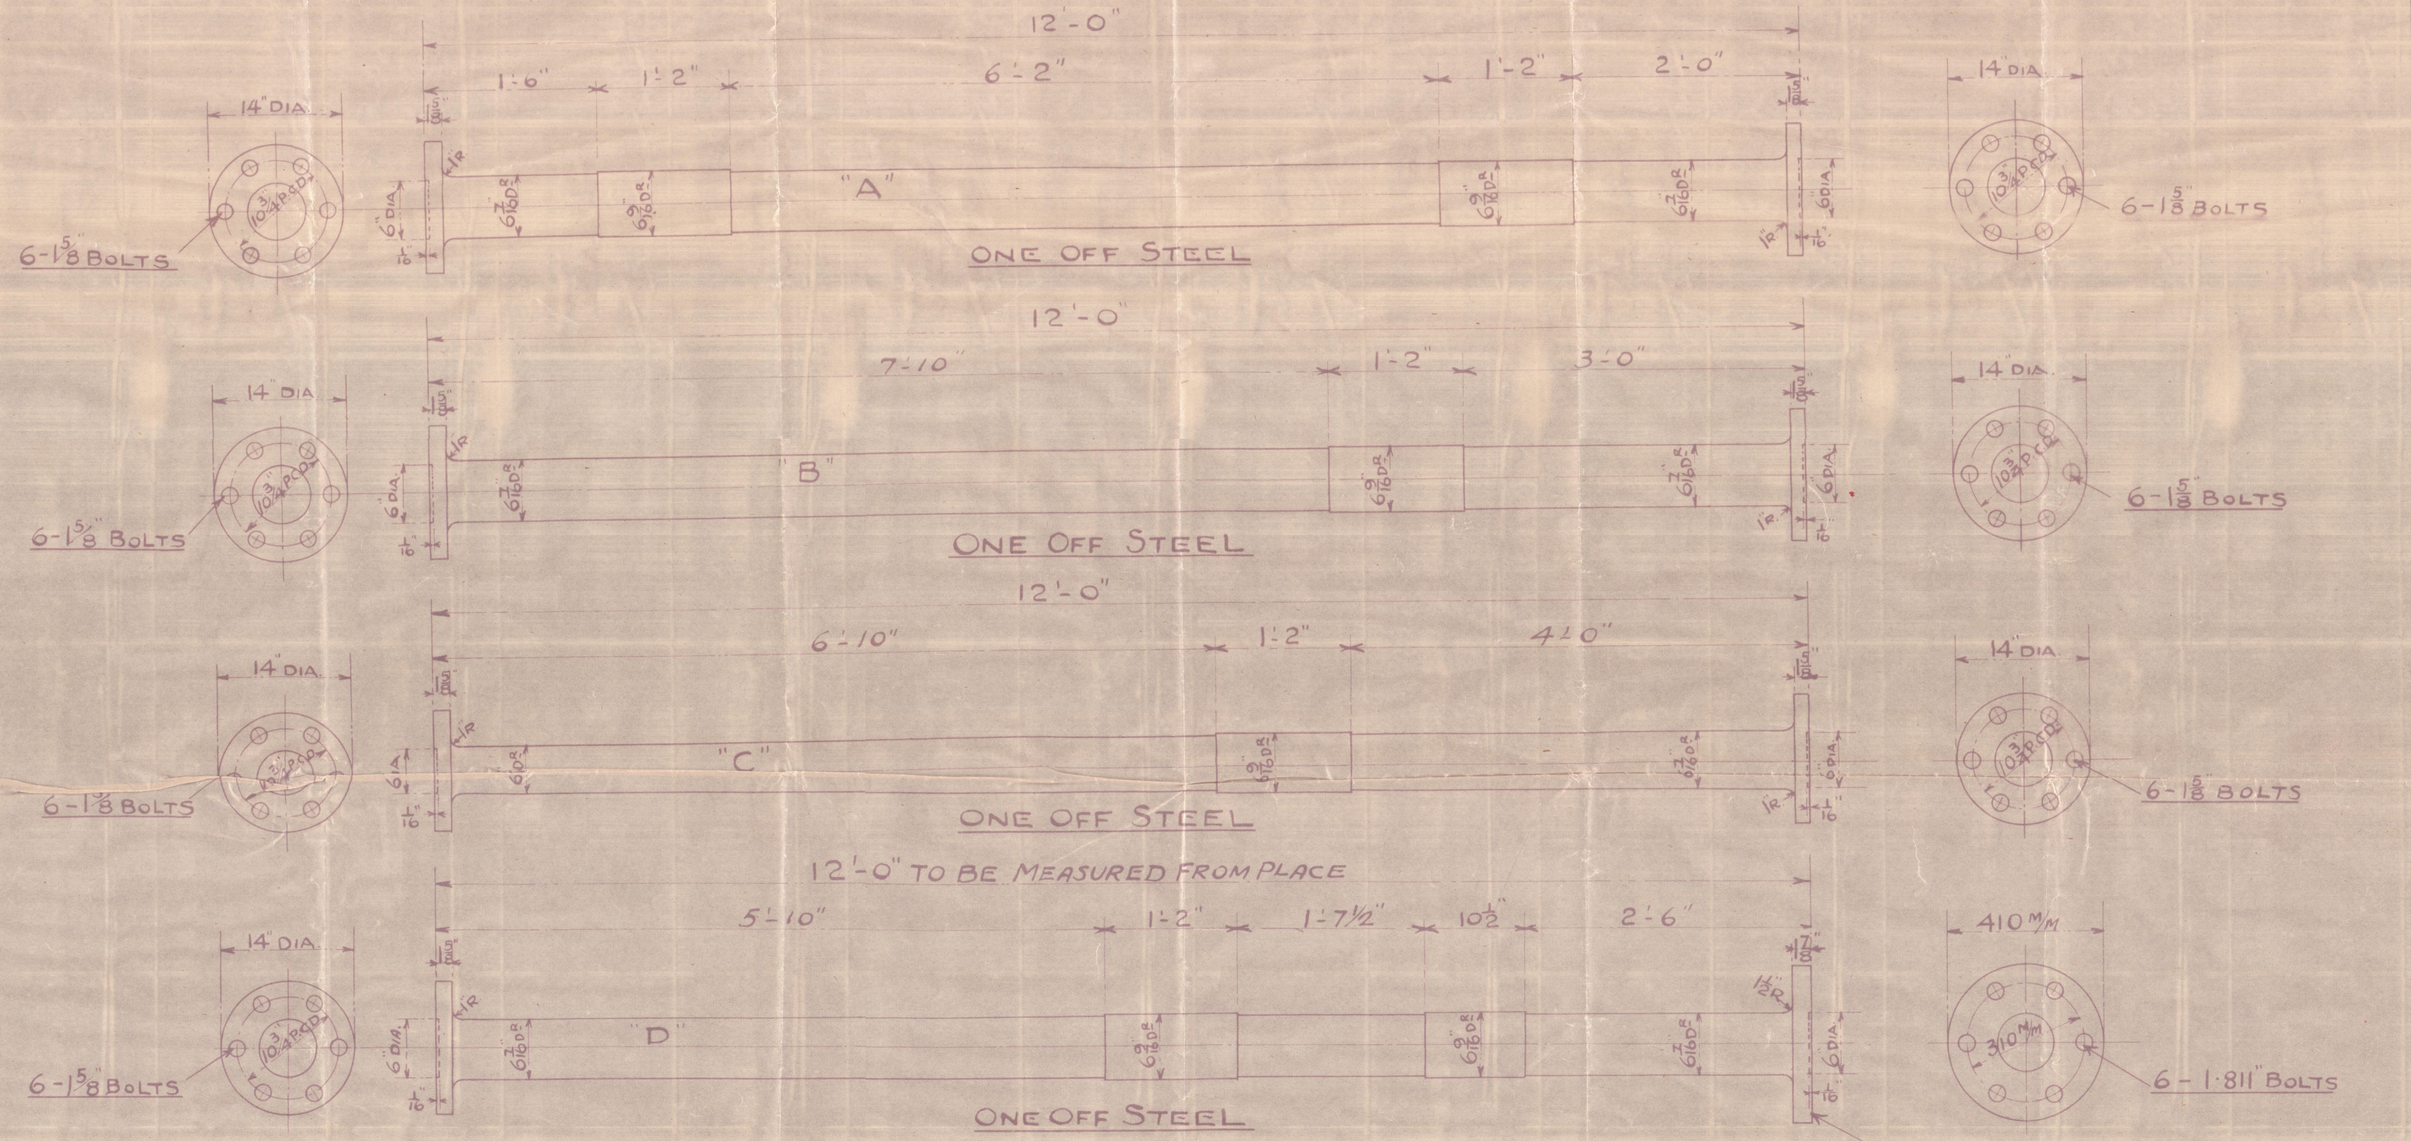

FORGED MILD STEEL

SCALE :- 1"=1FOOT

JOB No. 155 ENG. No

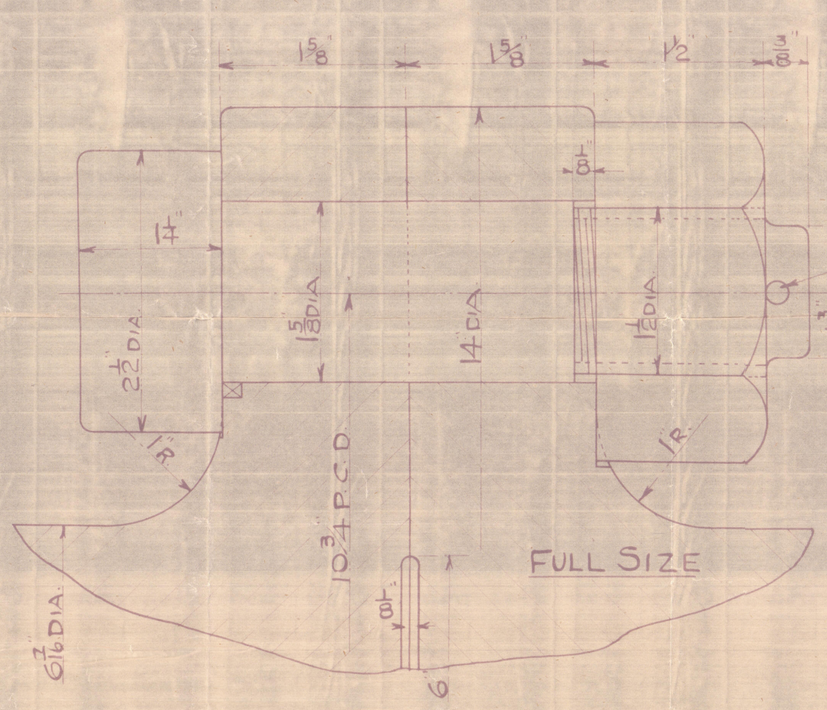

OFF TOTAL { 24 OFF WORKING - STEEL
6 OFF SPARE - " JOB No. 192 ENG No

MAIN ENG THRUST SHAFT COUPLING BOLTS

6 OFF STEEL

APPROVED

LLOYD'S REGISTER OF SHIPPING A.K. OCT 25 1937 e. Macpherson KOBE

Robert R.M. 23-11-37

H. K. & W. DOCK CO., LTD.
ENGINE DRAWING OFFICE
DATE 14 OCT. 1937
R. L. Barker

Plan of Intermediate Shafting

SHIP No. 782 ENG. No. 506

INTERMEDIATE SHAFTING

SCALE AS MARKED

H K & W DOCK C° L^TD

DRAWING No. 17725

9-11-37

RETAIN

© 2020 Lloyd's Register Foundation

W1075-0152