



SHIP NO 782
 PROFILE & DECK PLAN.
 STEEL SINGLE SCREW MOTOR VESSEL.

TO CLASS 100 A.I. LLOYDS (COASTING SERVICE PHILIPINE ISLANDS)
 FOR BULKHEADS SEE SEPARATE PLAN.


DIMENSIONS

LENGTH O.A.	178'-0"
LENGTH B.P.	170'-0"
BREADTH MLD	29'-9"
BREADTH SHADE DECK	31'-9"
BREADTH BRIDGE DECK	33'-3"
DEPTH MLD	12'-7"


SCALE 1/8" = 1 FOOT.

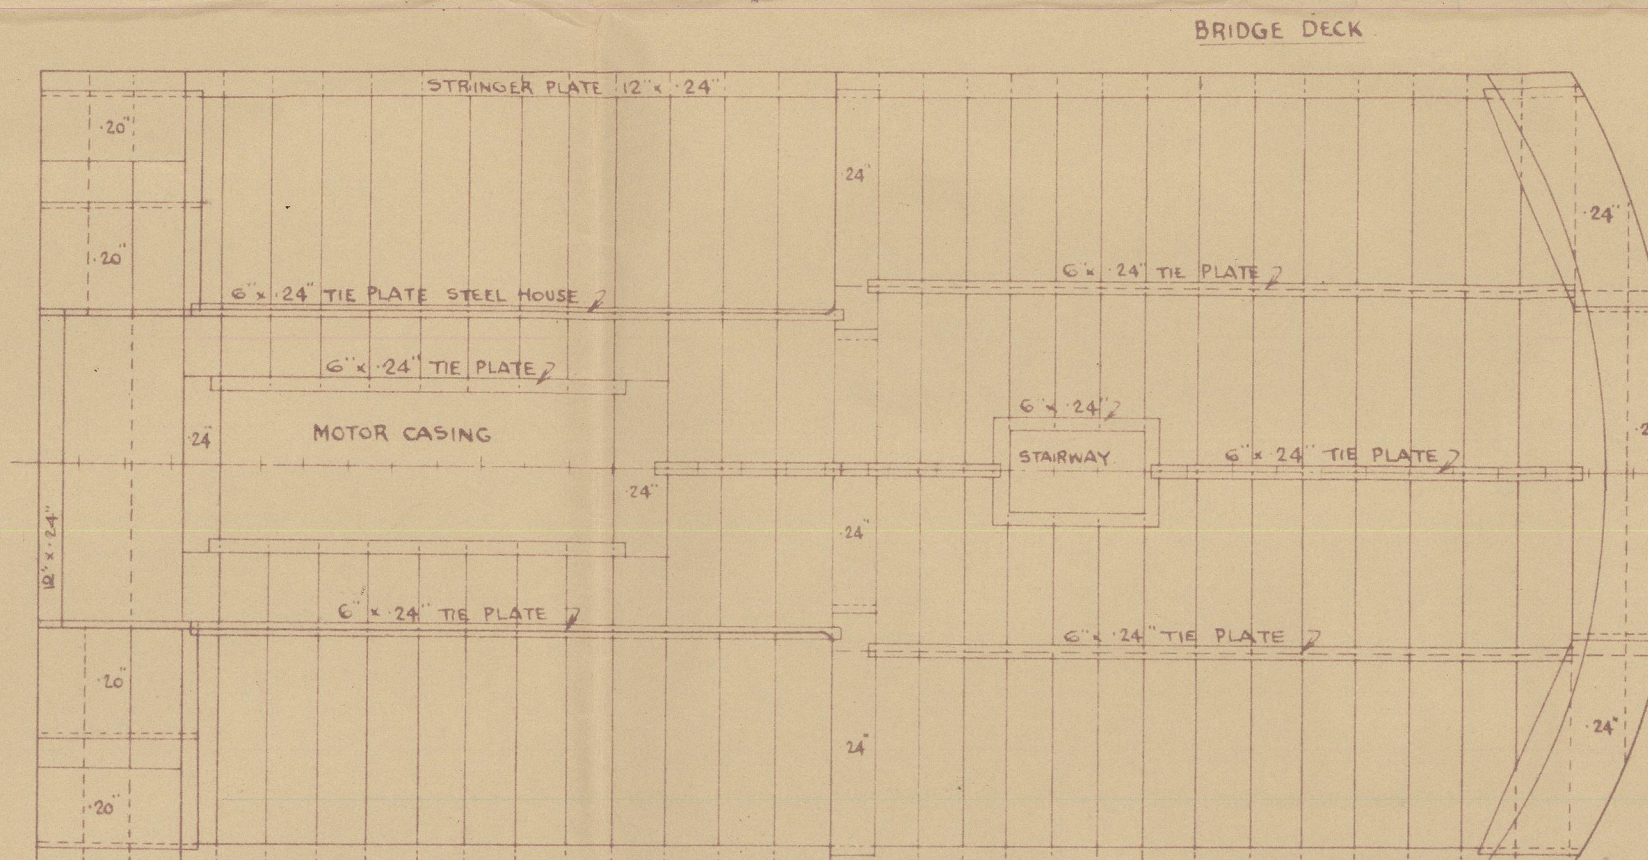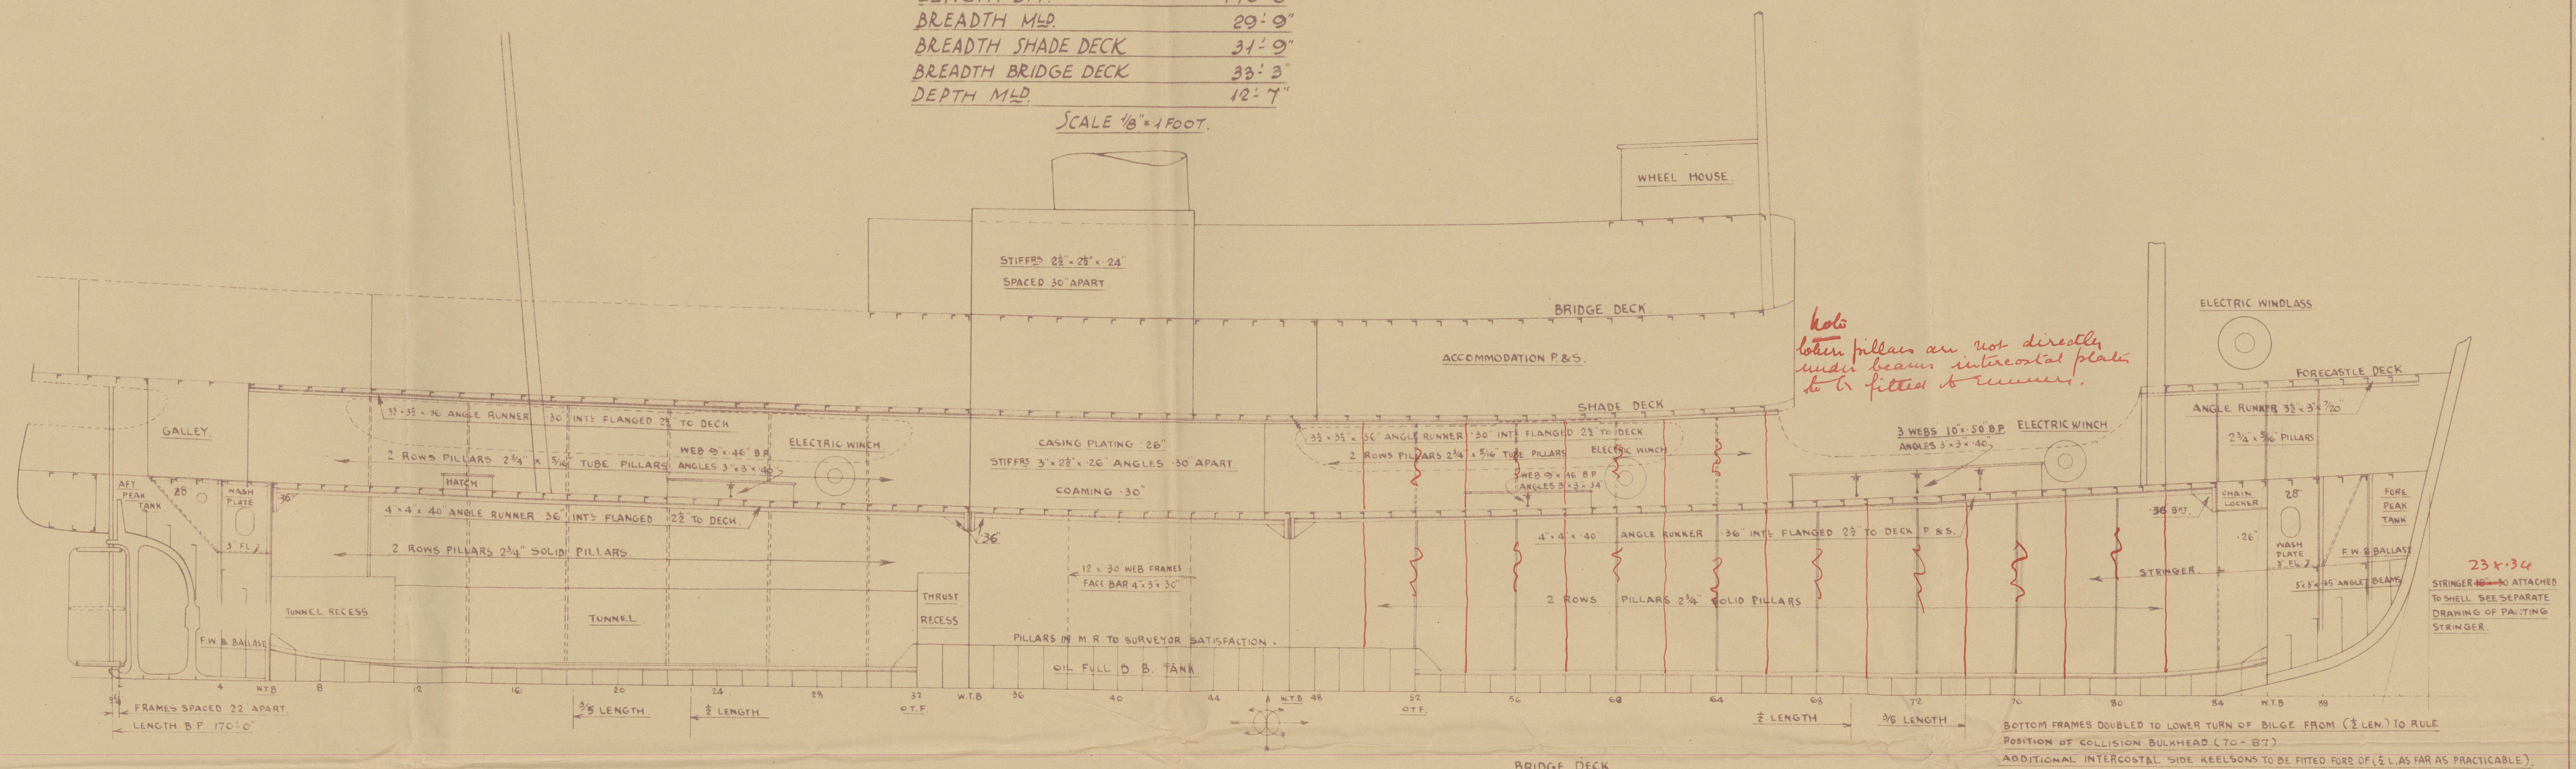

ALL BRIDGE DECK BEAMS 3" x 24" x 26" ANGLES SPACED ABOUT 27" APART.

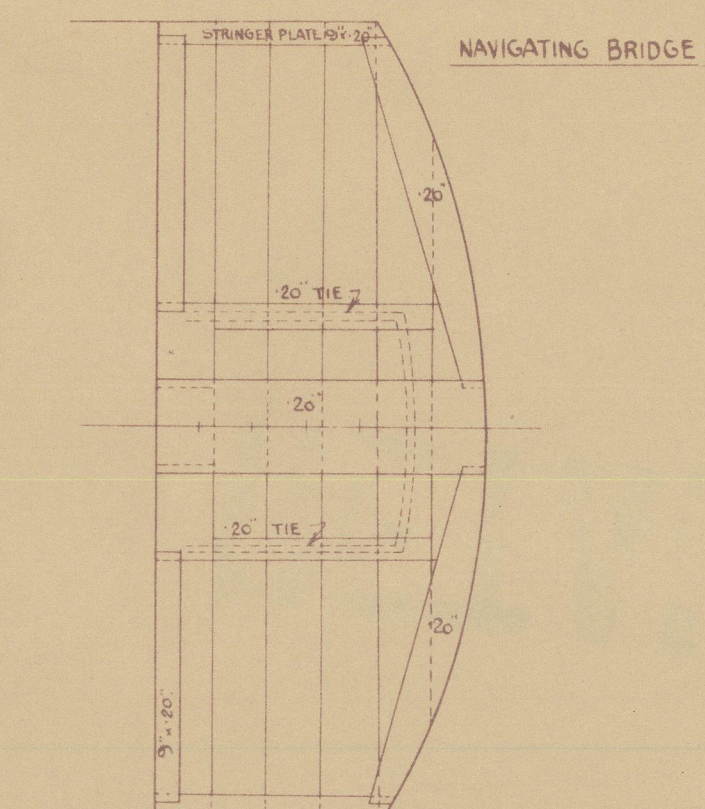


NAVIGATING BRIDGE 2 1/2" x 24" ANGLES SPACED ABOUT 27" APART.

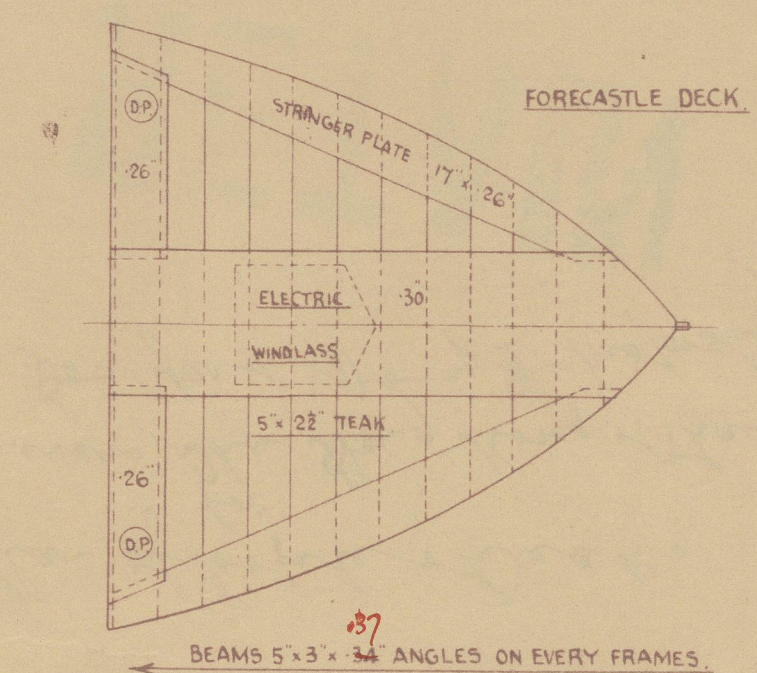


BEAMS 5" x 3" x 34" ANGLES ON EVERY FRAMES.

SHADE DECK

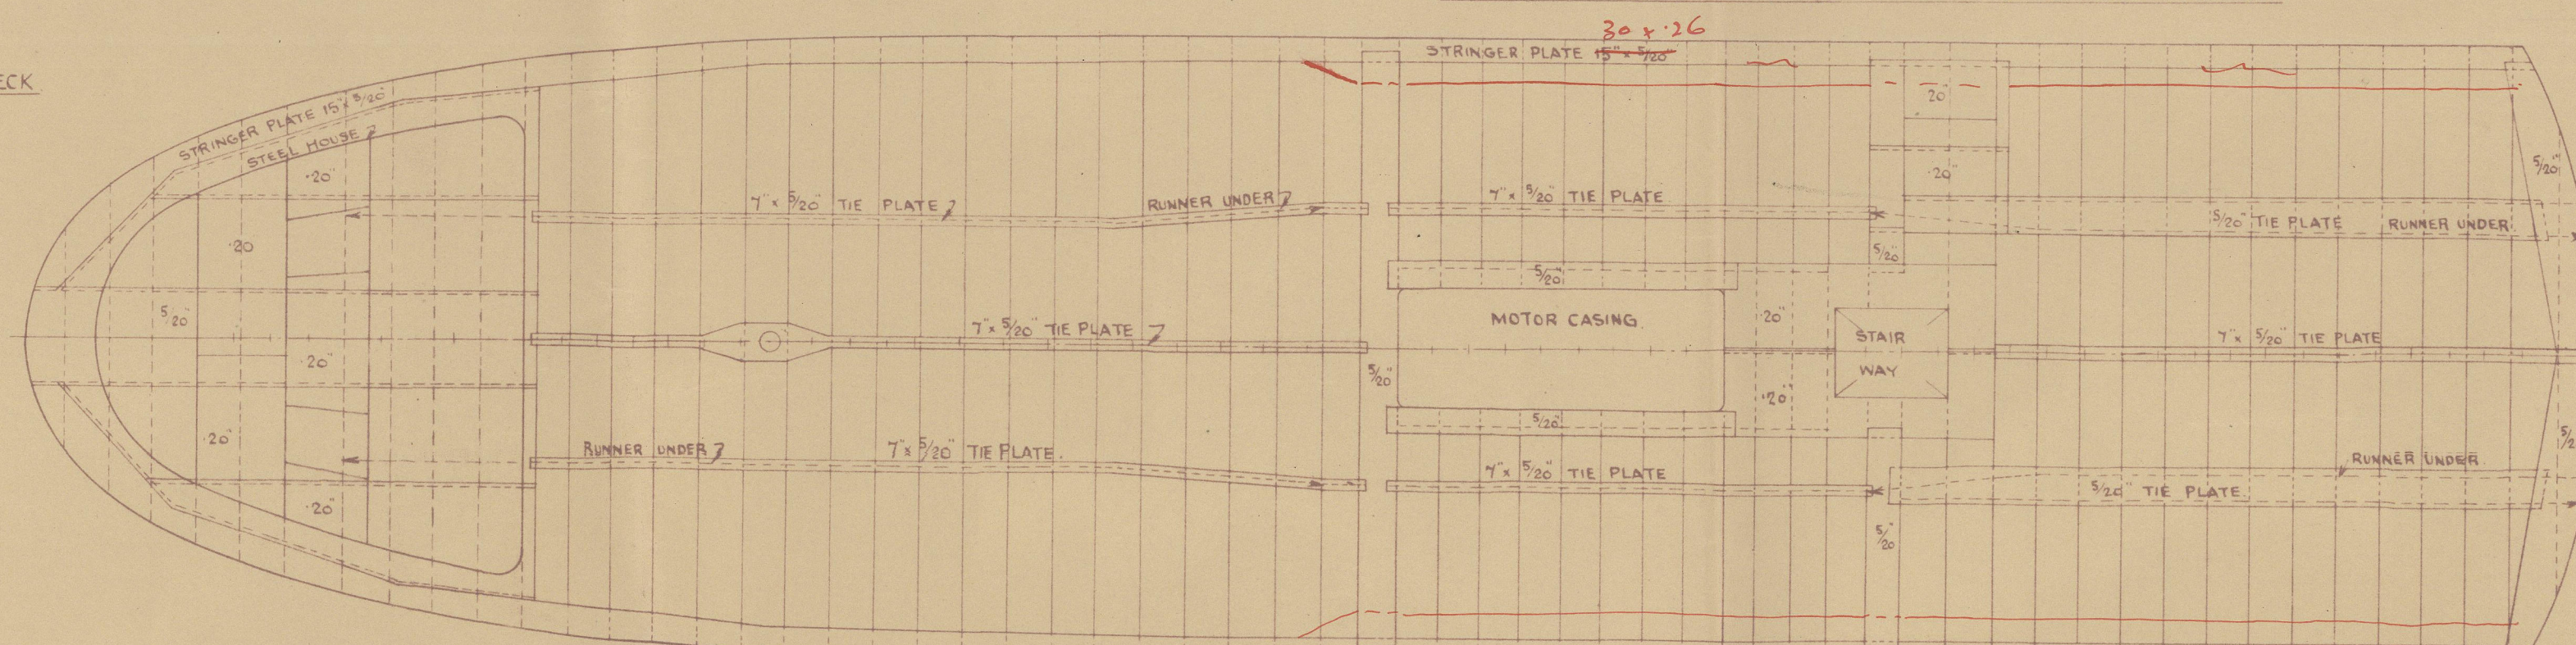

ALL SHADE DECK BEAMS 3 1/2" x 28" x 30" ANGLES SPACED ABOUT 27" APART.


UPPER DECK

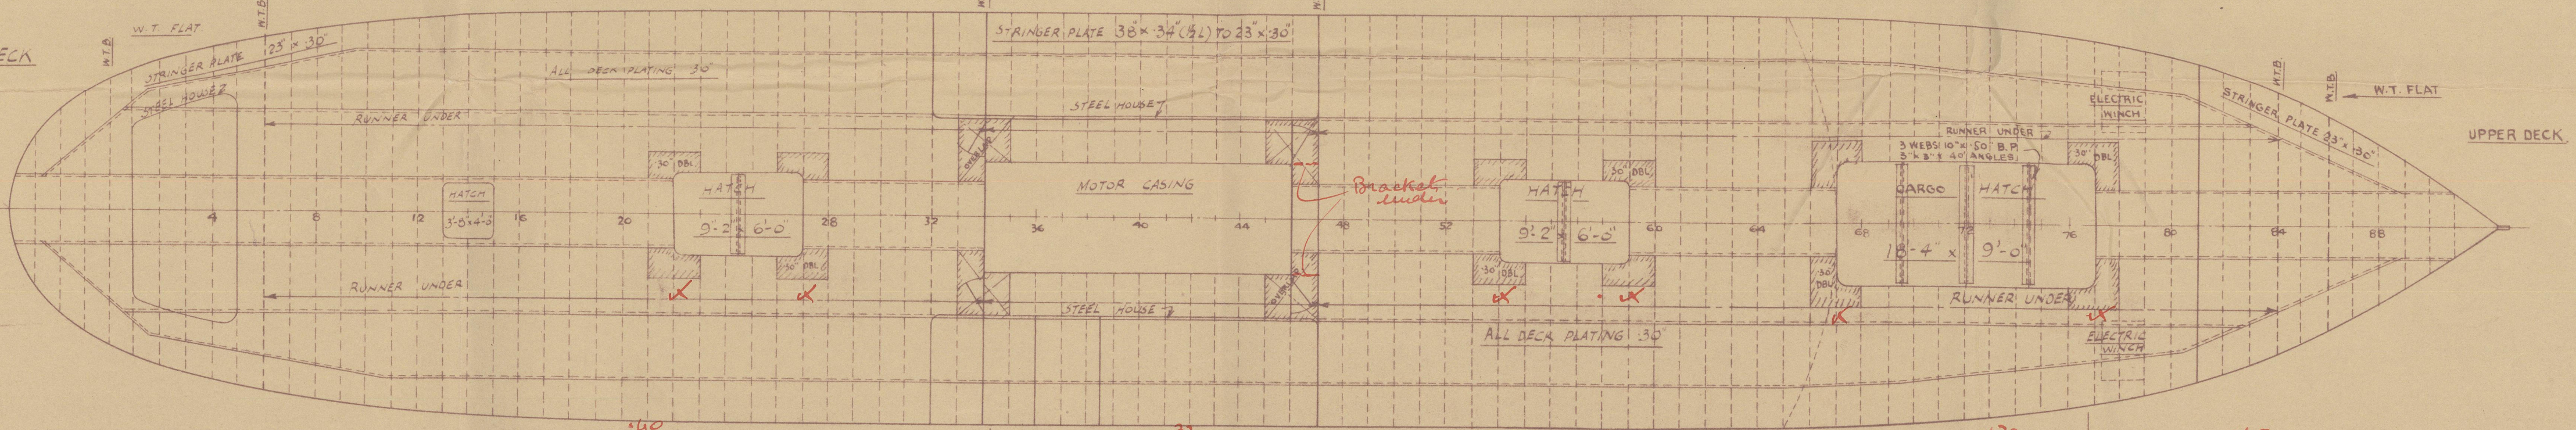

BEAMS 5" x 3" x 40" ANGLES ON EVERY FRG. HALF BEAMS 4" x 3" x 30" ANGLES OIL FUEL DOUBLE BOTTOM TANK BEAMS 5" x 3" x 40" ANGLES ON EVERY FRAMES HALF BEAMS 4" x 3" x 30" ANGLES BEAMS 5" x 3" x 40" ANGLES ON EVERY FRG.

note 3" x 3" x 40" Rec Angl to be fitted to all Hatch End Beams.

HOLD

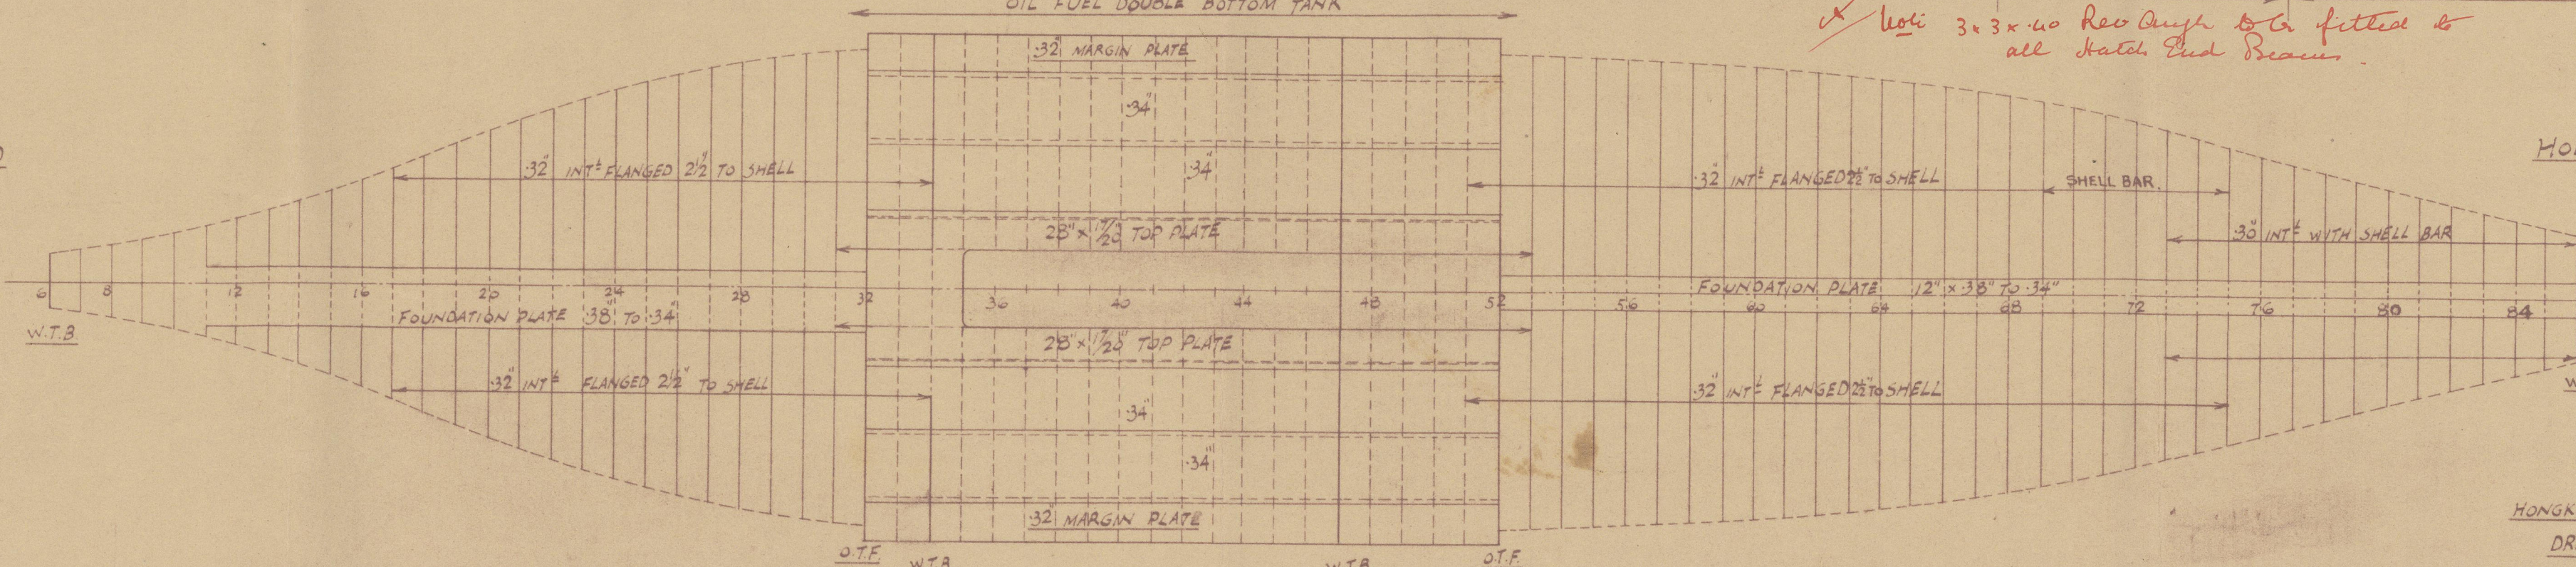

HOLD

APPROVED
 LLOYD'S REGISTER OF SHIPPING
 KOBE

HONGKONG & WHAMPOA DOCK CO. LTD.
 25/3/37
 3-37

HONGKONG & WHAMPOA DOCK CO. LTD.
 DRAWING NO. 308
 3-37

1872
286 x 4

Plan of Profile & Decks
for
Messrs The Hong Kong & Whampoa Dryd
Dock Yard No 182 - motorship "Sungao"

RETAIN

RETAIN



© 2020

Lloyd's Register
Foundation

W1075-0154