

J. L. Thompson
Adm.




No. 314

Medship section.
(amended)

S. S. Rossetti.



S. S. Rossetti

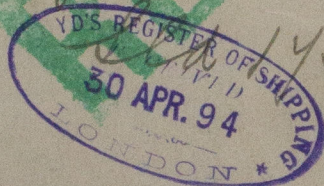

No. 319

H. J. Thompson.



W1076-0044



© 2019

Lloyd's Register
Foundation