

S. S. N<sup>o</sup> 314.

JOSEPH L. THOMPSON & SONS  
IRON & STEEL SHIPBUILDERS  
NORTH SANDS.  
SUNDERLAND.


314.



*Profile*  
S.S. 314  
3



J. L. Thompson Ham.

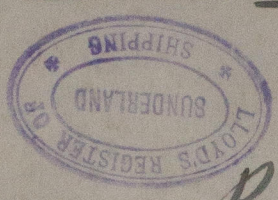


No. 314.

*Profile.*  
*(amended)*

S.S. Rossetti.

SUNDERLAND

14503

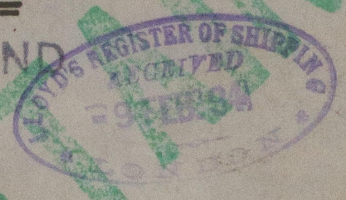

RECEIVED



S.S. "Jennyson".

No. 319.

SUNDERLAND

14615

RECEIVED

