
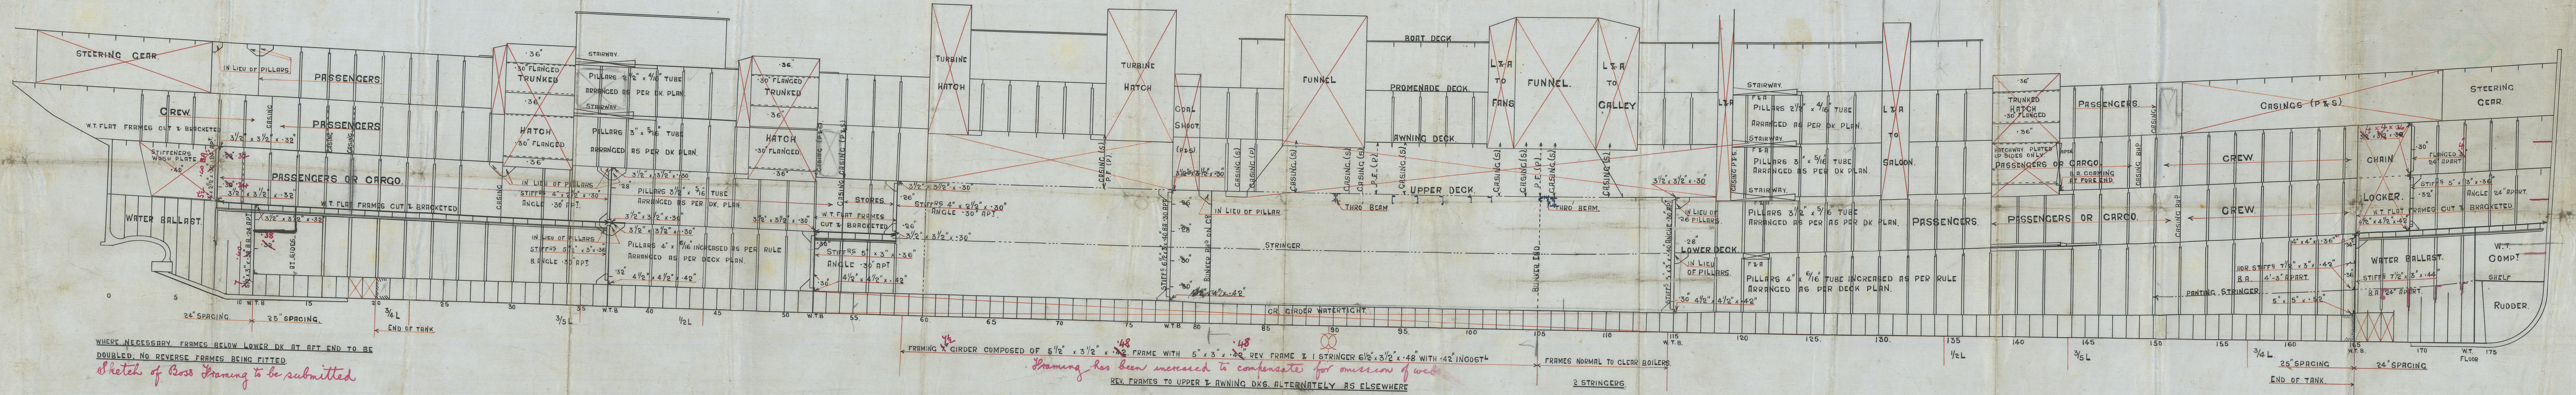


28.12.11
 6.1.12
 15.1.12
 2.2.12
 21.2.12
 12.3.12
 2.5.12
 23.5.12

PROFILE.
 TURBINE STEAMER No 971.
 374'-0" BP x 52'-0" x 19'-6" M^{LD} TO UPPER DK.
 TO CLASS 100 R.I. RUNNING DK WITH FREEBOARD.
 SCALE 1/8" = ONE FOOT.

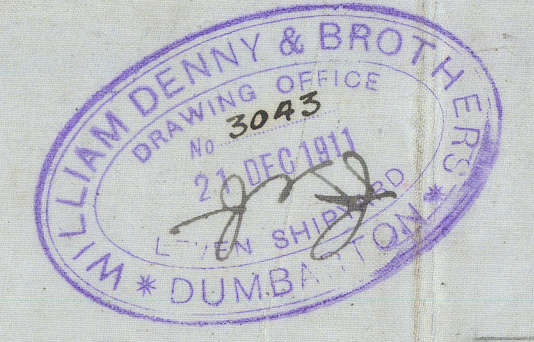

WHERE NECESSARY FRAMES BELOW LOWER DK AT AFT END TO BE
 DOUBLED. NO REVERSE FRAMES BEING FITTED.
 Sketch of Boss Framing to be submitted

FRAMING GIRDER COMPOSED OF 5 1/2" x 3 1/2" x 1/8" FRAME WITH 5" x 3" x 1/8" REV. FRAME & 1 STRINGER 6 1/2" x 3 1/2" x 1/8" WITH 42" NO. 67 L
 Framing has been increased to compensate for omission of web
 REV. FRAMES TO UPPER & RUNNING DKS. ALTERNATELY AS ELSEWHERE
 2 STRINGERS


C.F.
 28/12/11

Profile

Messrs W Dennis & Bann

3. S.S. No 971 "Wahine"

GLASGOW REPORT No. 32646

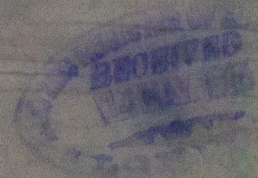

© 2019

Lloyd's Register
Foundation