


Nozzle to be faced across
& holes for gauge connections
to be drilled after Nozzle
is riveted in place

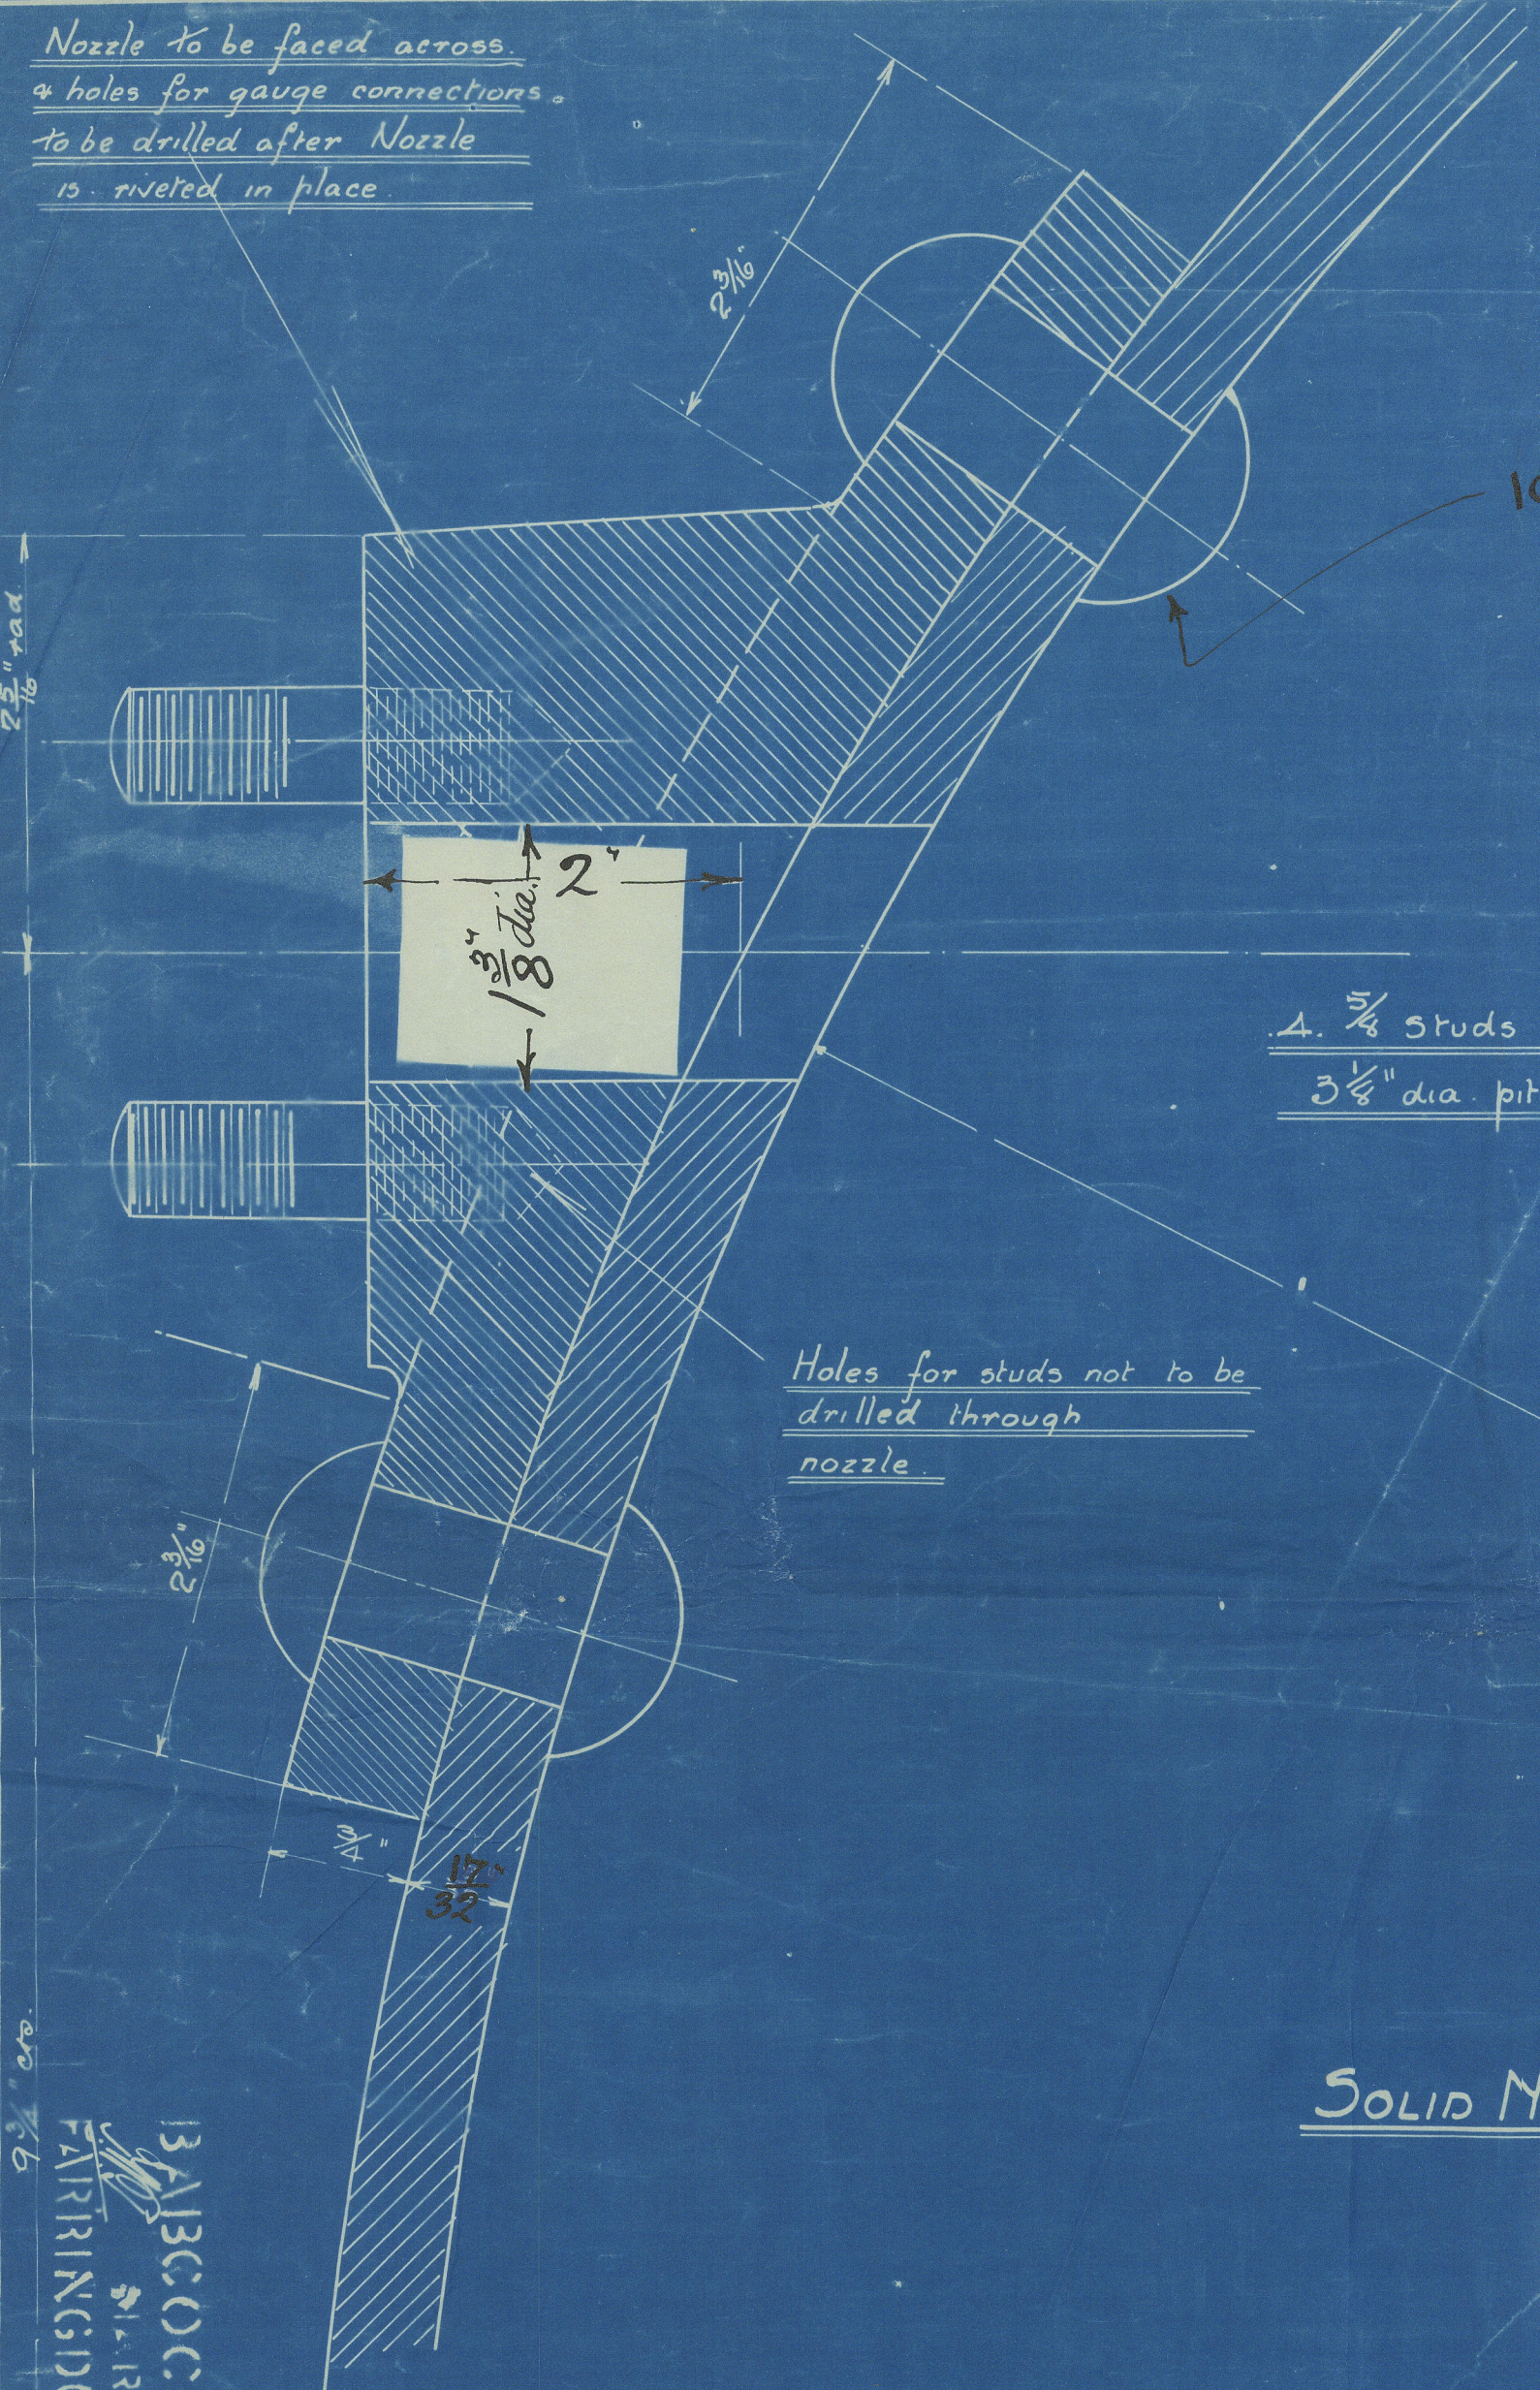

SOLID NOZZLES FOR WATER GAUGES

4 OFF THUS PER BOILER.
8 BOILERS

MARINE DEPT
FARRINGDON ST LONDON E.C.

Centre line of steam drum

Note
For correct position
of these nozzles on
drum shell, see
drawing No. 111/12




SOLID NOZZLES FOR FEED CHECK VALVES

2 OFF PER BOILER
8 BOILERS

R 113

JOB No M.196.
DE No 2259 25
DATE 21-12-11.

E910-9601M

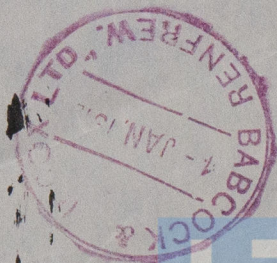

© 2019

Lloyd's Register
Foundation