



13.12.19

S.S. No 220.  
 PROFILE & DECK PLAN.  
 DIMENSIONS 165'-0" B.P. x 26'-10 1/2" MLD x 13'-0" MLD.  
 SCALE 1/8" = 1 FOOT.  
 CLASS: LLOYDS 100A.1.

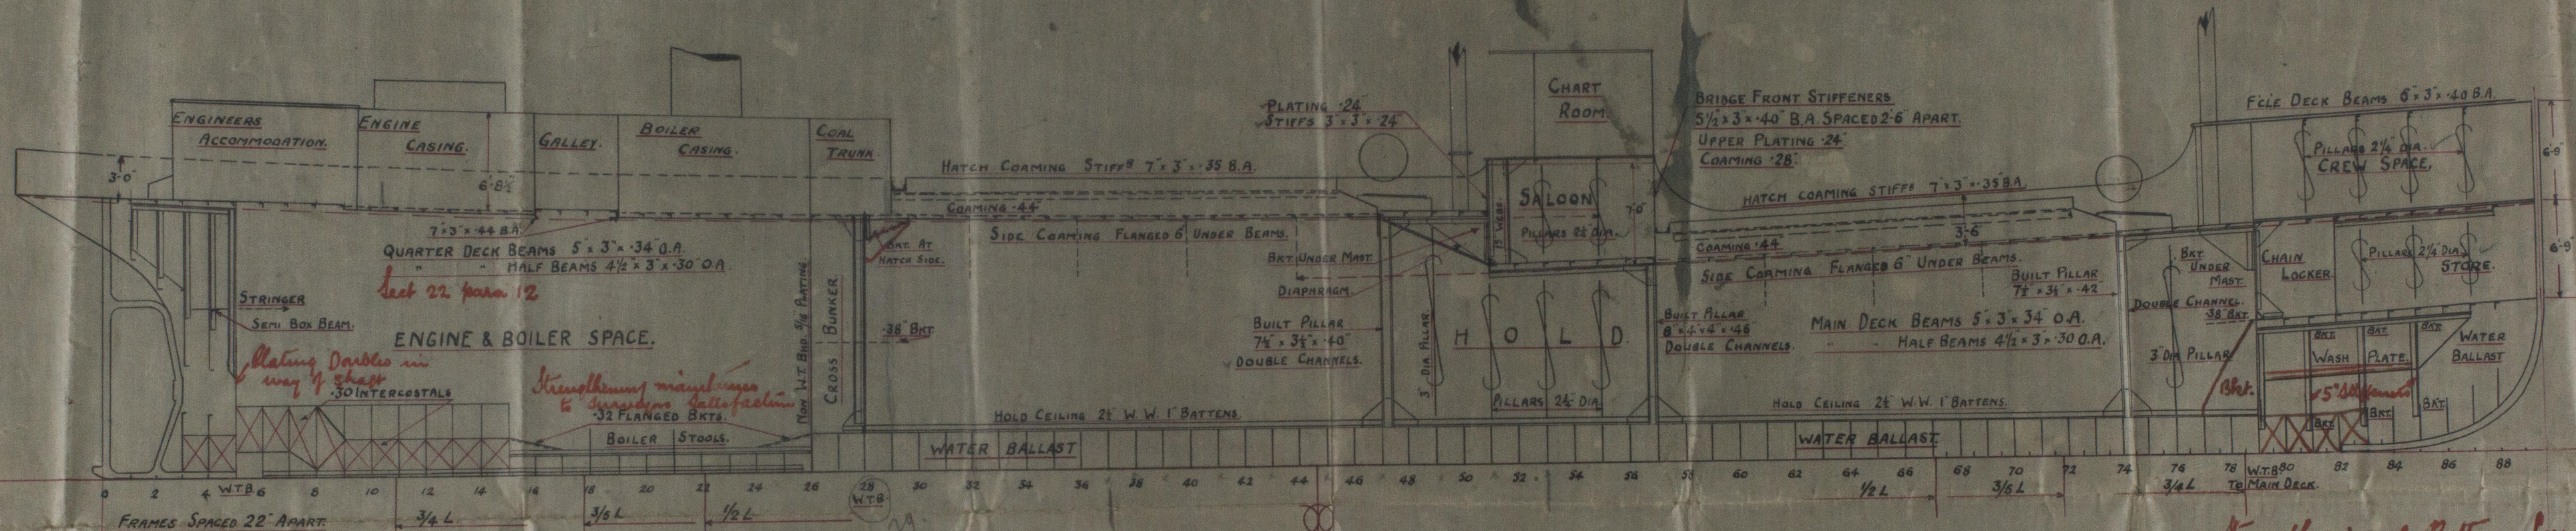

*Strengthening of Bottom forward of 1/2 hull as per rule, and plan to be submitted*  
 FORECASTLE DECK.

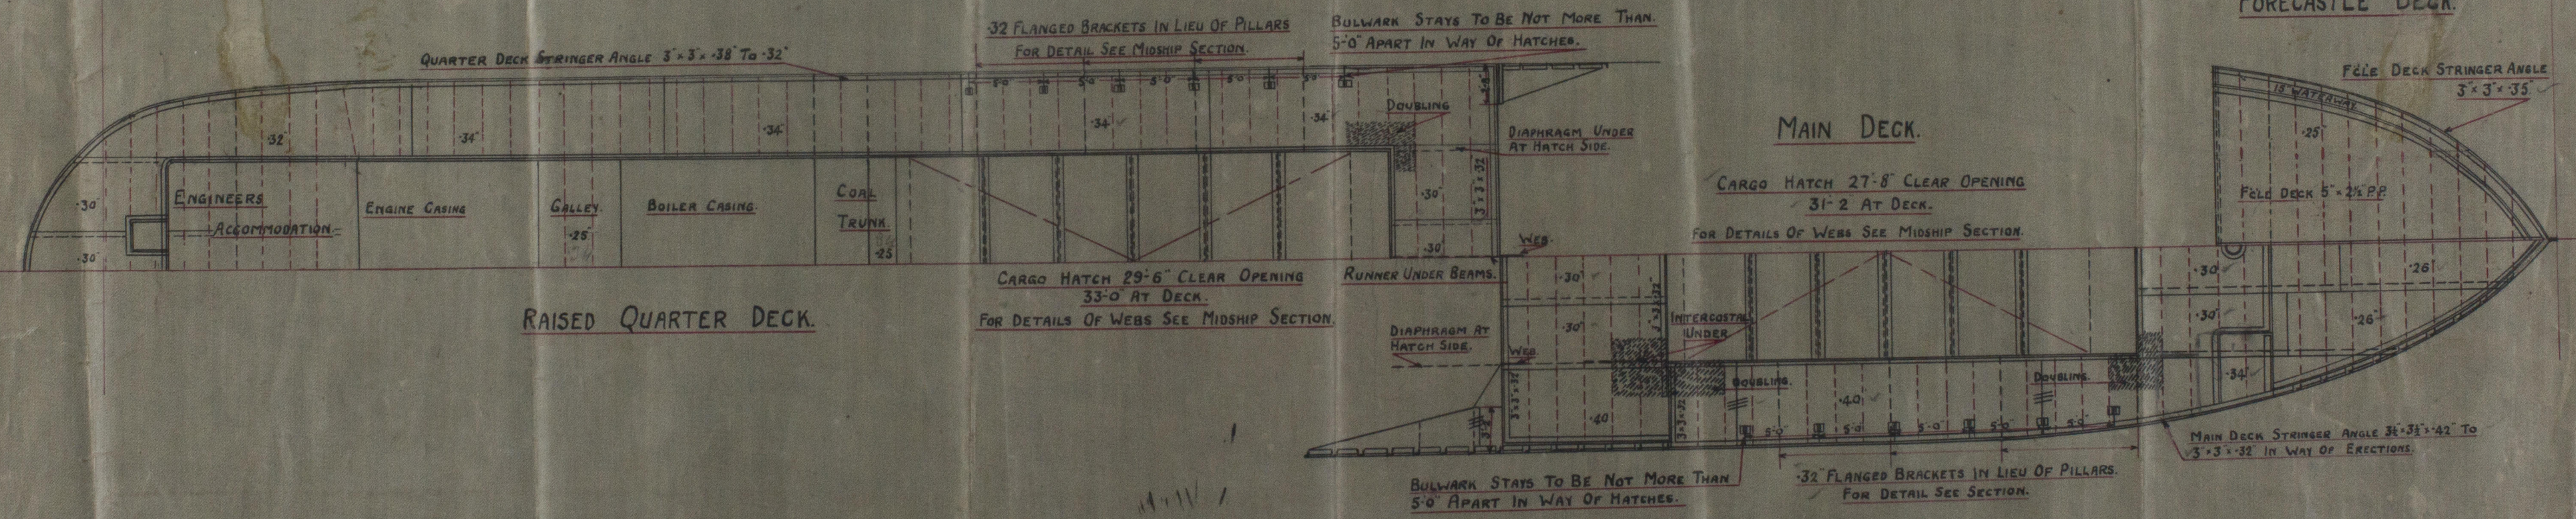

BULKHEAD SCANTLINGS.

NO. OF BAR	FRAME	RIVETING	LOWER PLATE	PLATING	STIFFENERS	SPACING	BRACKETS
5 W.T.	5" x 5" x 48"	DOUBLE SINGLE	36"	30"	6" x 3" x 40" ANGLE AT 6"	24"	3 - 3/4 RIVETS.
28 W.T.	3" x 3" x 40"	SINGLE	34"	30"	6" x 3" x 36" B.A.	30"	3 - 1/2 RIVETS.
79 W.T.	5" x 5" x 40"	DOUBLE SINGLE	34"	30"	6" x 3" x 36" O.A. BELOW W.T. FLAT 5" x 30" O.A. ABOVE W.T. FLAT	24"	3 - 3/4 RIVETS.

FORE PEAK W.T. FLAT BEAMS 5" x 3" x 30" O.A. KNEES 12" x 30"

*13.12.19.*

MESSRS. THE GOOLE SHIPBUILDING & REPAIRING CO. LTD.  
 GOOLE.



Goole S.B. & R. Co.

No 220.

~~Midship Section~~

Profile of deck

of Gleniside

Hull A.P. No 32550 R

" 32864

© 2021

Lloyd's Register  
Foundation

