

YARD NO 397

"J. P. WEBB"

PROFILE & DECKS.

SCALE $\frac{1}{8}$ " & $\frac{1}{4}$ " = ONE FOOT.

APPROVED BY LLOYDS 22/12/49.

DIMENSIONS - 195'-0" B.P. x 36'-0" MLD. x 17'-0" MLD.

L = 195.00. B = 36.00.

D = 17.00. d = 14.75 (SUMMER MOULDED DRAFT)


h (AMIDSHIPS) = 15.00.

h (BETWEEN .25 L. TO .15 L. FORWARD) = 16.00.

h (FORWARD OF .15 L. FROM FORWARD) = 19.00.

NOTE - WINDLASS, CAPSTAN, STEERING GEAR, HOUSES, ETC.

TO BE SUPPORTED TO SURVEYORS SATISFACTION.

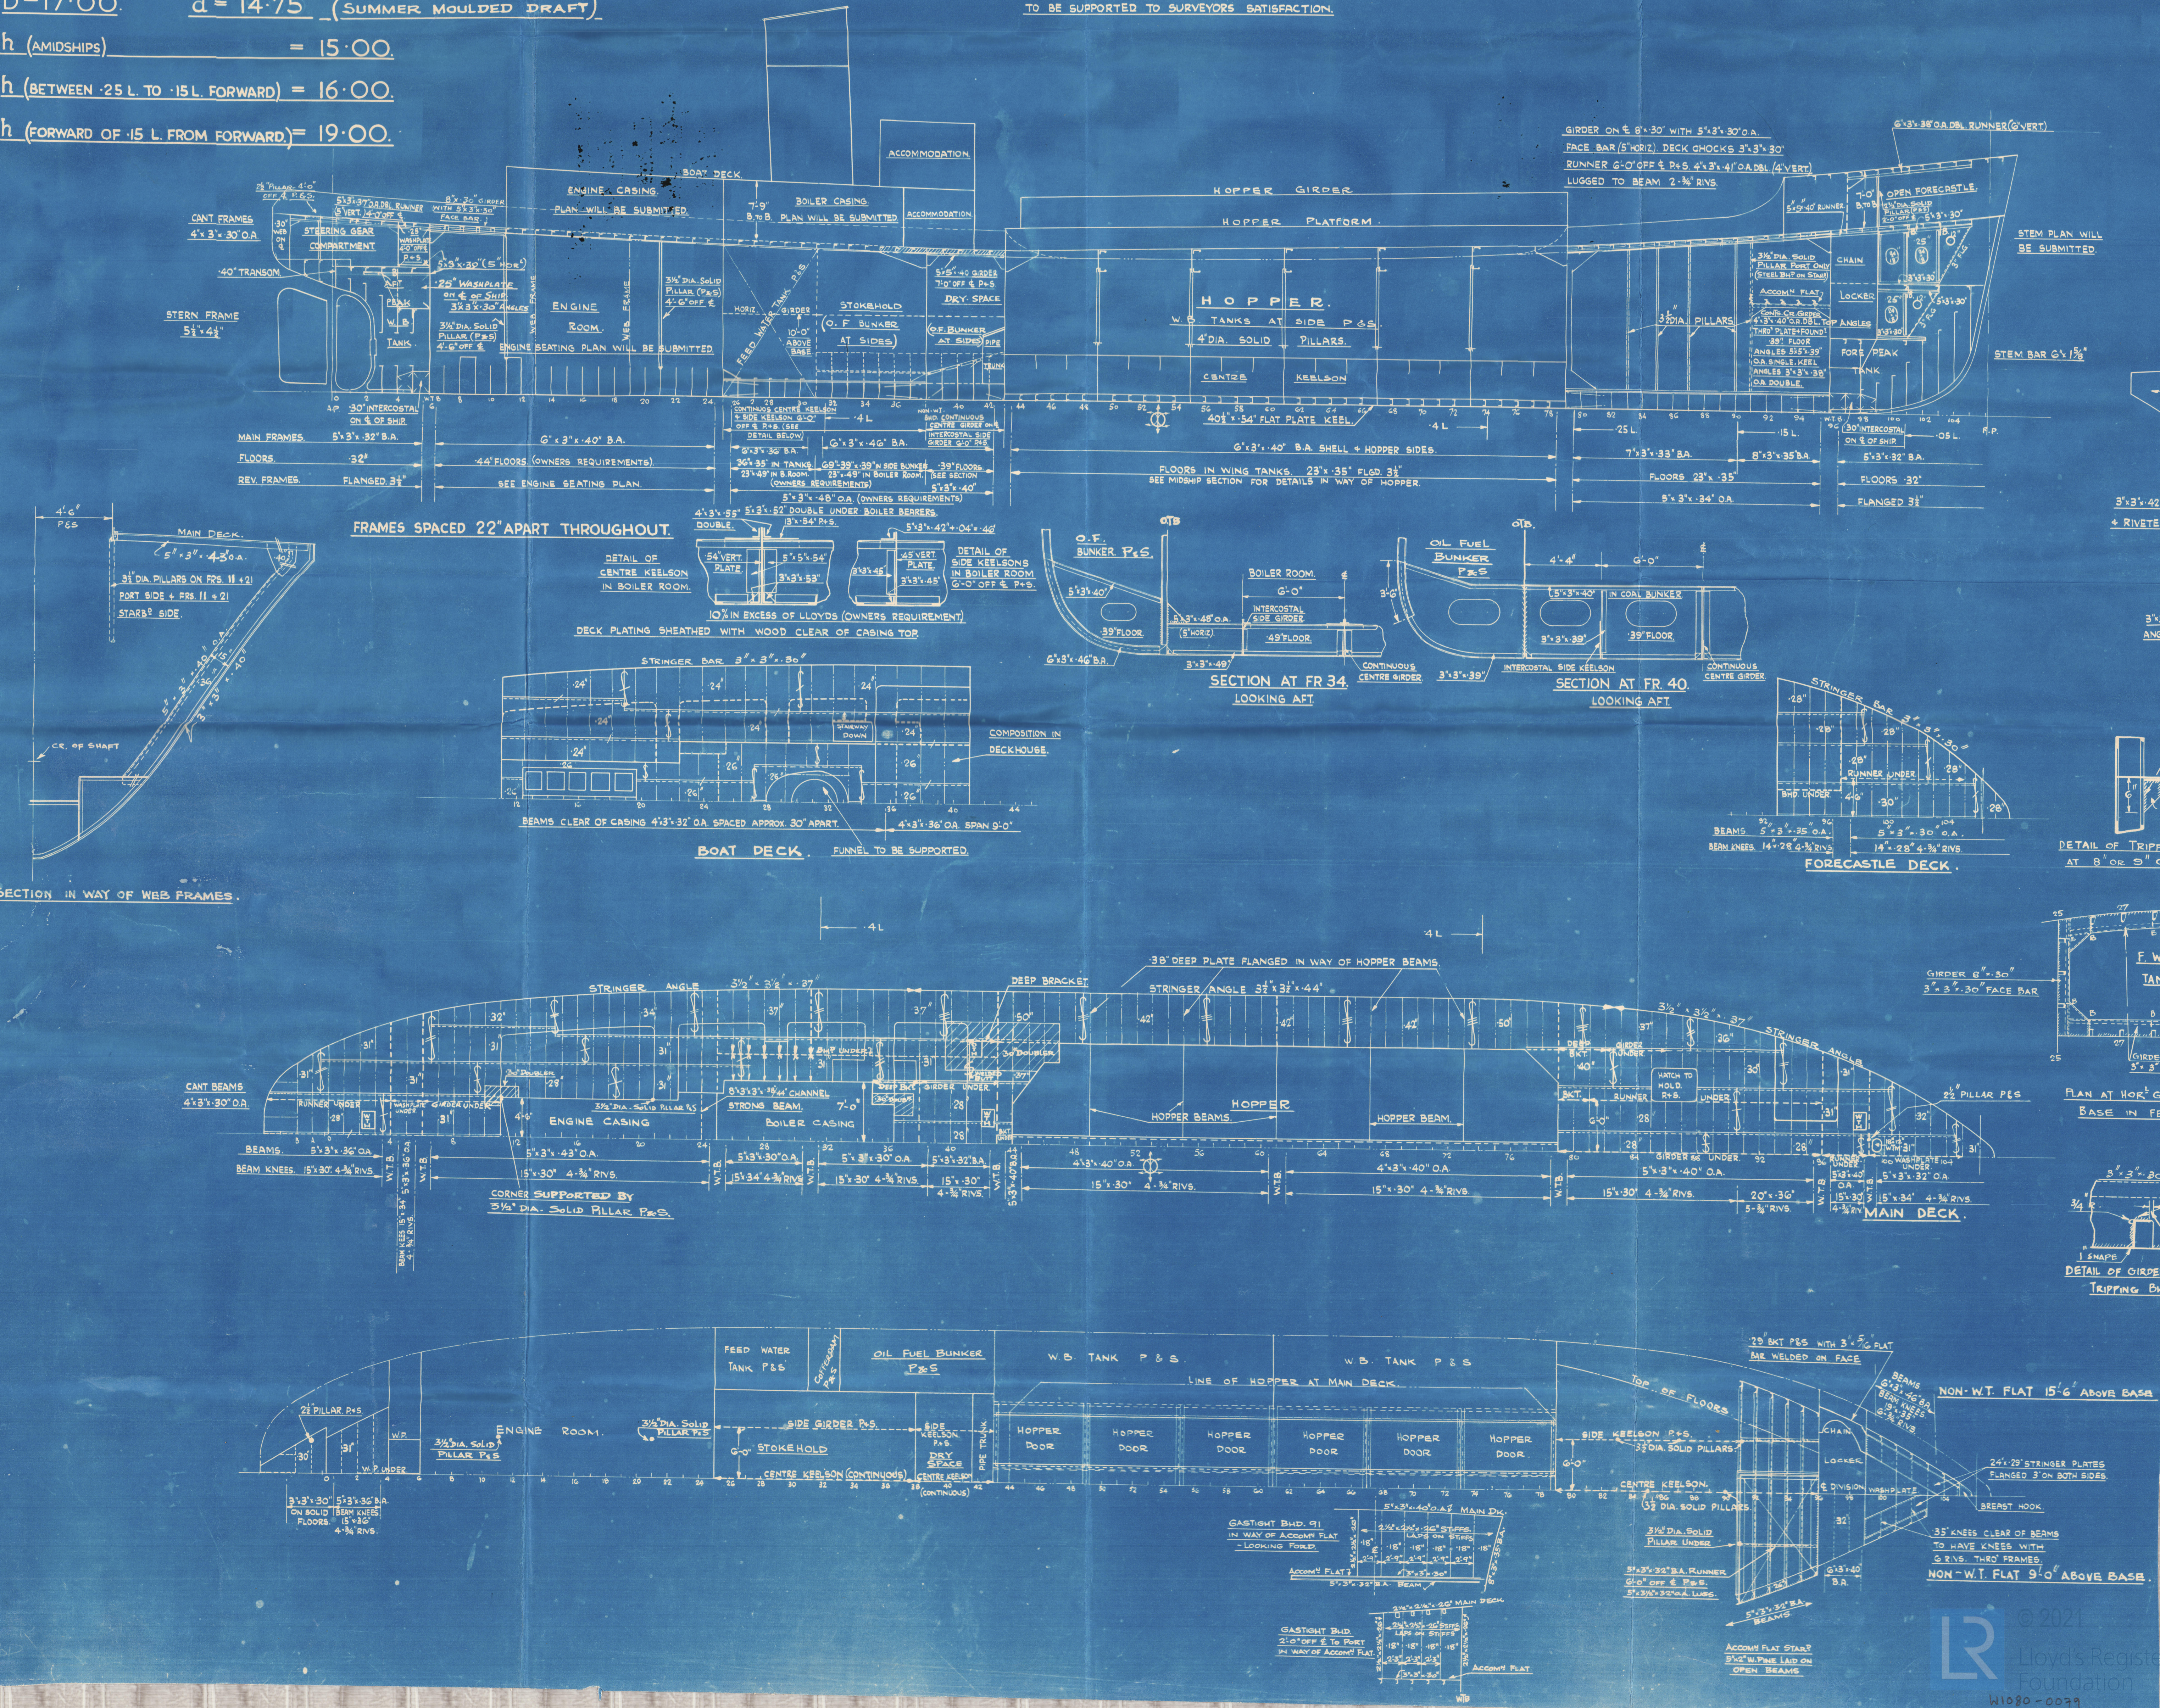

Ferguson Bros (P.S.) Ltd

Land No 397

J. P. WEBB *

Profile & Decks
as fitted

Graham & Co. Report No. 24460

~~PLANS TRANSFERRED~~
~~TO SISTER VESSEL~~
RECORDS DEPT.
LONDON

4

J.P. Webb

REMAIN



© 2021

Lloyd's Register
Foundation

W1080-0079