


SCALE  $\frac{1}{2}'' = 1 \text{ FT}$

EQUIPMENT NUMBER  
32,600 + 2,400 + 732 = 35,732.

NOTE:- NAMES OF DECKS ALTERED IN BLUE IN ACCORDANCE WITH OWNERS' REQUEST.

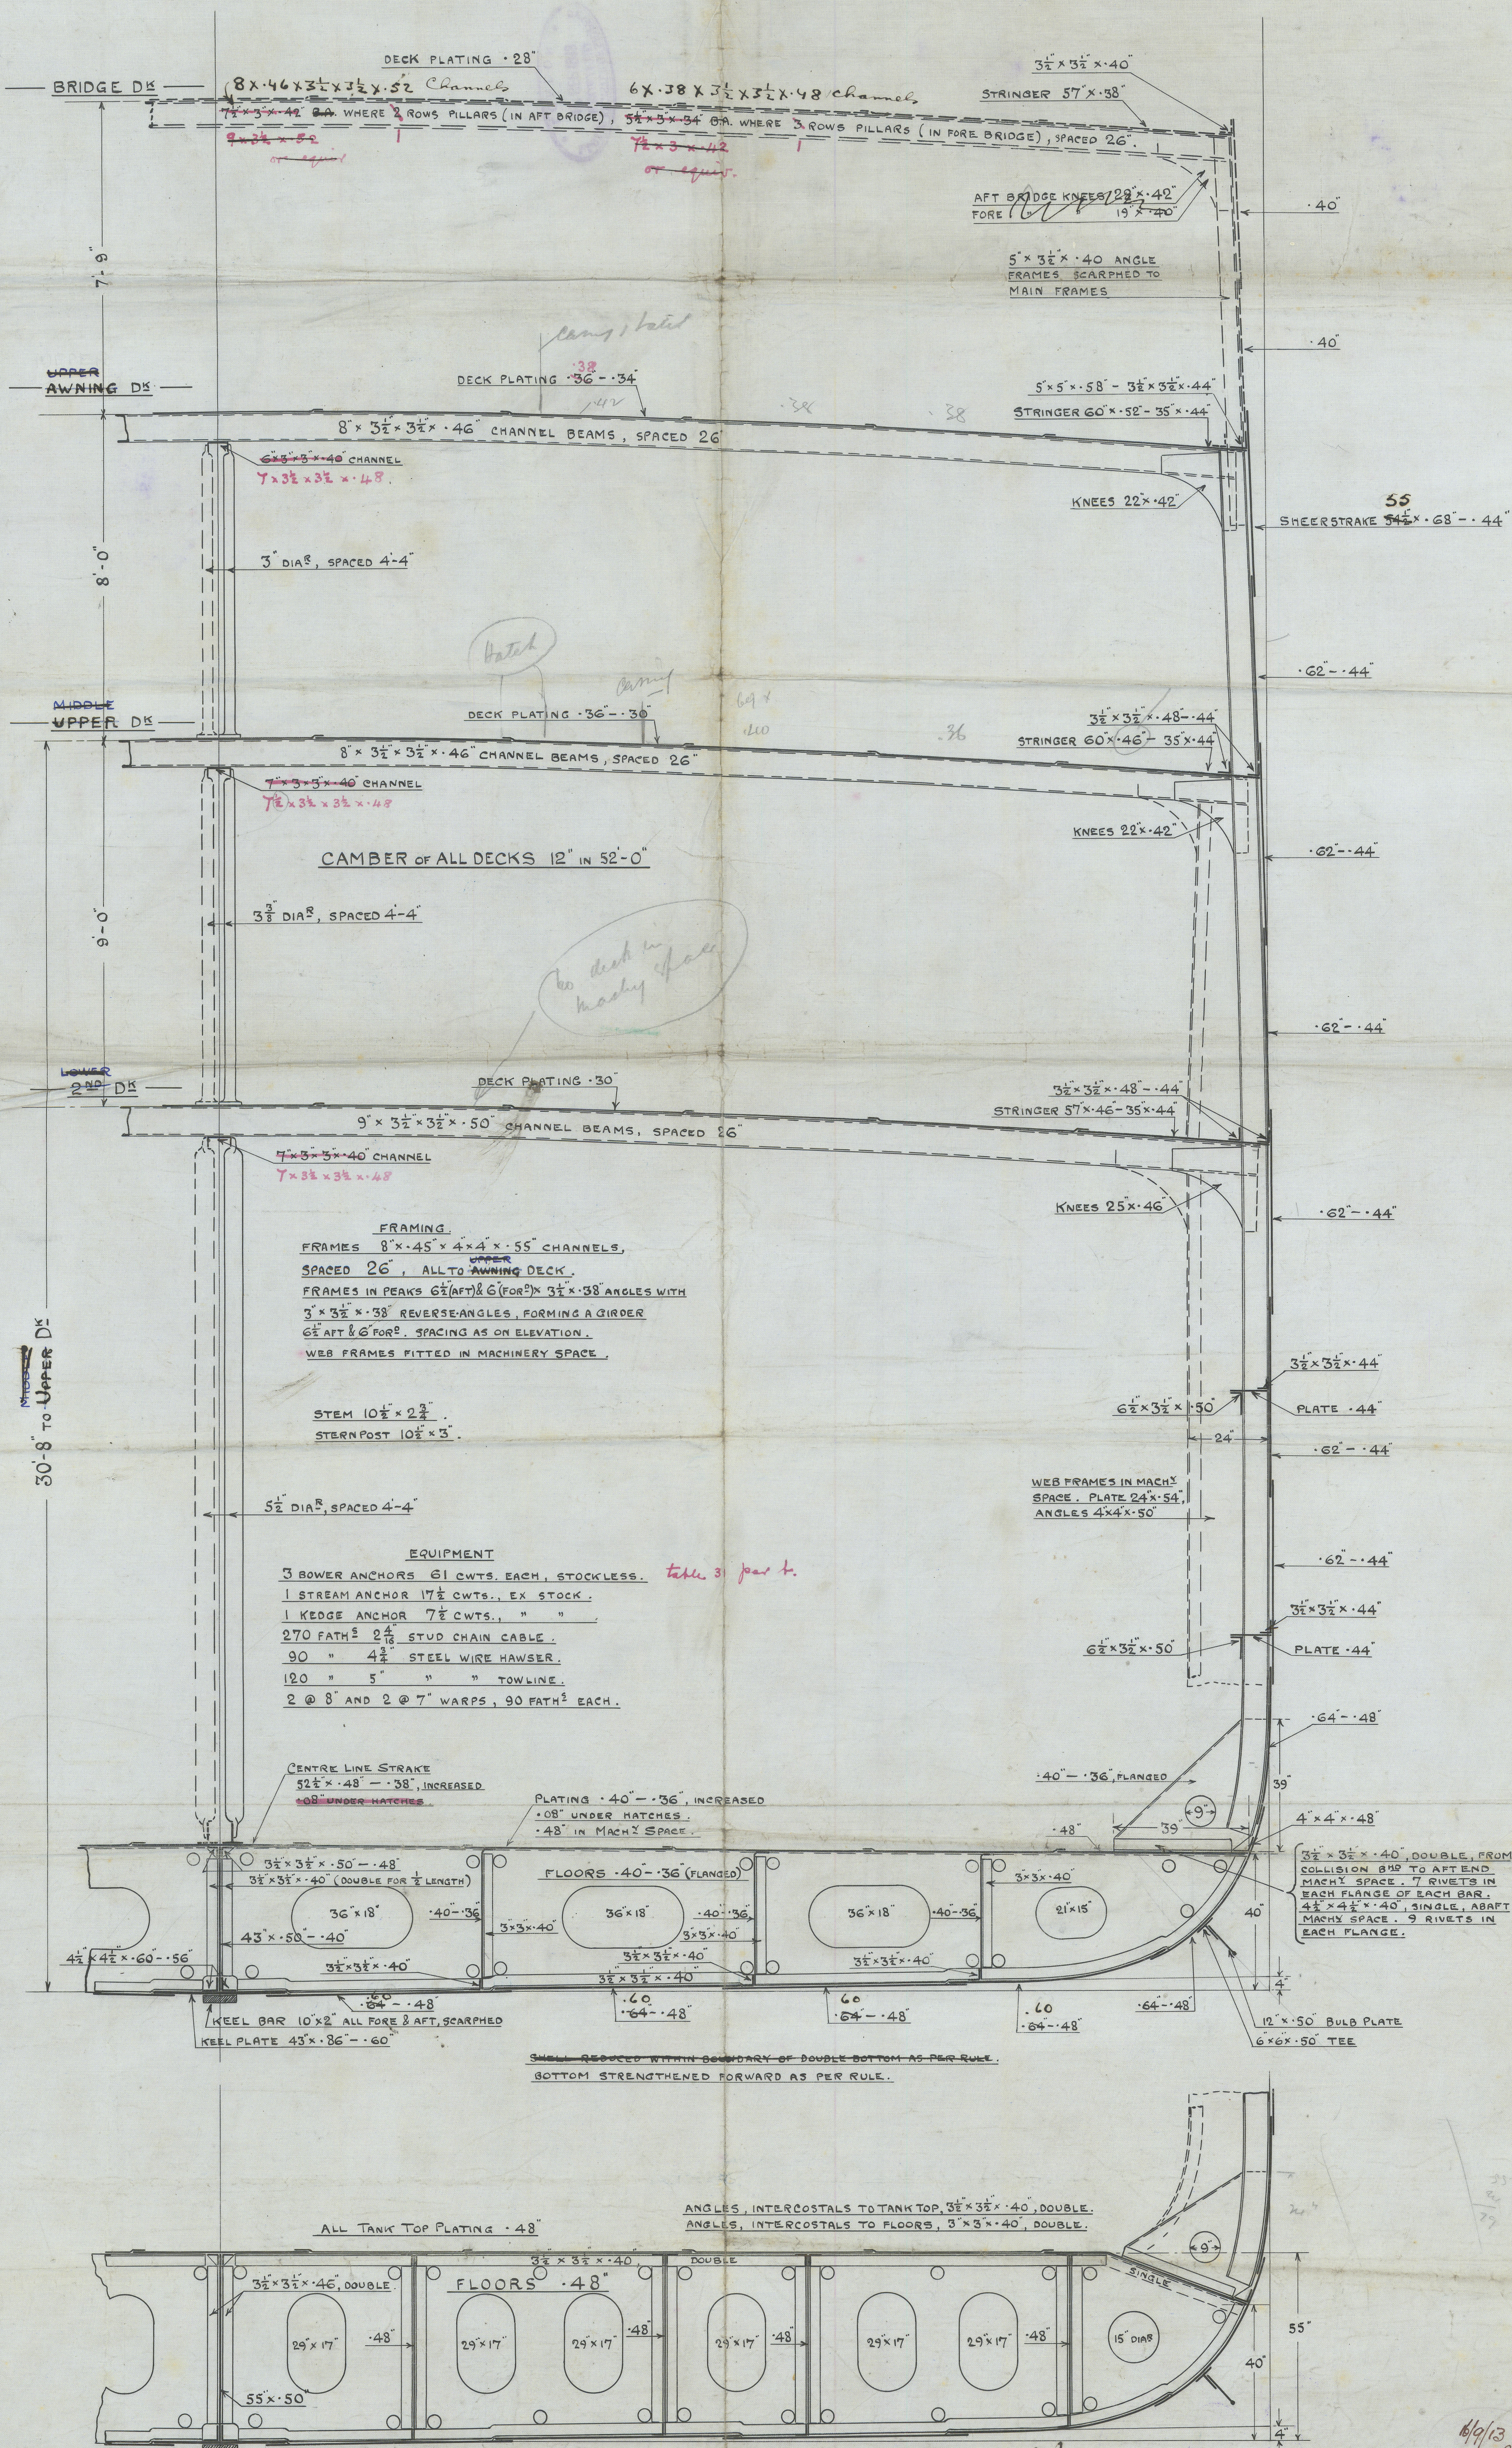

— SECTION IN WAY OF ENGINES —  
SCANTLINGS AS AMIDSHIPS EXCEPT WHERE INDICATED OTHERWISE



S.S. No 466 G

SEP 7 1910

1900-1801M



M/S LAUTARO

ex

*m/s Bostonian*

GLASGOW REPORT No. 35647

THE  
W  
O  
R  
L  
D  
O  
F  
T  
H  
E  
F  
U  
T  
U  
R  
E

2000-0004

020

nd's  
ndat

© 2020

Lloyd's Register  
Foundation

© 2020

Lloyd's Register  
Foundation