


Such Plans to be submitted

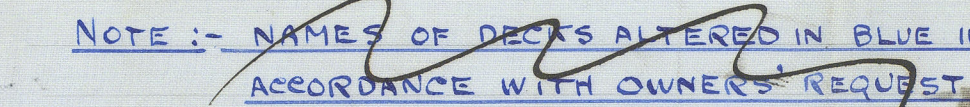

C. f.
20. 9. 13

16/9/13
AK

Lloyd's Register
Foundation