






— S.S. ARBROATH —

— OUTLINE ARRANGEMENT —

— SCALE $\frac{1}{8}$ " = 1 FOOT —

— DIMENSIONS 212'0" B.P. x 32'0" M.L. x 16'3" M.L.B. —

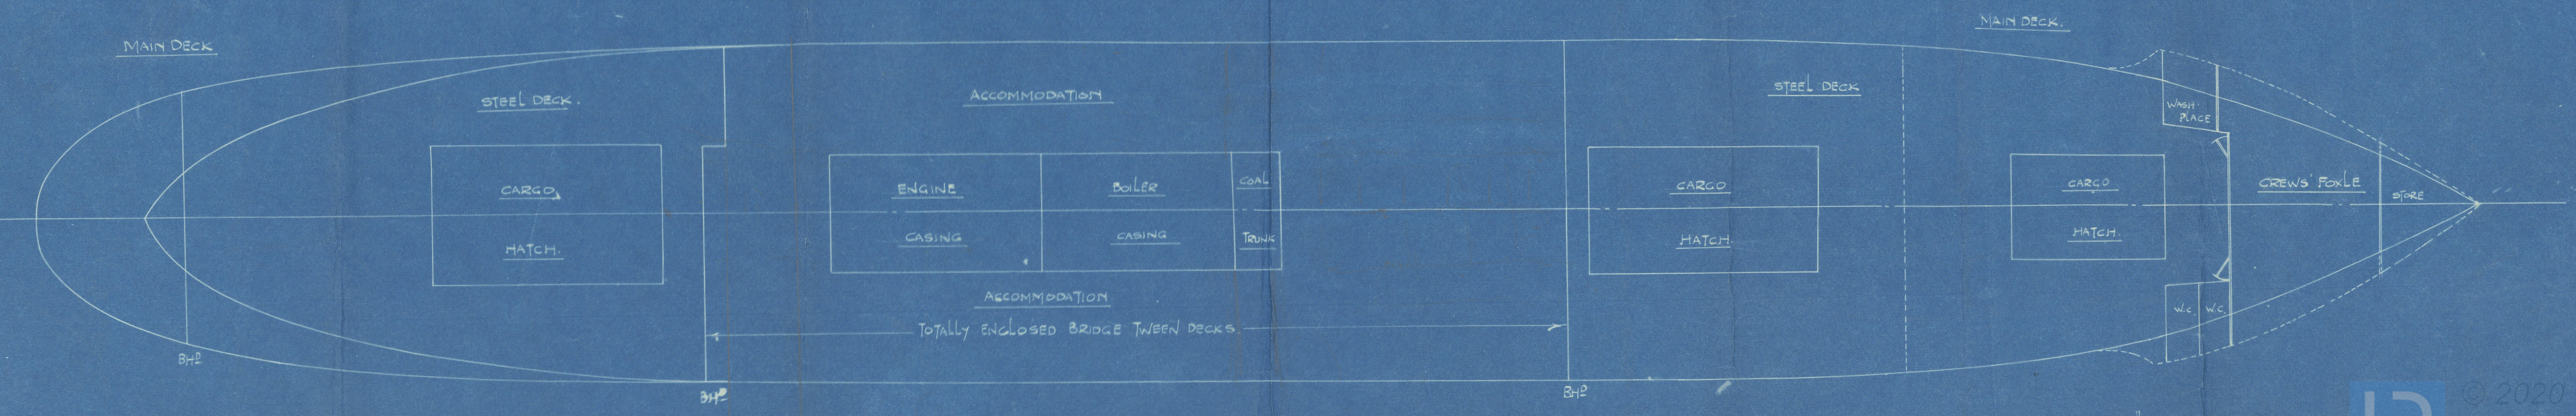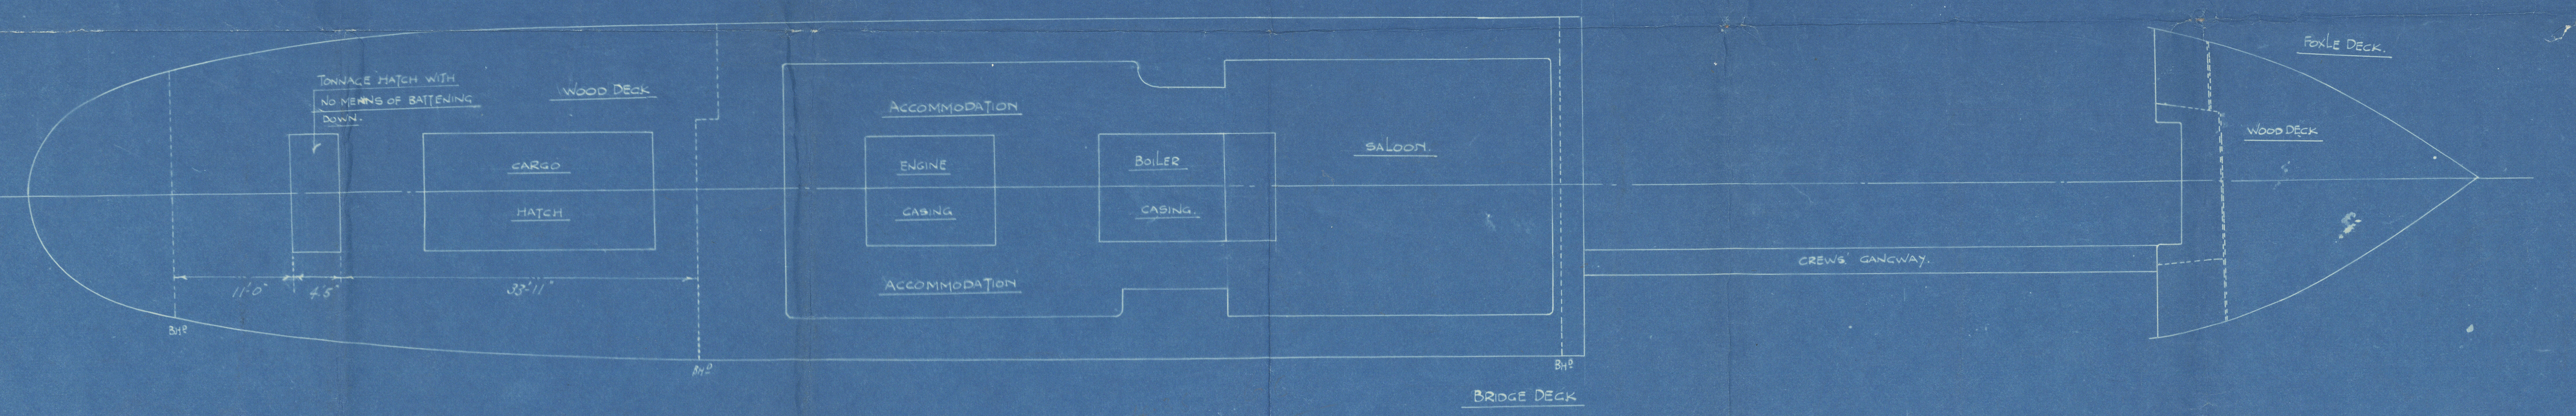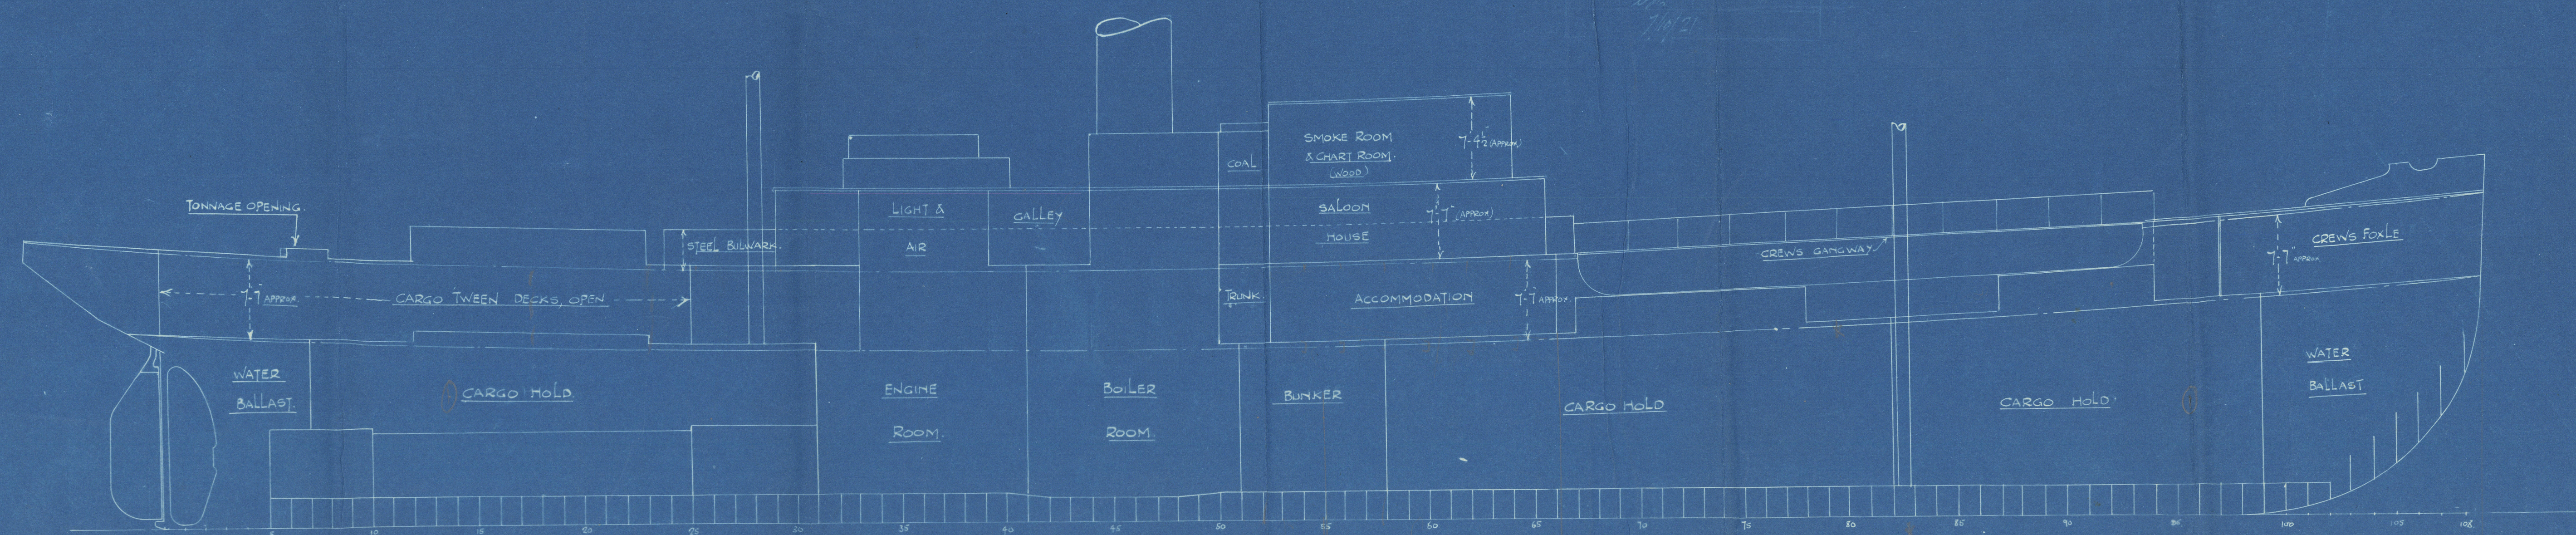

St. Ambroath
(ex Alexandra)

Profile

Showing
opening *fr*

PROFILE.

S. S. "ALEXANDRA"

Run 8327

RETAIN

RETAIN