

SS ARBROATH ex ALEXANDRA MIDSHIP SECTION

LENGTH 212' 0"
 BREADTH 32' 0"
 DEPTH 16' 3"

SCALE 1" = 25'

$Q = \frac{1}{2} \times \frac{1}{2} \times 928 \times 4876 = 14,106 M$


$Q_L = 9125 \text{ sq ft}$ $Q_T = 4876 \text{ sq ft}$

$\frac{1}{111} = 1.185$ $\frac{1}{111} = 1.062$ $Q_L = 111 = 968$

CLASS GERMAN LLOYD 100AL(2)

Thicknesses of Shell Plating as required by the present rules.

Keel 50-46
 Bottom shell 41-36
 Side shell 41-36
 Strakes below sheer 47-36
 Main Sheer Strake 51-36

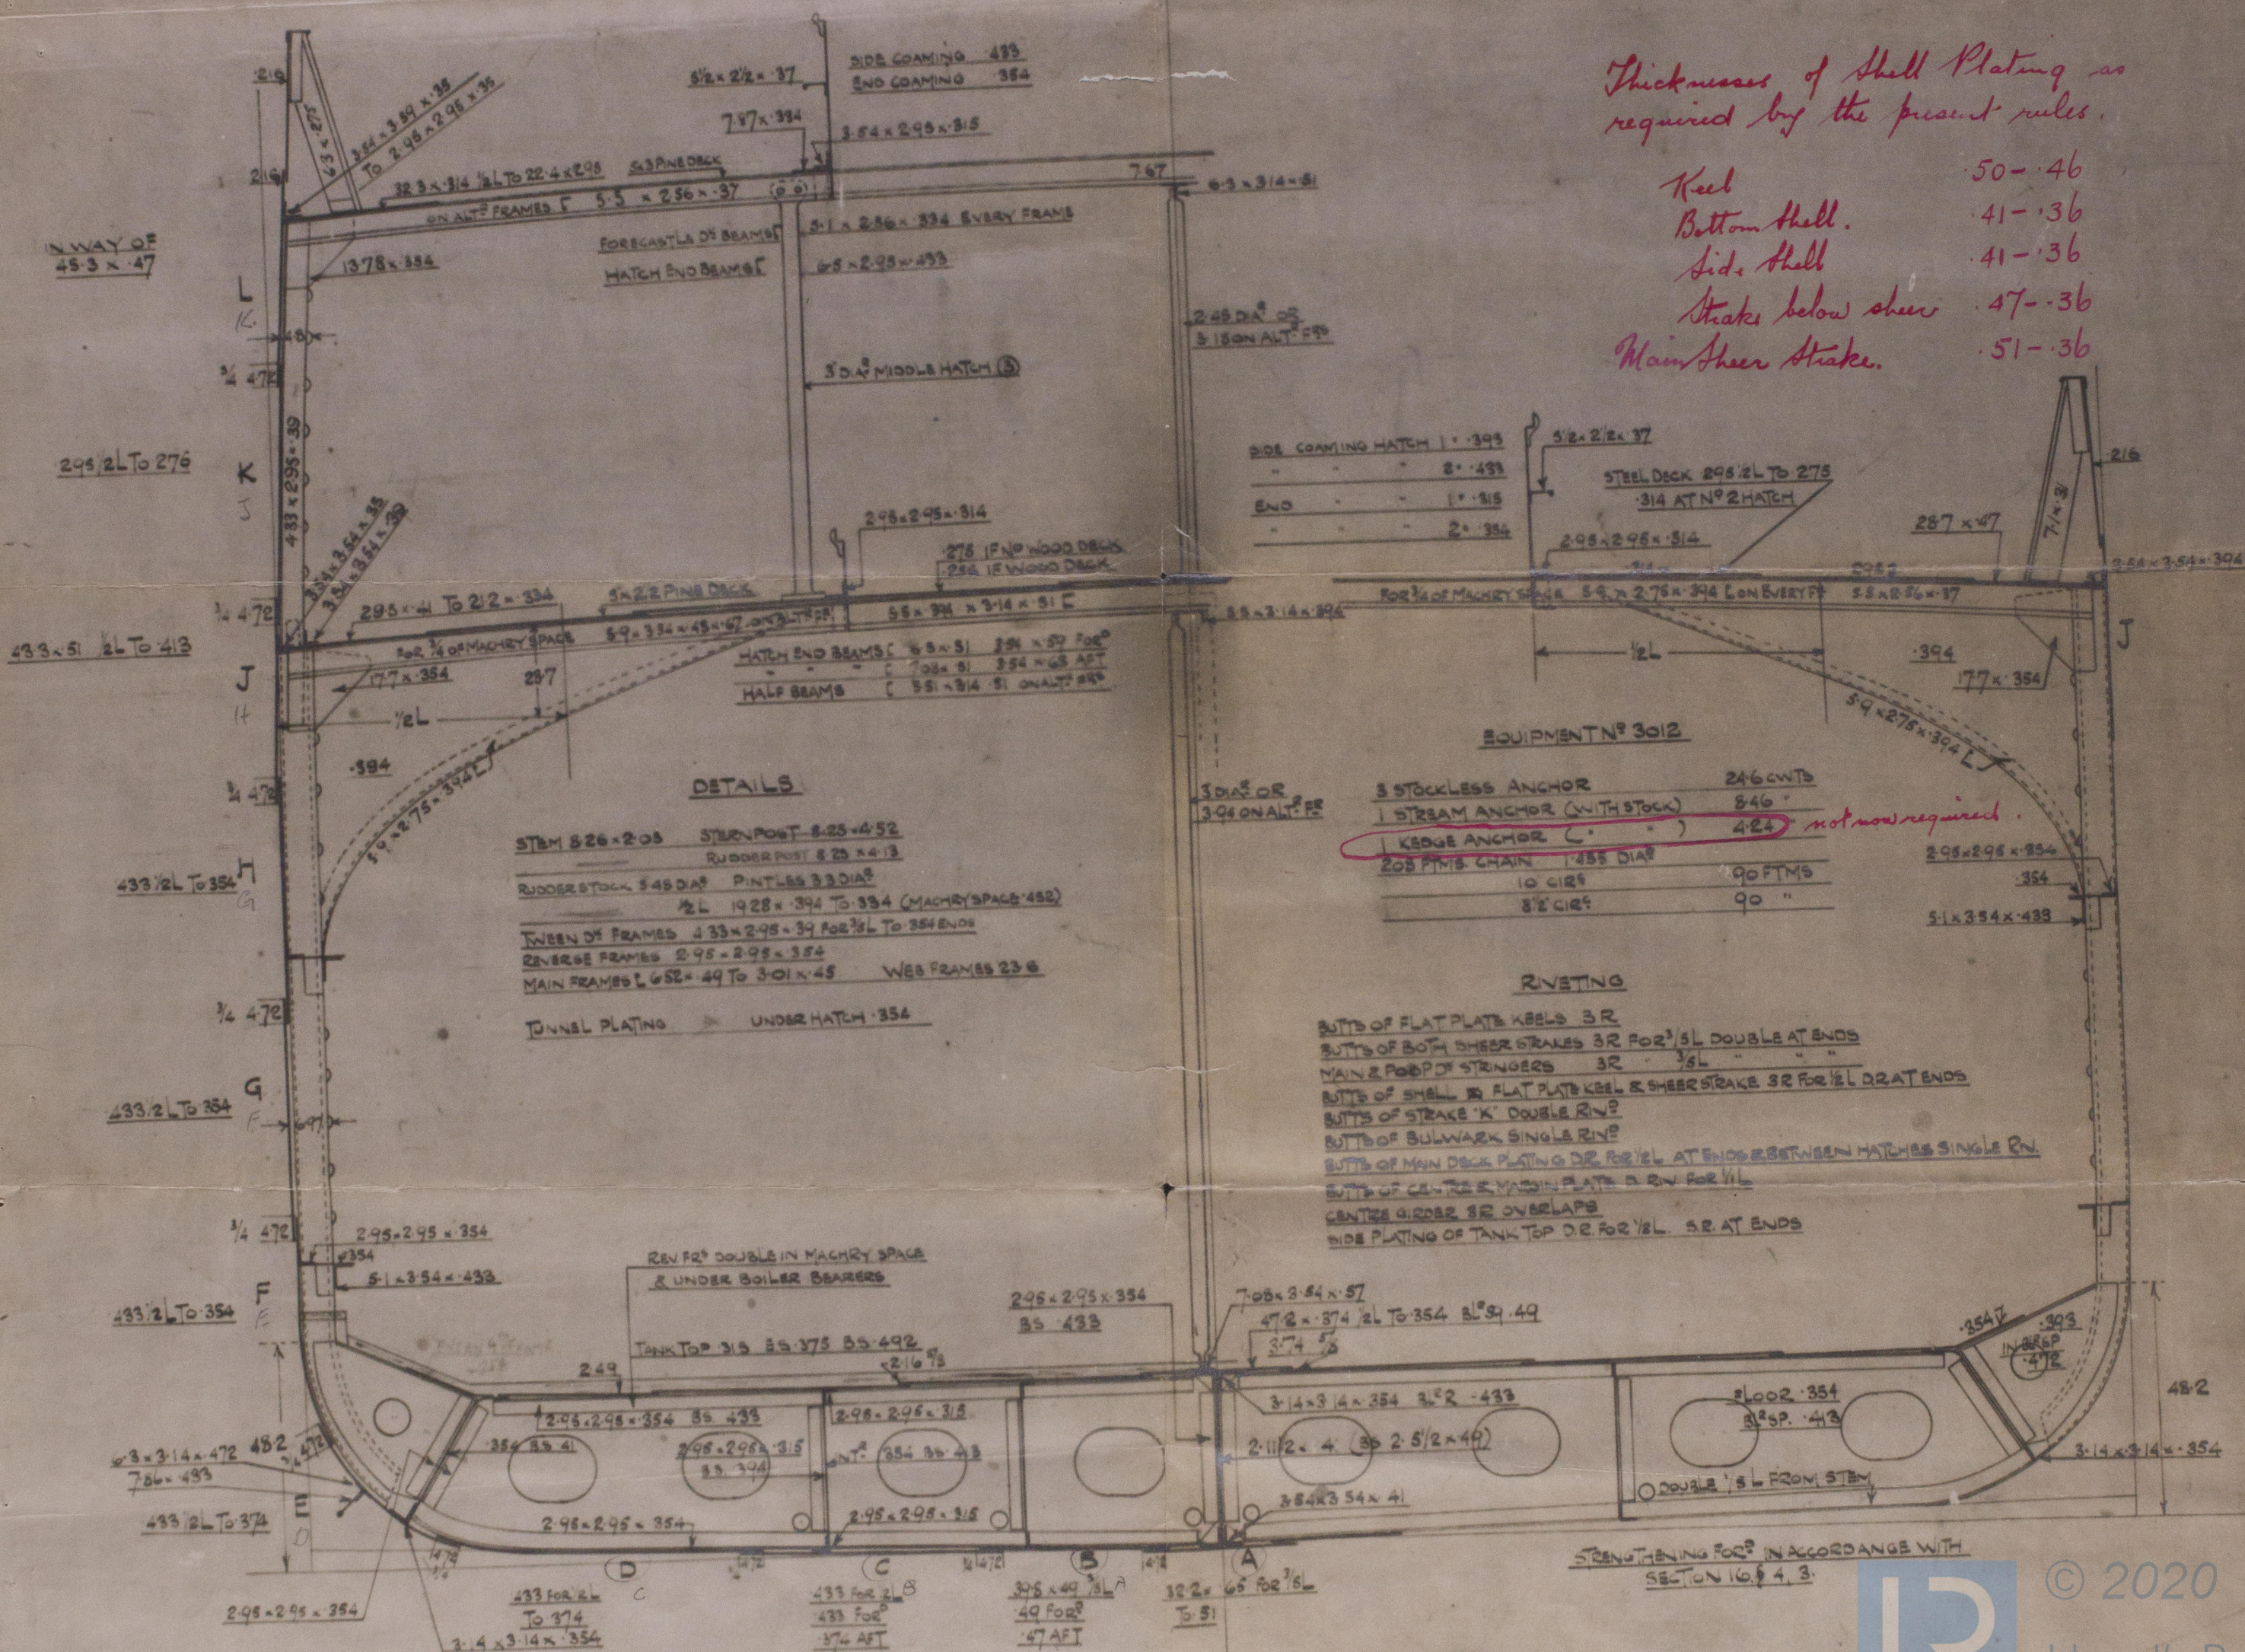

Adv. : mtl

Steel Sc. "GASPESIA"
(Det. Rostock 1909)
Midship section
(Hare copy)

File with F.E. ref!

RETAIN

RETAIN



© 2020

Lloyd's Register
Foundation

W1081-0176