
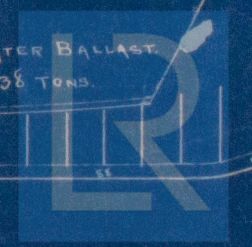
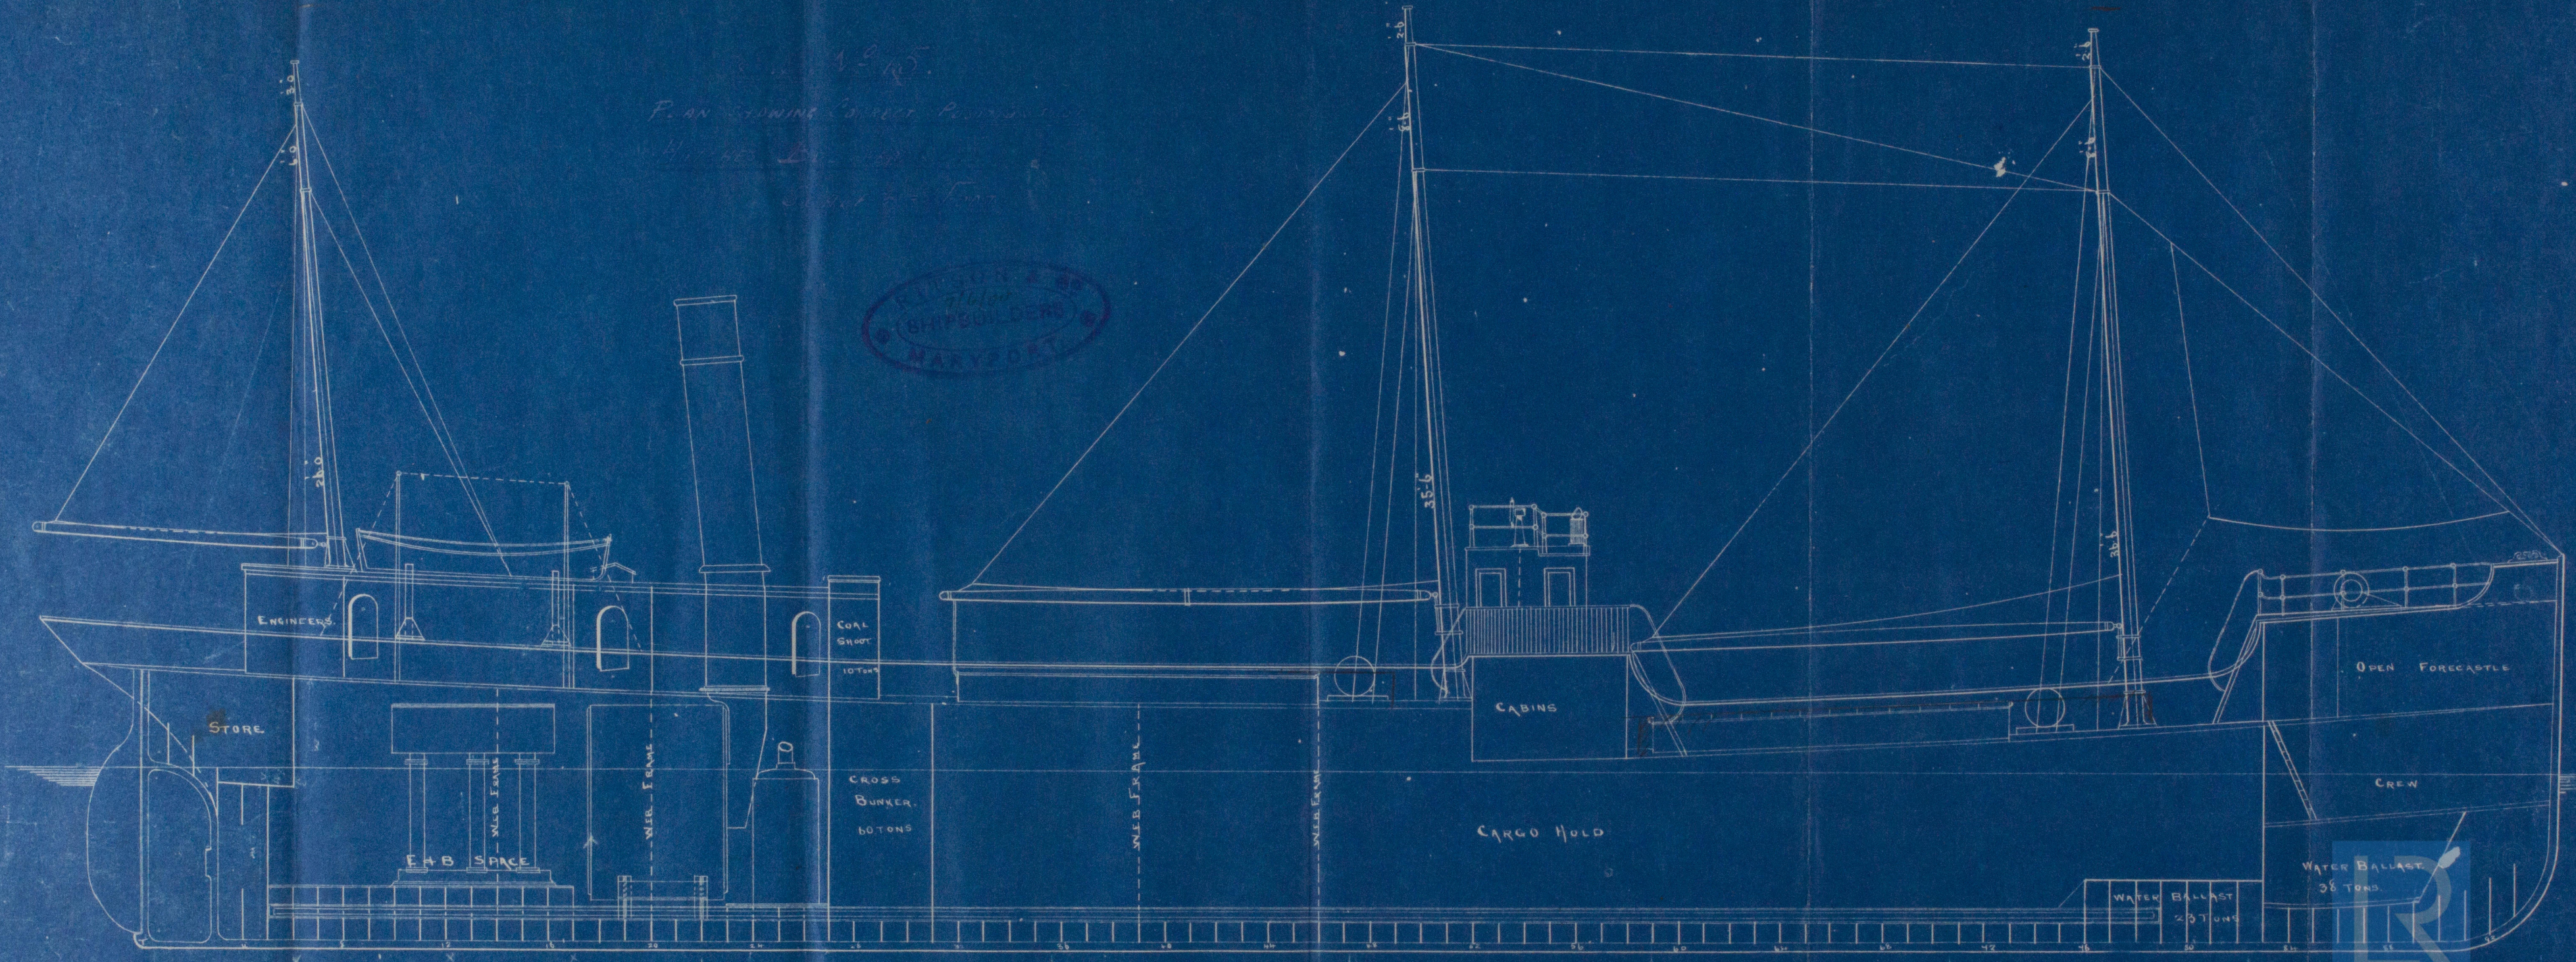


1915
 PLAN SHOWING CORRECT POSITION OF
 HULL, DECK, AND
 SKELETON OF THE SHIP

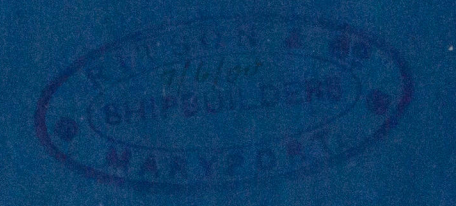

Peterson & Co
Maryport
Corrected Profile No 75

S. S. POINT CLEAR

Barrow report 995

~~W. H.~~ EX
"DICKY"

N/N HESTOR

RETAILED



© 2020

Lloyd's Register
Foundation

W1081-0300