


LLOYD'S REGISTER OF SHIPPING
 LONDON
 288.99

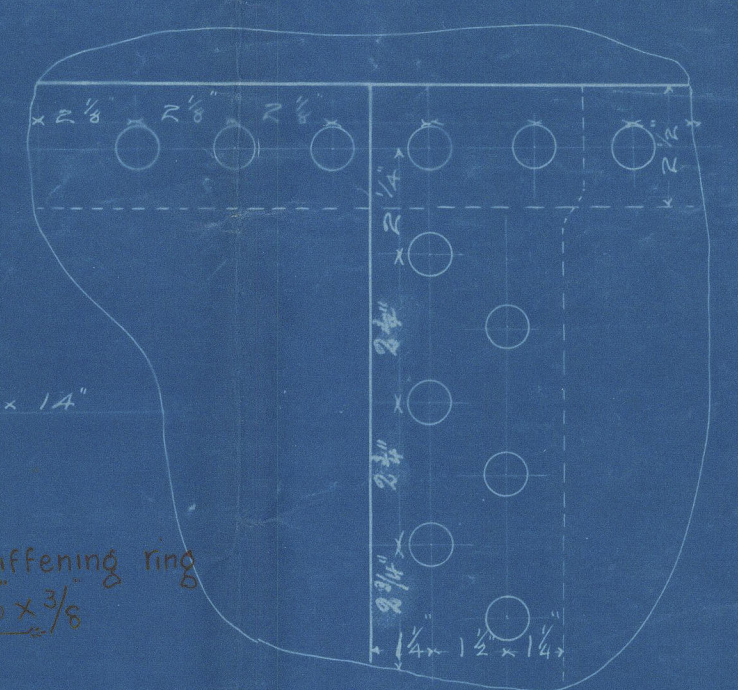

RIVETS 3/4" DIA.
 HOLES 1 3/16" DIA.

SCALE 3" = 1'-0"

Complete row
 except opposite
 tube

Annular Welded.



Steel Boiler 9' 3" high x 4' 6" dia
 Working Pressure 75 lbs
 GRADE 12 x 1800T

LLOYD'S REGISTER OF SHIPPING
 LONDON
 288.99

24 Aug 99

JMC
 28/8/99

LR

© 2020
 Lloyd's Register
 Foundation



Ross & Duncan's 808
D. Boiler 9" 3 x 4" 6

Ribbons 75

Gt. Point Clear

Glasgow. 18/8/88



© 2020

Lloyd's Register
Foundation

W1081-0303