



SCALE 1/8" = 1 FOOT

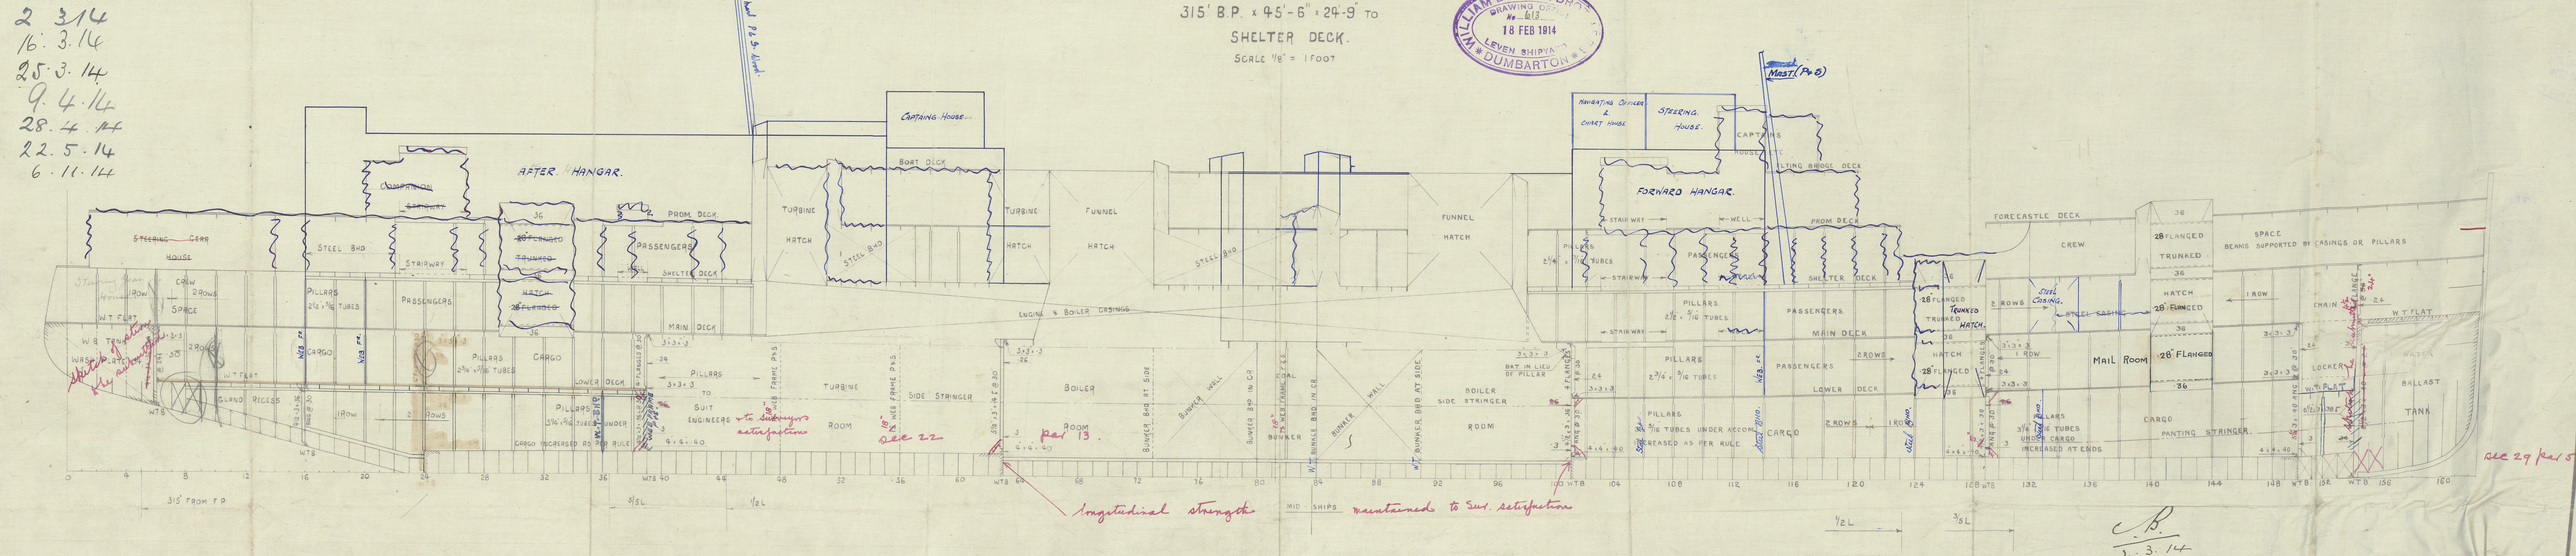


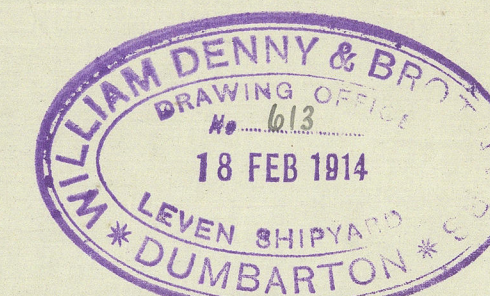


Profile

Messrs W. Genny & Bros.

S. S. No. 1016

RETAIN

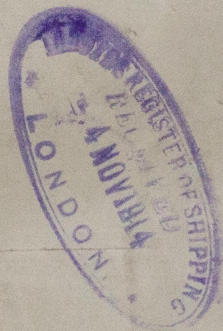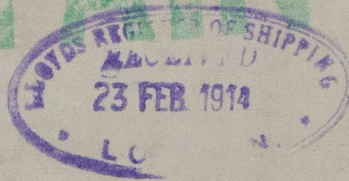

GLASGOW REPORT No. 34/135

S/S Naurana