


— POOP 36 · 0. BRIDGE 118 · 0. FORECASTLE 40 · 0. —

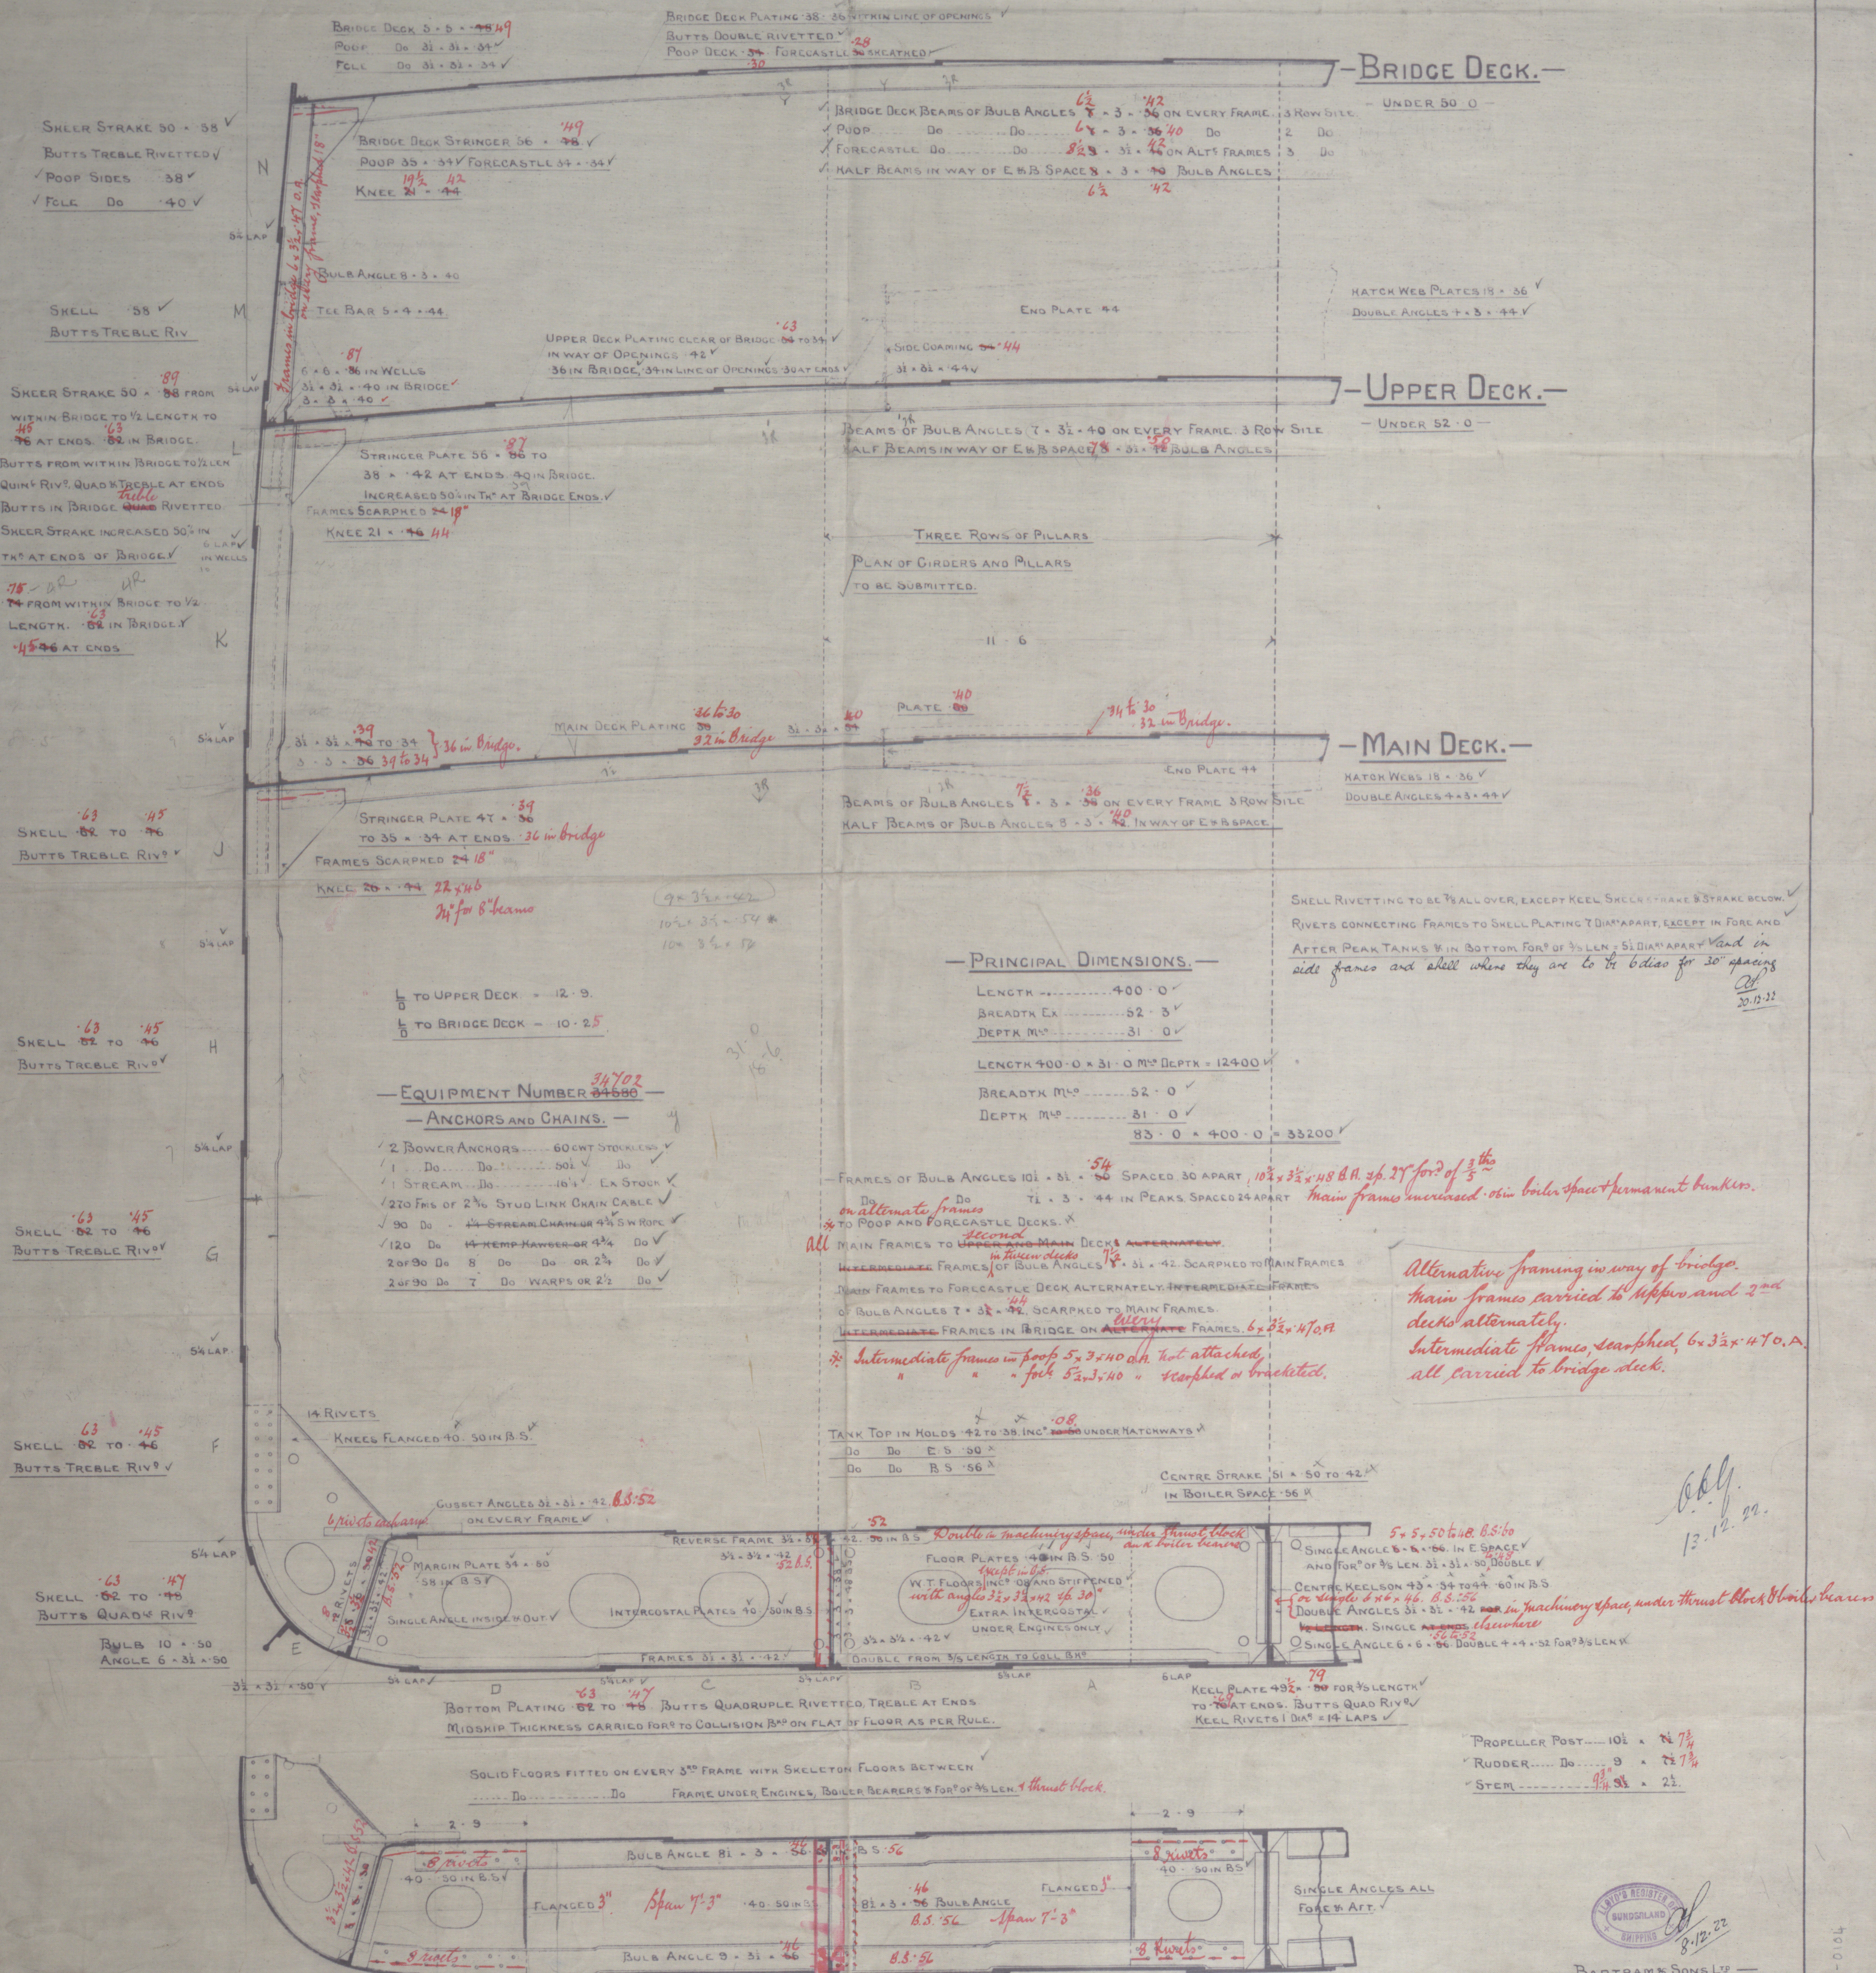

— BARTRAM & SONS LTD —

— SHIPBUILDERS. —

— SUNDERLAND.

© 2020  
Lloyd's Register  
Foundation



MESSRS

BARTRAMS

256 - 257

MIDSHIP SECTION

N<sup>o</sup> 256 = S.S. "Buchleigh"

Sld Rpt No. 28983

N<sup>o</sup> 257 = S.S. "Schulmleigh"

Sld Rpt No. 28984

RETAIN

RETAIN



© 2020

Lloyd's Register  
Foundation

W1084-0104