

TRACING N°1764

SCOTIA ENGINE WORKS

BOILER

WORKING PRESSURE 160 LBS PER SQ. INCH


TENSILE STRENGTH OF SHELL PLATES 28-32 TONS PER SQ"

" " LONGITUDINAL STAYS 27-32 " " "

ALL PLATES STAYS & RIVETS OF STEEL

ALL TUBES OF WROUGHT IRON

ALL RIVET HOLES DRILLED IN PLACE

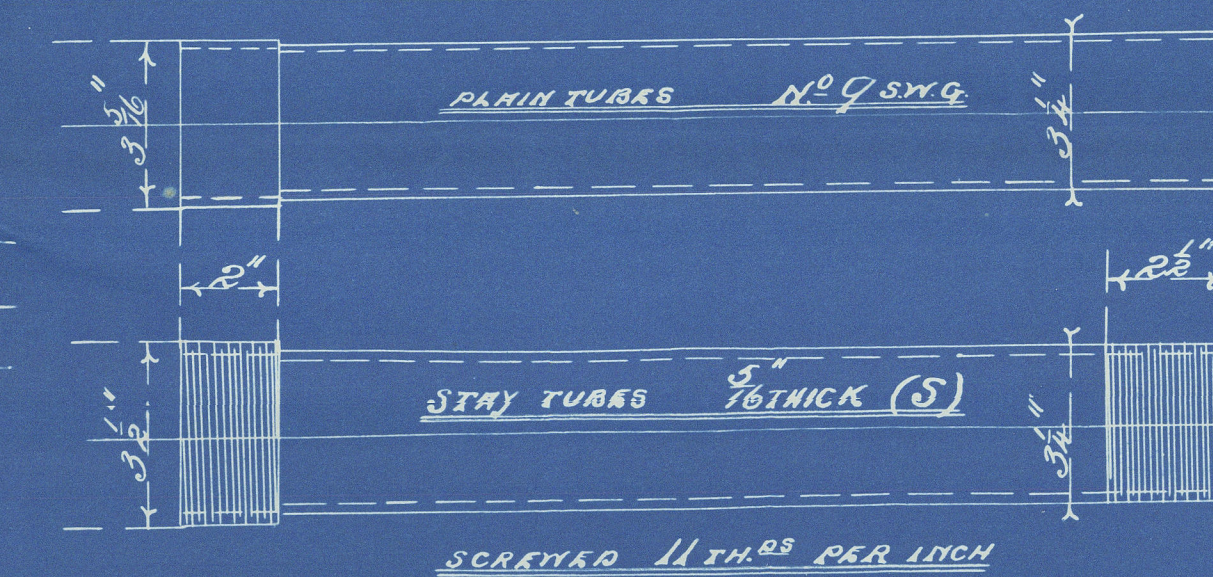

CONTRACT № 259

No OFF 2

128
Messrs. Swan, Hunter & Wigham Richardson
No 742 vessel

Messrs. Richardson Wentgarth & Co. L^{td}
No 259

N. P. -- 160 lbs

J. P. 'Alga'

Newcastle Report

No 149.808.

No 2442
Lloyds Test
320. lbs
14/11/05
A. B.

REMAIN



Lloyd's Register
Foundation

W1086-0234