


PLAN No. 5913
FOR ENCLOSURE TO
Messrs Lloyd's Register
Hull. FROM
COCHRANE & SONS, LTD.
SHIPBUILDERS, SELBY.
DATE 1/9/15.

3-9.15.

PROFILE & DECK PLAN


COCHRANE & SONS LTD

No 663.

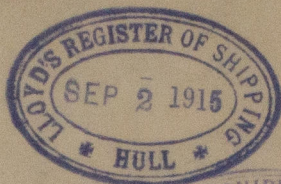


Hull Regt No 29571.

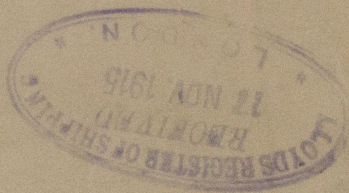

RETURN



© 2020

Lloyd's Register
Foundation
W1087-0090