

MESSRS STABLIMENTS TECNICO, TRIESTINO


© 2020
Lloyd's Register
Foundation

Wallend Boiler
No. 297-8-94300E
for

Stabilimento Termio
Tristino
180 lbs

Newcastle 9/5/13

please return plan

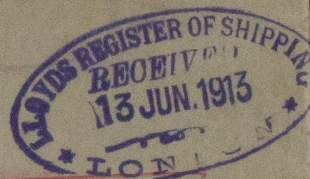

NEWCASTLE-ON-TYNE

Report No 64949

NEWCASTLE-ON-TYNE

Report No 65048

NEWCASTLE-ON-TYNE

Report No 65315

NEWCASTLE-ON-TYNE

Report No 65561

Lloyd's Register
Foundation

RETAIN

Adel, Cascone
Nov 4921

297-8-94300E

5C10-7801M