

— TWIN SCREW STEAM YACHT —

162'-0" ON L.W.L. x 28'-3" x 14'-6" MLD TO MAIN DECK

— SCALE $\frac{1}{8}'' = 1'$ FOOT. —

PROFILE.

MAIN DECK.

MAIN DECK BEAMS $\times 6' \times 4\frac{1}{2}" \times 10'$ BUTTERFLY SECTION } ON ALUMINUM PLATES FOR $\frac{3}{4}$ LENGTH TO $5' \times 4' \times \frac{6}{10}$ AT ENDS
~~and in the same way~~

87/10/03

© 2020

Lloyd's Register
Foundation

W10 87




W1087-0311

Fairfield S. B. & F. Co.

T. S. Yacht.


No 436.


Profile and
Deck Plans.

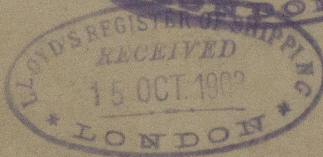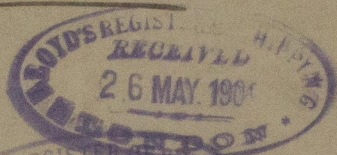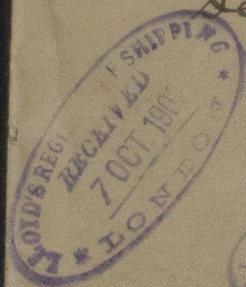

"Queen of Scots"

~~Glasgow & Co No 21805-~~

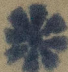N. N. "Dolores" *

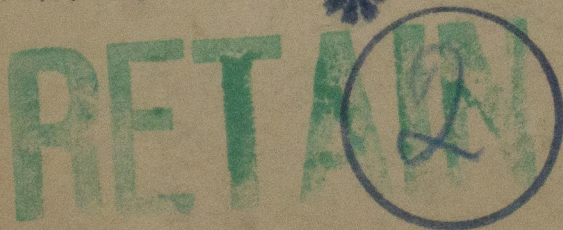

St. 6604.



© 2020

W1087-0311
Register
Foundation