



Surveyed Afloat or in Dry Dock? Dry Dock Name of Dock H. M. Shering Dock Destined Voyage to Port of Call

DECK THICKNESSES.	
ORIG.	AT BREAK
21.5	20
12	12
21.5	23
21.5	19
12	10
21.5	19
21.5	21
12	12
21.5	21

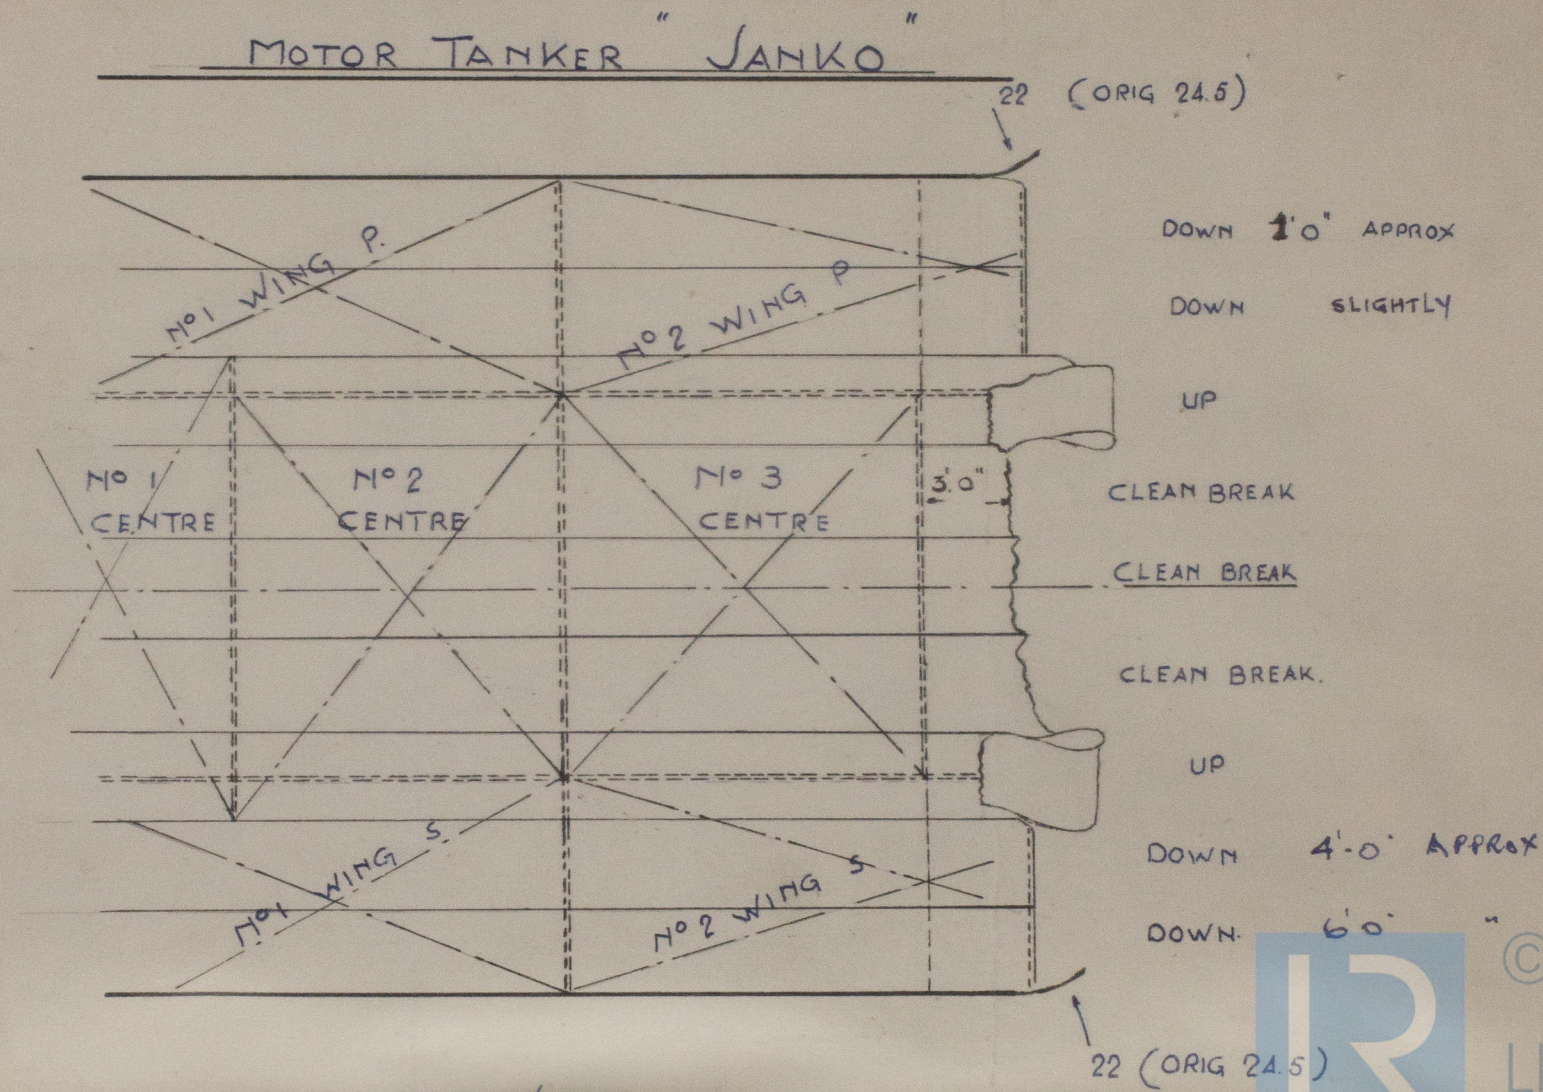

Note :- Tanks numbered from aft

subject of survey during construction of  
nery was recently thoroughly investigated by  
mittage Panel and their findings are embodied

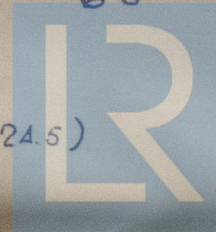

© 2020

Lloyd's Register  
Foundation

7110-8801M

Character Assigned