
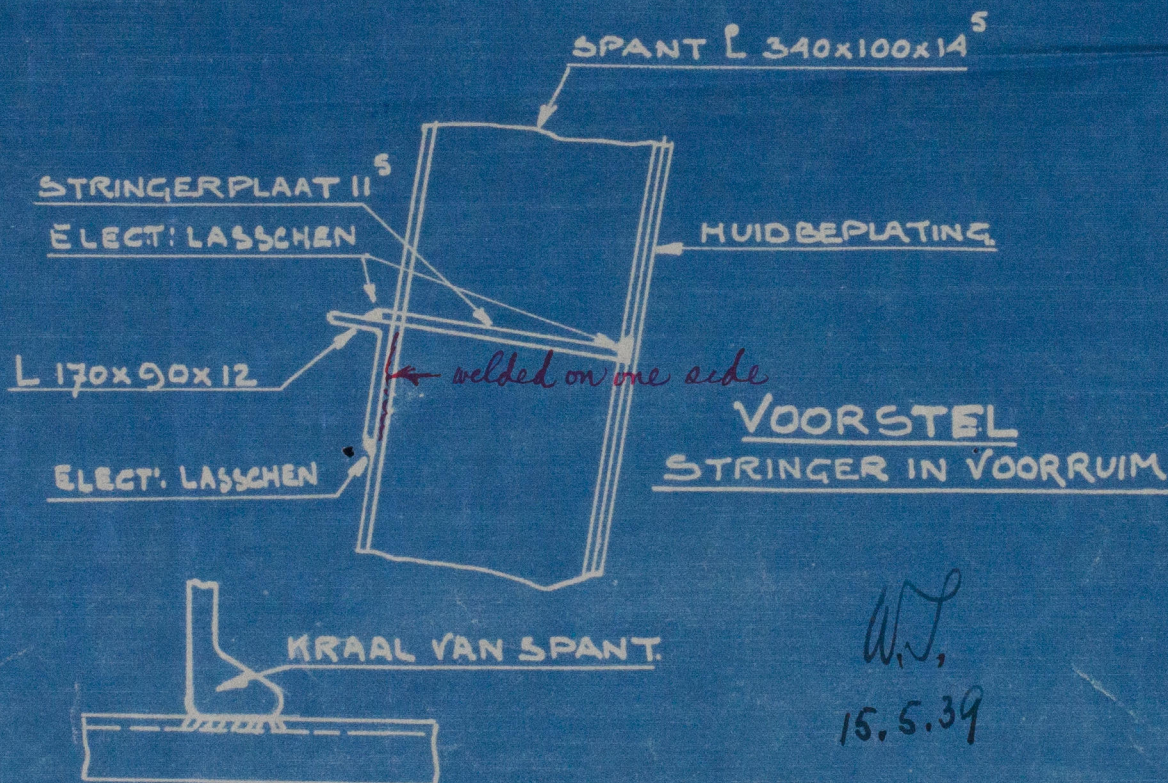


O.Nº. 83.

NEDERLANDSCHE DOK MAATSCHAPPIJ N.V.
AMSTERDAM.

"Tanker" now named "Norvsketank"
 Armo 15861-A

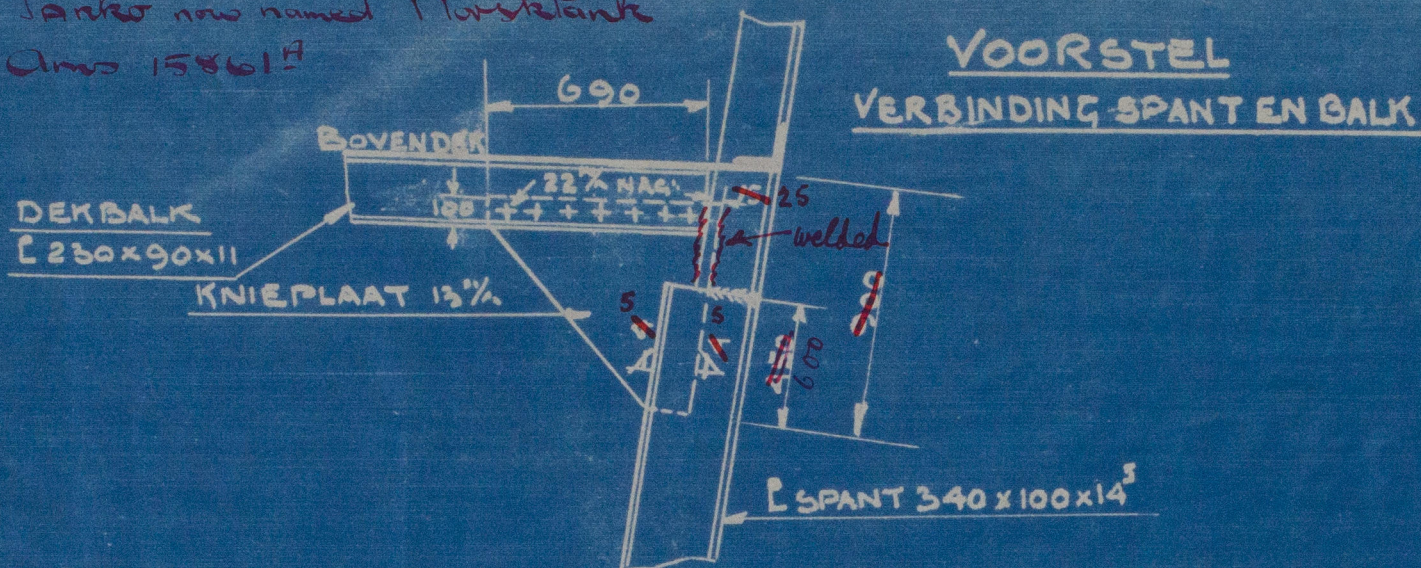

M.S. JAGUÁR

SCHAAL $\frac{1}{2}$ S- $\frac{1}{4}$

AFDEELING. S.
SCHETS. NO. 9

W1088 - 0159