



M.T.V. JAGUAR.



SECTION OF TRANSVERSE O.T. BULKHEAD
IN MAINTANK.

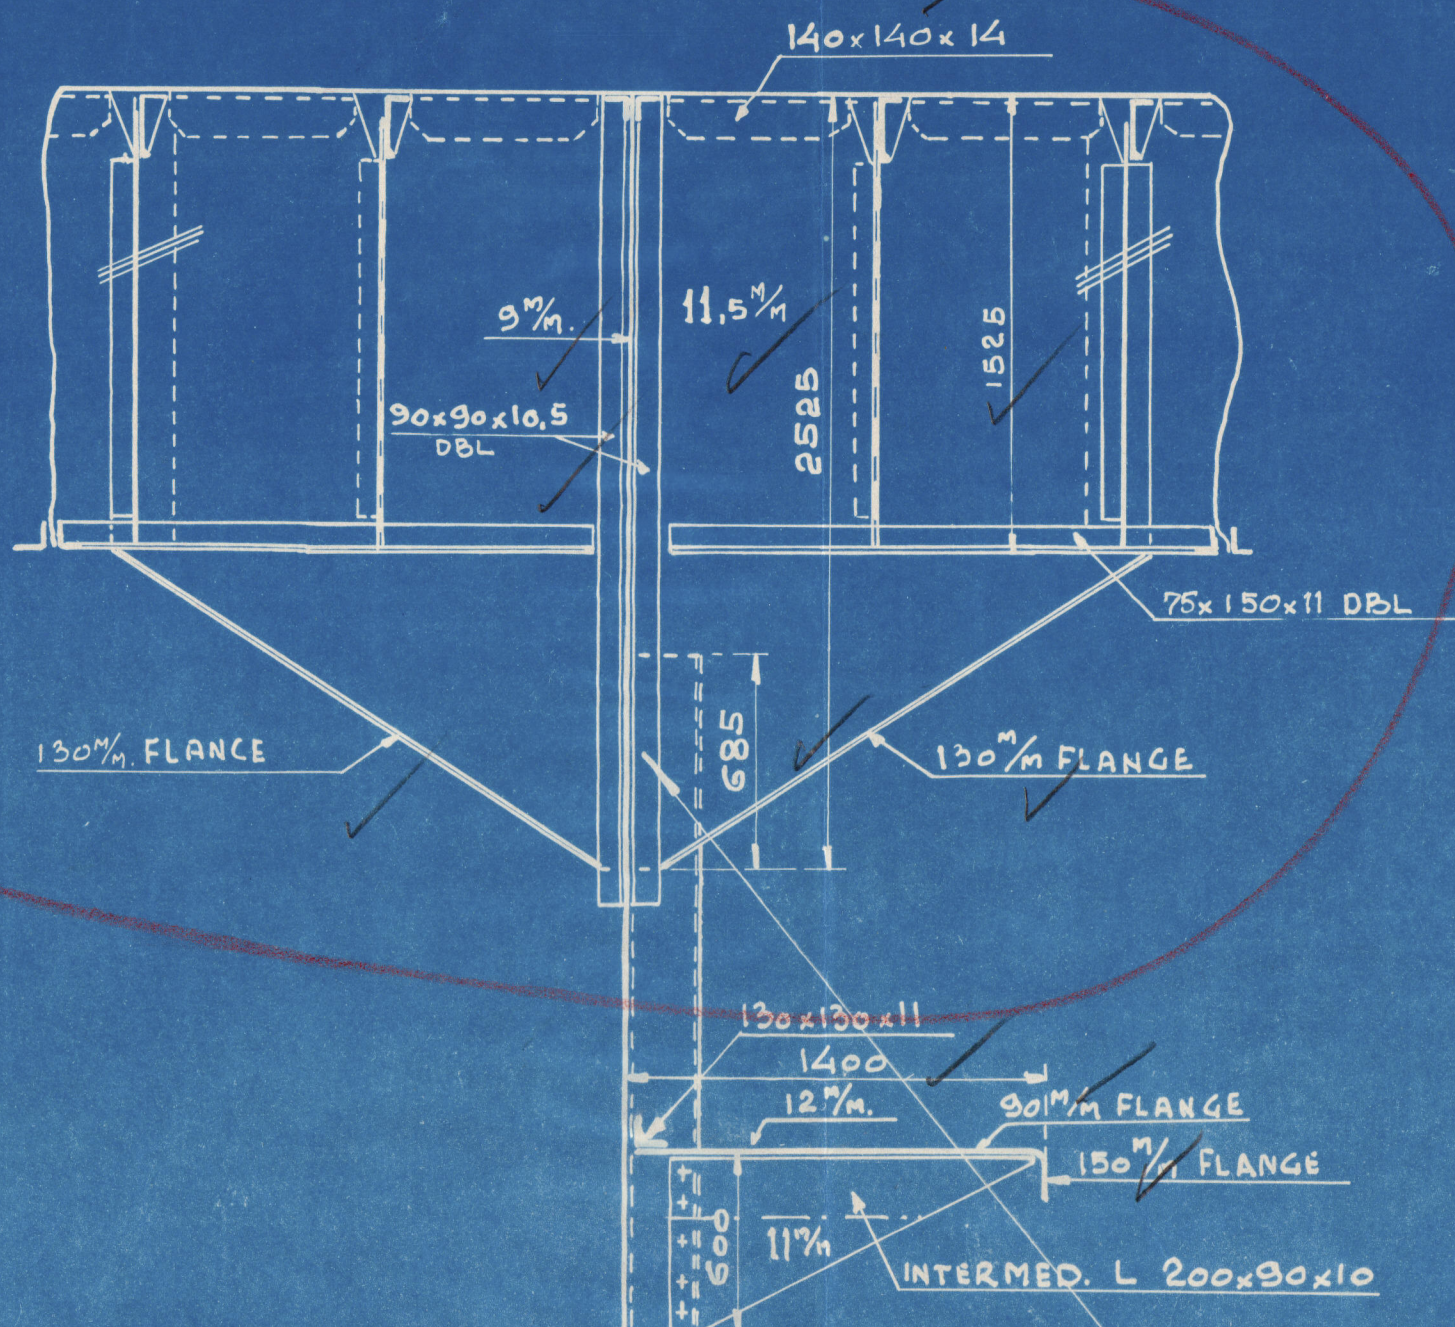


EXISTING

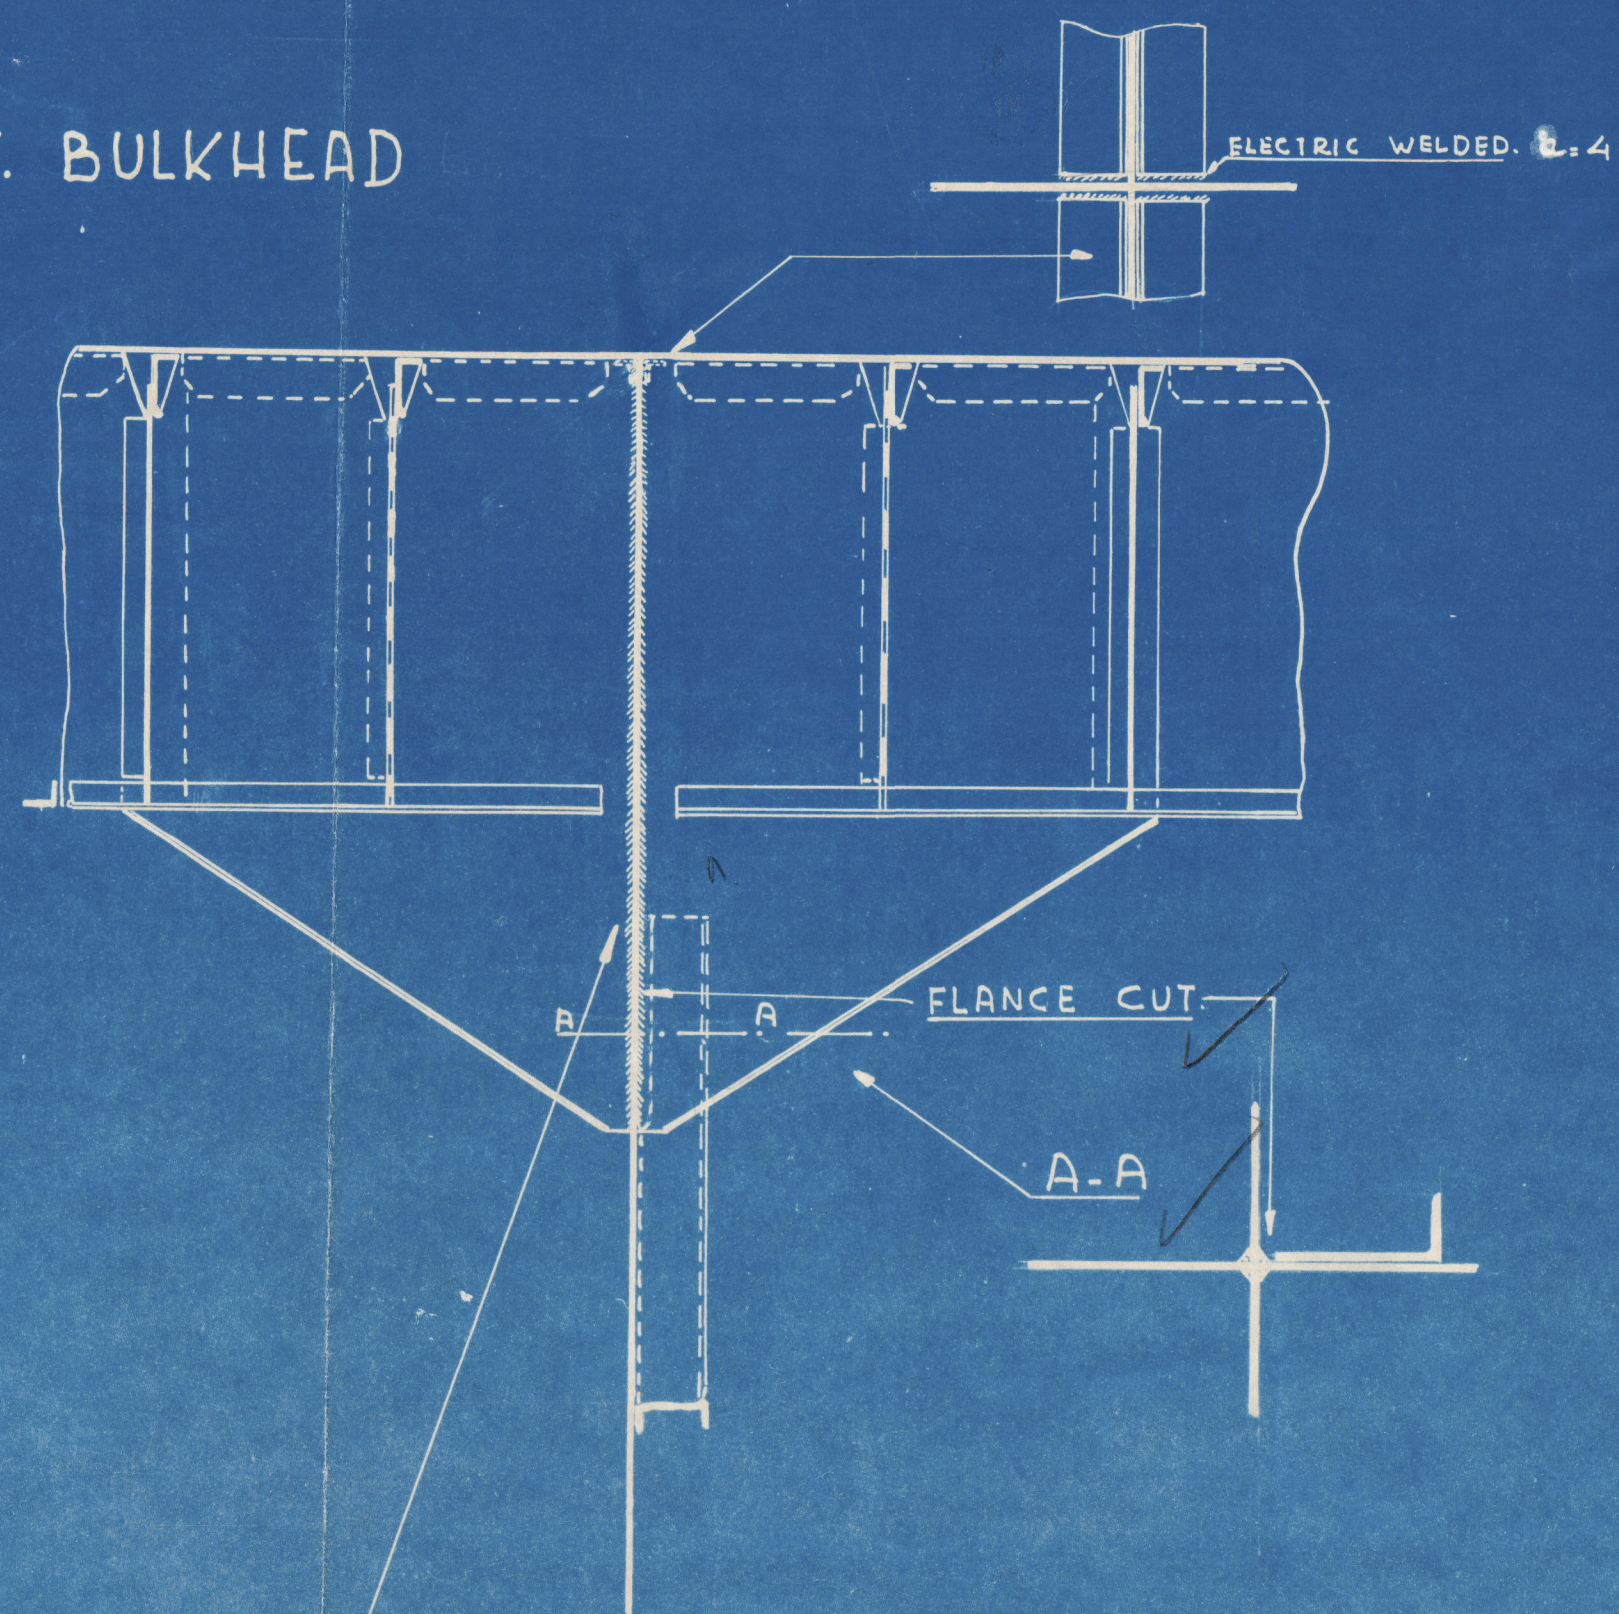



NEW PROPOSAL.

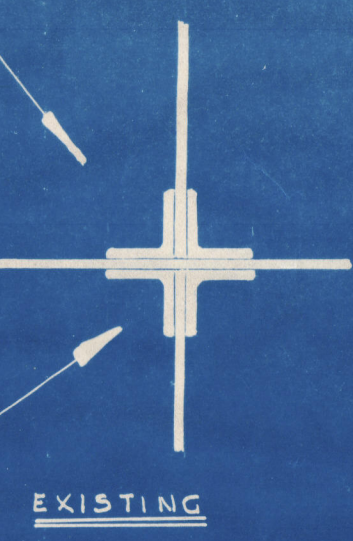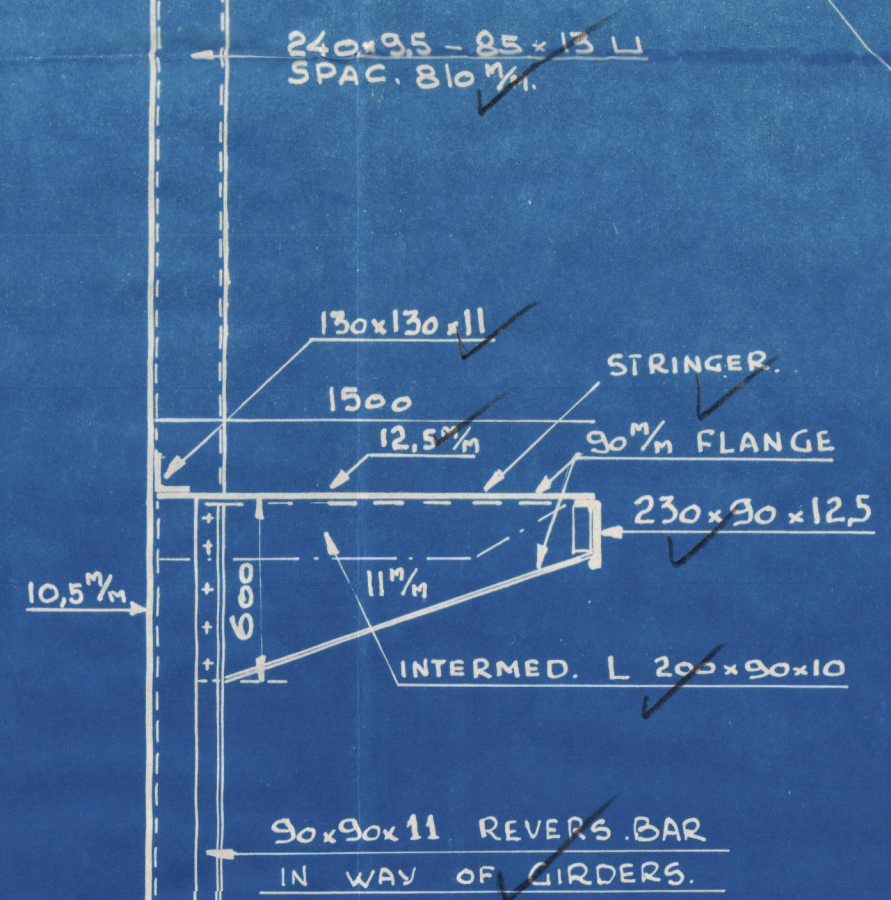

EXISTING

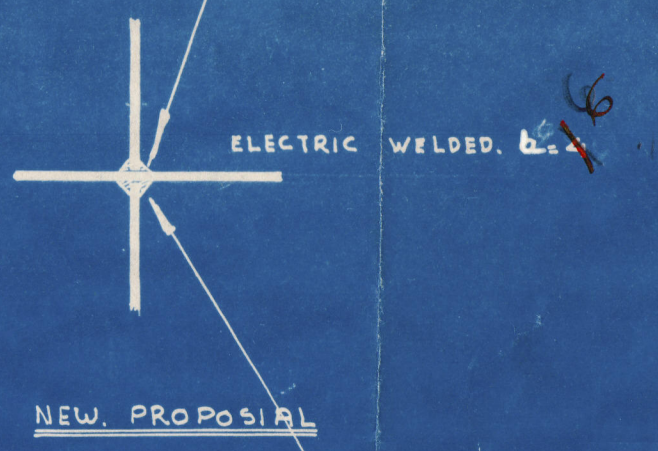


NEW PROPOSAL

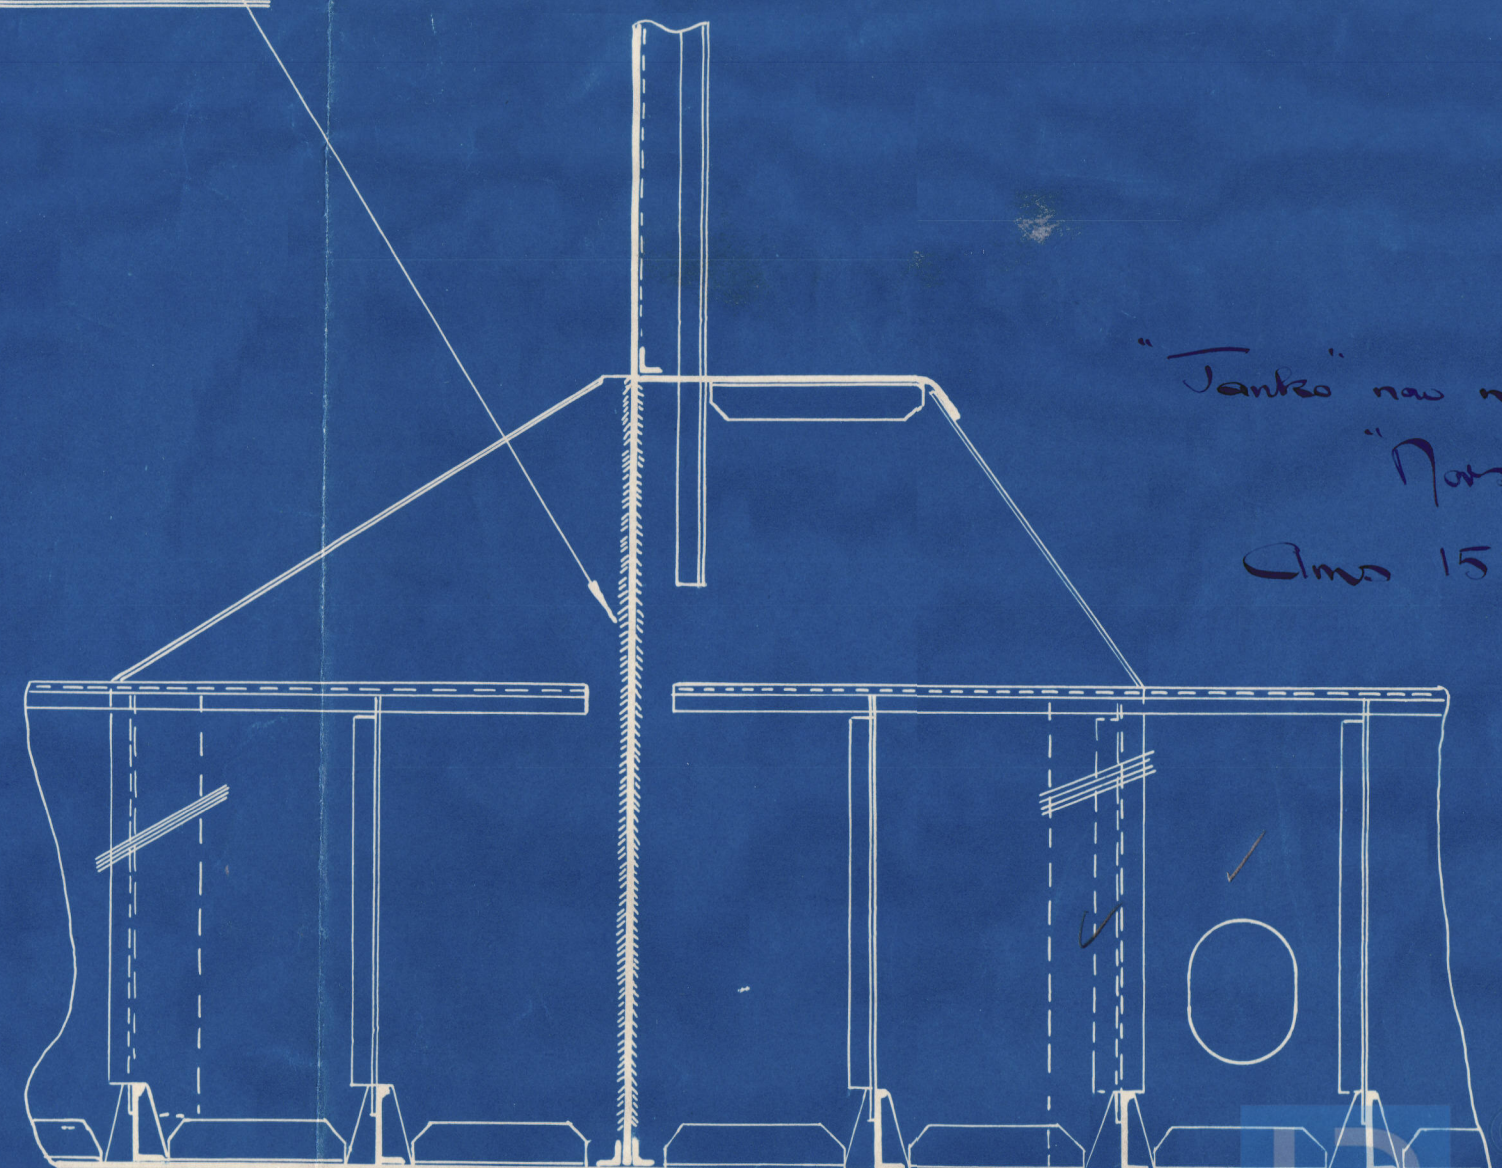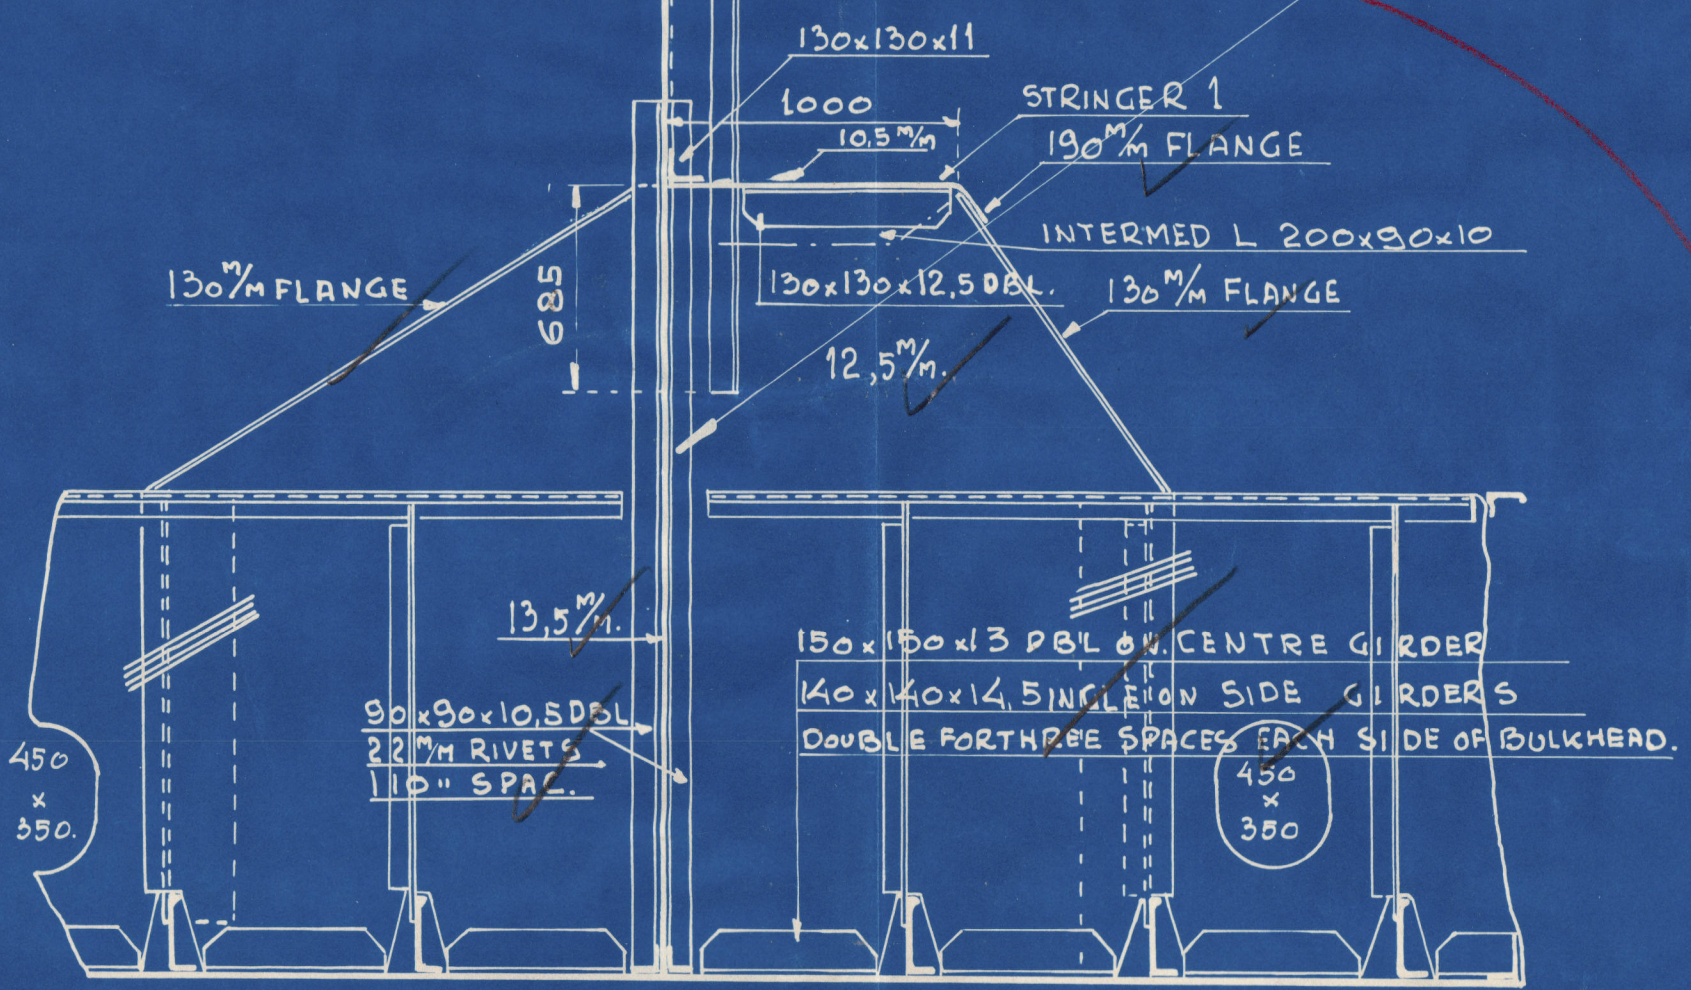

"Tank" now named
"Porsketank"
Cms 15861.2

W.T.
10.5.39

WELDED. ~~6-4~~ 66

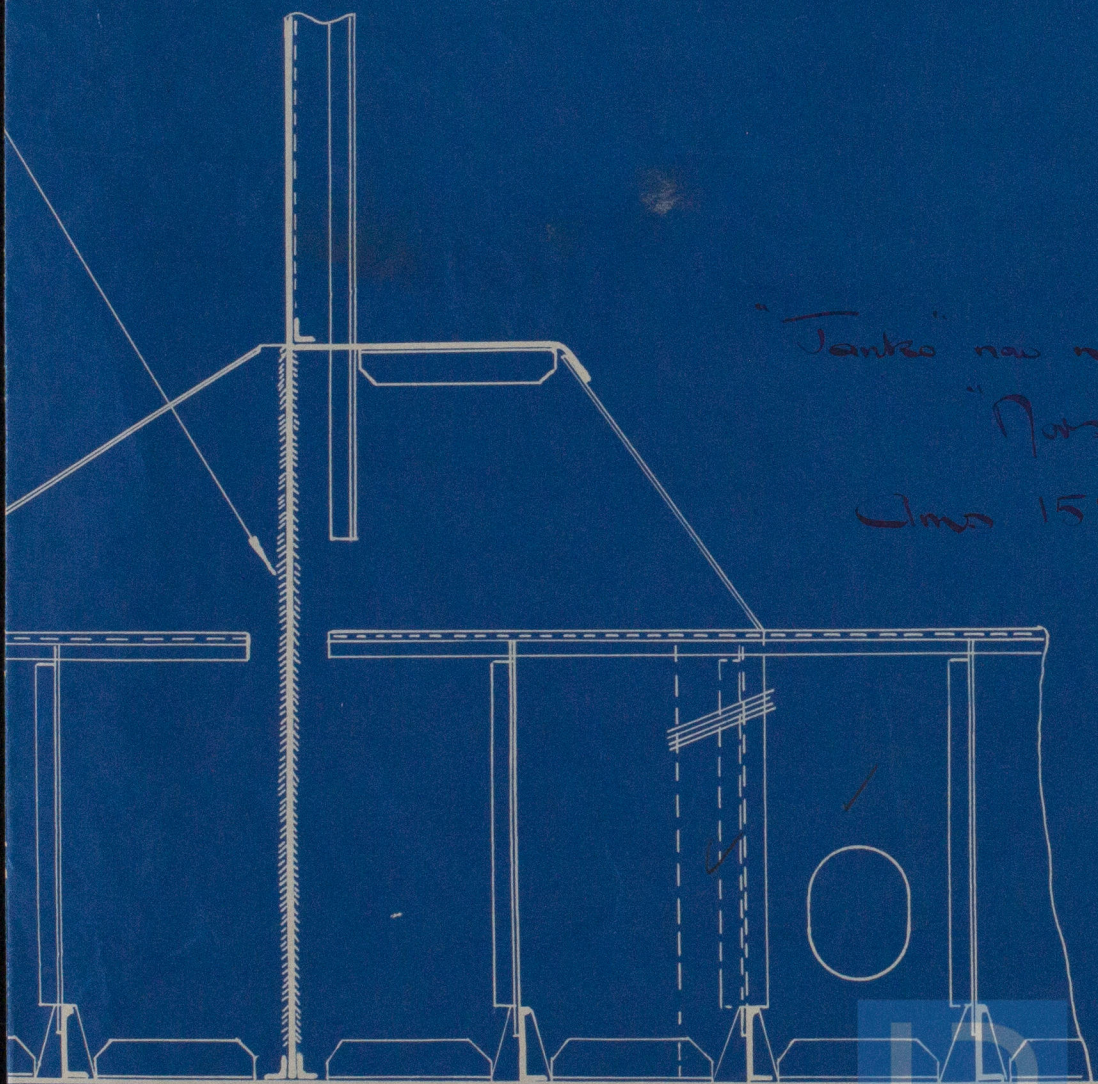

"Tanker" now named
"Norsk Tank"
Jms 15861^A

W.J.
10.5.39

O.N° 83001

W1088-0164