


M.T.V. JAGUAR



CONNECTION OF STRINGERS TO O.T. TRANSVERSE BULKHEAD

NEW PROPOSAL

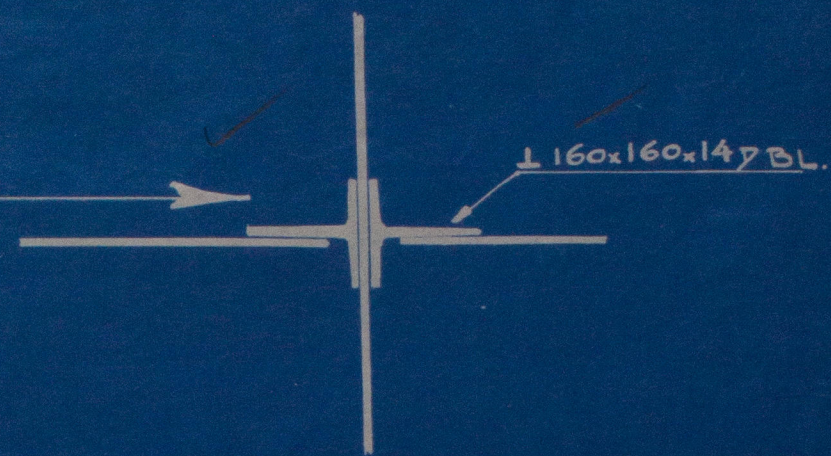

"Junks" now removed
"Pansklint"
Dmr 15.8.61

EXISTING.

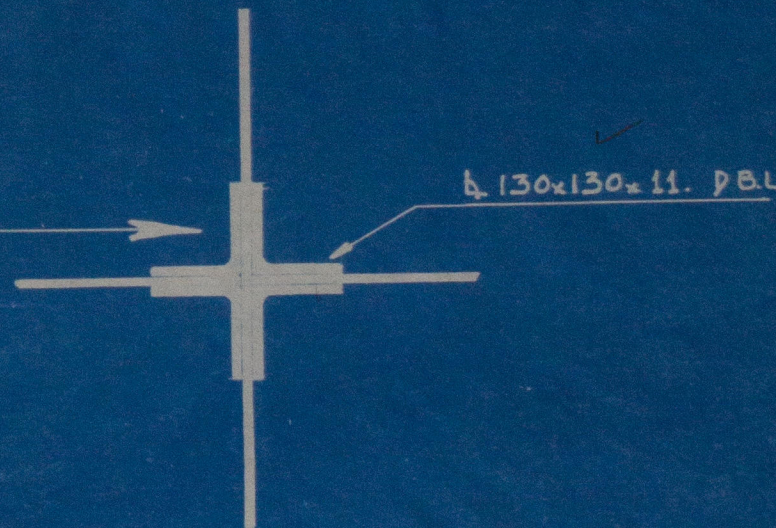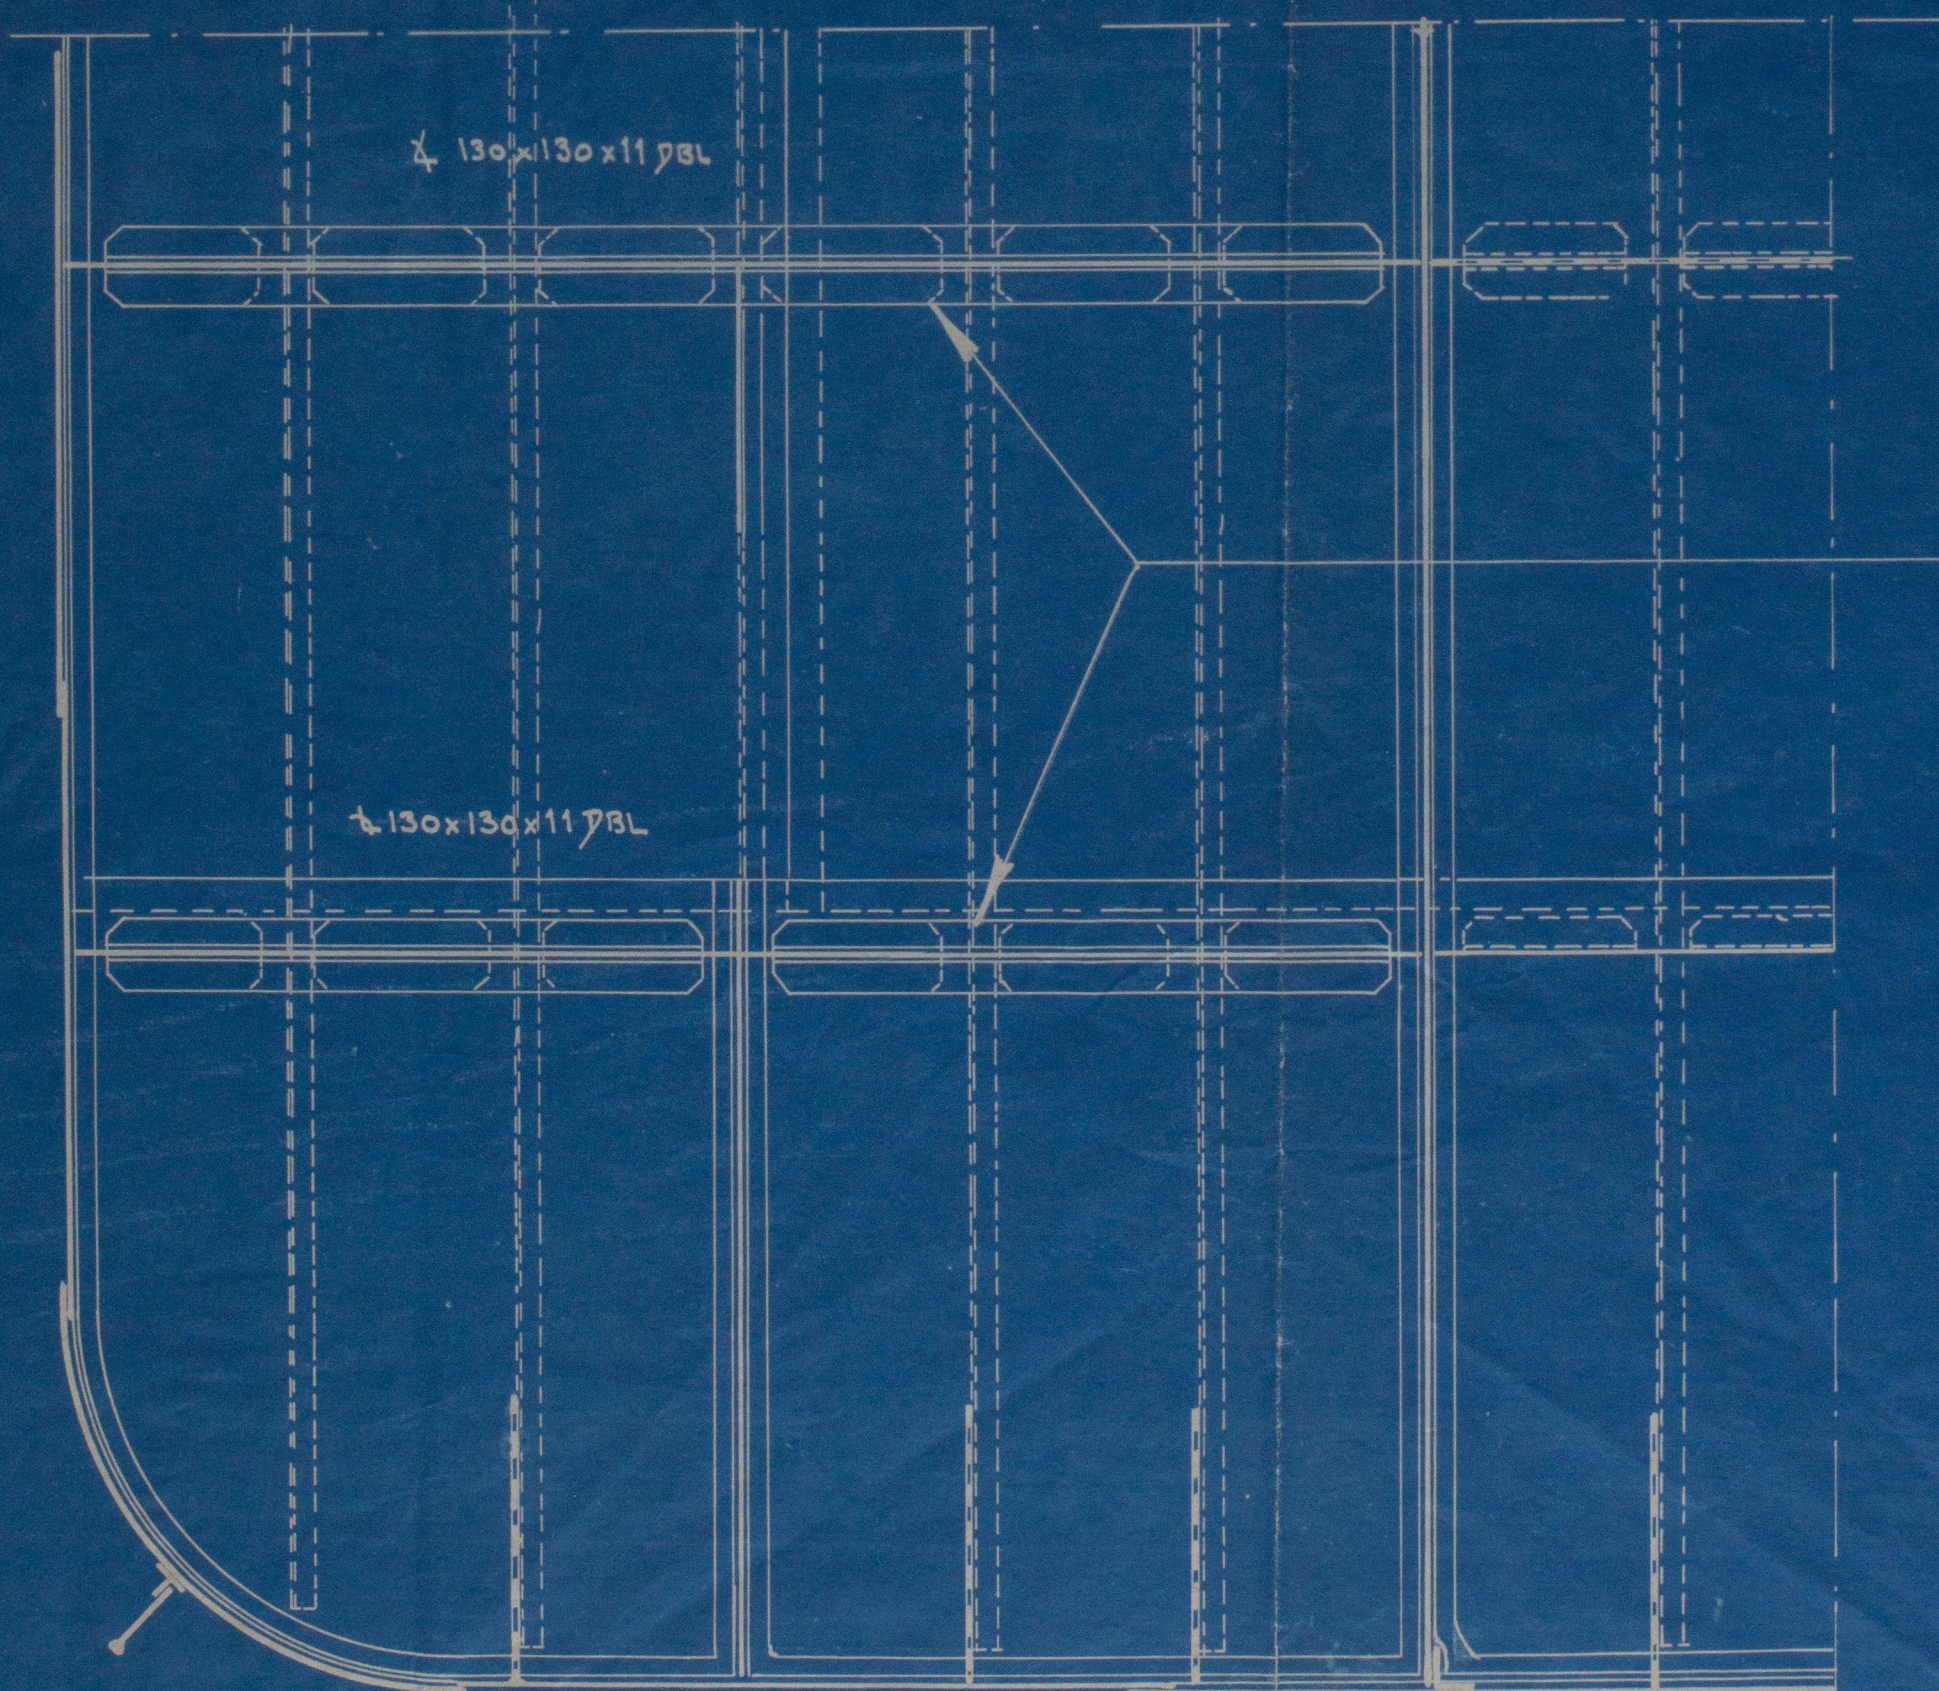

W.J.
12.5.39

VERB. STRINGERS AAN O.P. DWARSSCHOTTEN.

O.N. 83003.

