


GEN. DOWNS 865

CRANKSHAFT
8 CYLINDER FOUR STROKE CYCLE DIESEL ENGINE
CYLINDER DIAM = 550 mm
STROKE = 1000 mm

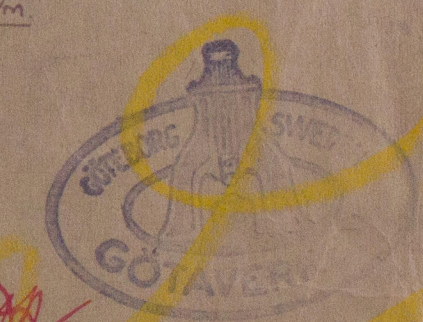

M/S 413-14
22.4.27


A.B. GÖTAVERKEN.	
CRANKSHAFT TO	
D.M. 550 M 8	
DRAWN BY: [Signature]	SCALE: 1:20
TRACED BY: [Signature]	DATE: 21.3.1927
CHECKED BY: [Signature]	



© 2020 Lloyd's Register Foundation

TOUGH
5-1
4-2
3-e
NOW
NORSK TANK

Nike

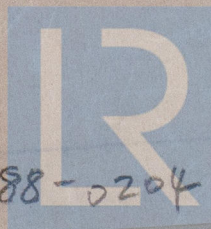

© 2020

Lloyd's Register
Foundation

W1088-0204

*53318