


\* Range not to exceed  
6.3 kg/ha<sup>2</sup>.

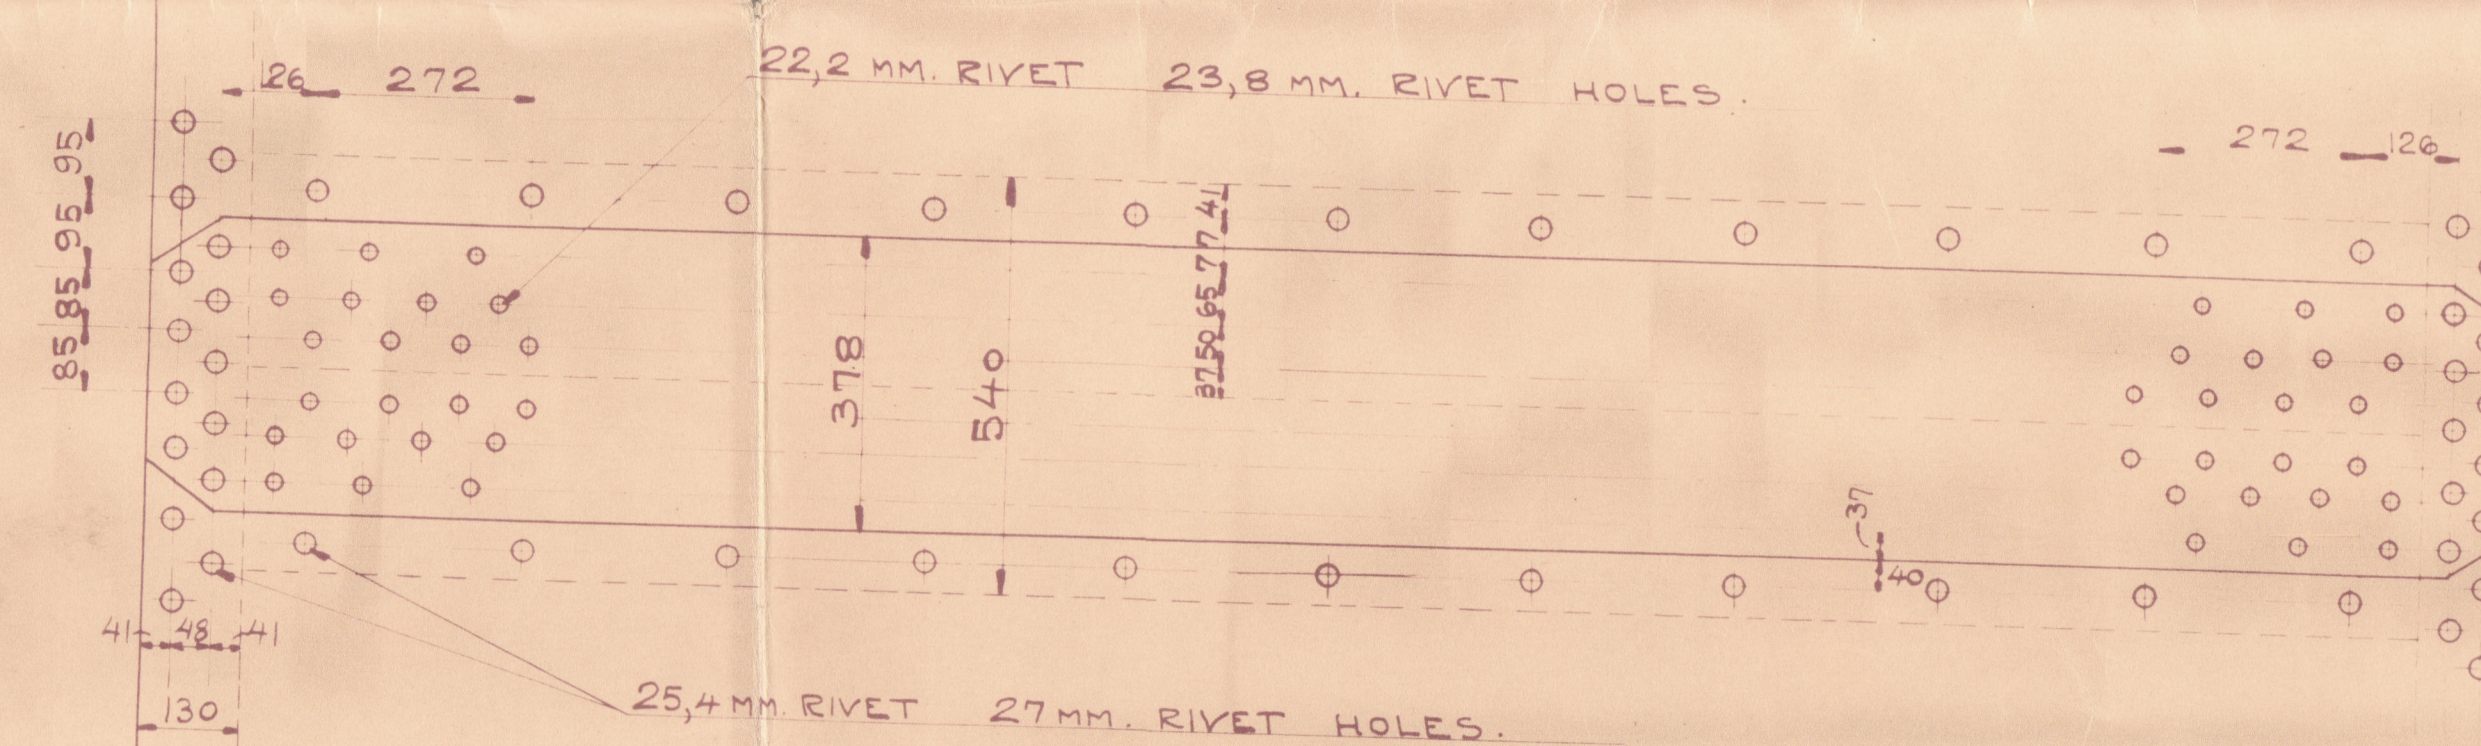

## BRITISH LLOYD'S RULES

AKTIEBOLAGET LINDHOLMEN-MOTALA GÖTEBORG.		SKA 111
<u>BOILER.</u>		UTK 20
GR. AV NR	GODK.AV MÅSKINKORTET DEN 15/6	

6 ST ÅNGPANNOR N<sup>o</sup> 2409-10-11-12-13-14. FÖR BEST. N<sup>o</sup> 426. DEN 15-6-27



~~GENERAL~~

~~865 708~~

SS. Nike.

TANKO

Donkey Boilers

to be constructed by:-

AB. Lindholmen - Motala, Gothenburg.


for

NOW

NORSK TANKS

AB. Gotaverkens M/S No 413-14 & 415.

Nike & Glarona

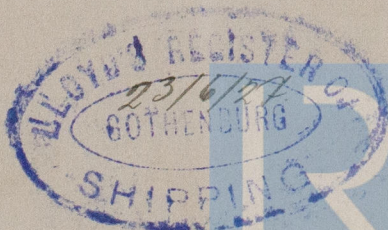

© 2020

Lloyd's Register  
Foundation

W1088-0205