

2 DIESEL MOTORS, FOUR CYCLE, SINGLE ACTING
WITH 8 CYLINDERS

DIAMETER OF CYLINDERS = 550 MM
LENGTH OF STROKE = 1000
DIAMETER OF PROPELLERS = 3550 MM
REVOLUTIONS PER MIN. = 154
W.C. OF 8 BALANCE WEIGHTS = 6600 KG-MT
TURNING WHEEL = 1000

JAMFOR FOLIANDE RITNINGAR

* PROPELLER - MELLAN 3 TRYCKAKLAR
* PROPELLERHVLJA
* 43121 TRYCKLACER (SAMMANST)
* 45115 BOTTENPLATA FOR DI
* 41757 BARLAGE
* PROPELLER
* 02027 SAXNINGSHJUL

NORSK TANK

AB GÖTAVERKEN

SHAFTING - ARRANGEMENT

RITAD AV W. Q.
KALK AV W. Q.
GRANSK AV W. Q.

SKALA 1:200
DATUM 2-5-27

UTSÄR	LEVE	ANV
BEST	DATUM	RANSO
NZ	2884	2885
28	413	2886
28	414	2887

Shipping Arrangement.

M/S 413-14.

JANKO

Aktiebolaget Godaverken,

NOW


NORSK TANK:

Gothenburg

"Nike"

~~GEN. DOCK NO~~

865

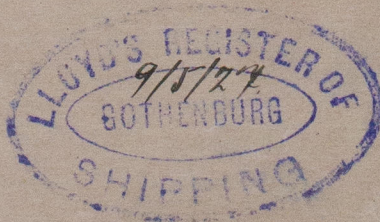

© 2020

Lloyd's Register
Foundation

W1088-0206