





30x30x10.5 SINGLE

13.5%

30x30x10.5 DOUBLE

30x130x11


13.5%

30x30x10.5 DOUBLE

30x30x10.5 DOUBLE

O.T. TRANSVERSE BULKHEAD

*Office* *Now*  
**NORSK TANK**  
**GEN BOX NO 865**

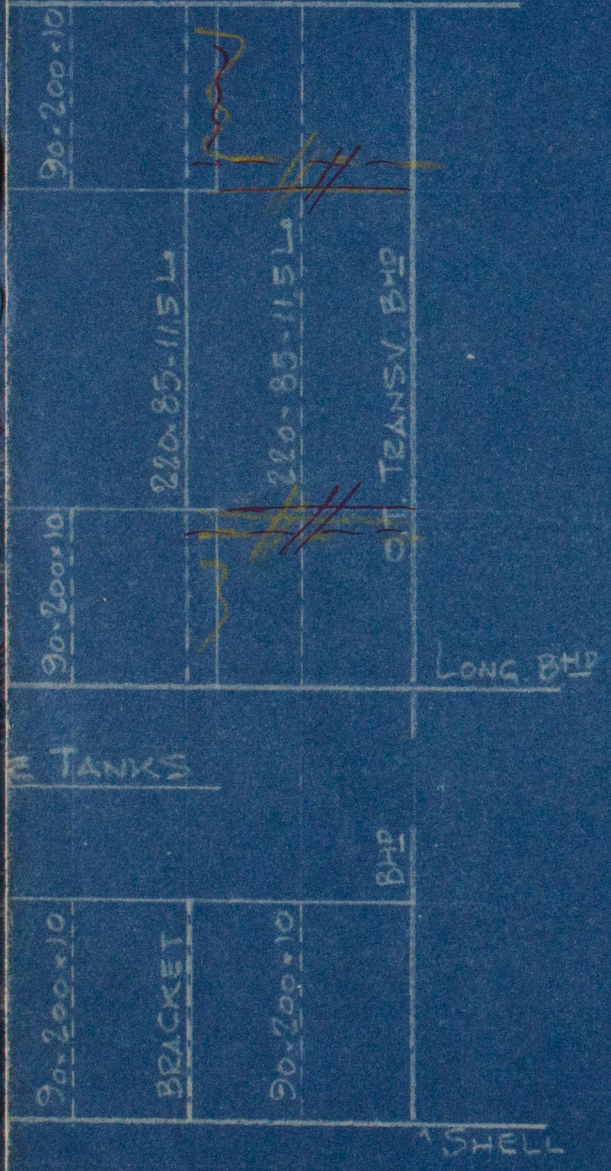

AKTIEBOLAGET GÖTAVERKEN

M/S 413-14

ALTERNATIVE ARRANGEMENT OF  
TRANSVERSE BULKHEADS AND LONGITUDINAL  
STRINGERS AND GIRDERS.

SUPPLEMENT TO DRAWING #53282 MIDSH. SECT.

RITAD AV *Jon.*


SKALA 1:25 & 1:50

KALKER AV

DATUM 8-4-1927

GRANSKAD *Jon.*

*W.S.*  
21.4.27

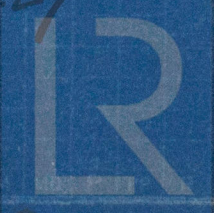

#53282

#53482