


*Office copy
not approved*

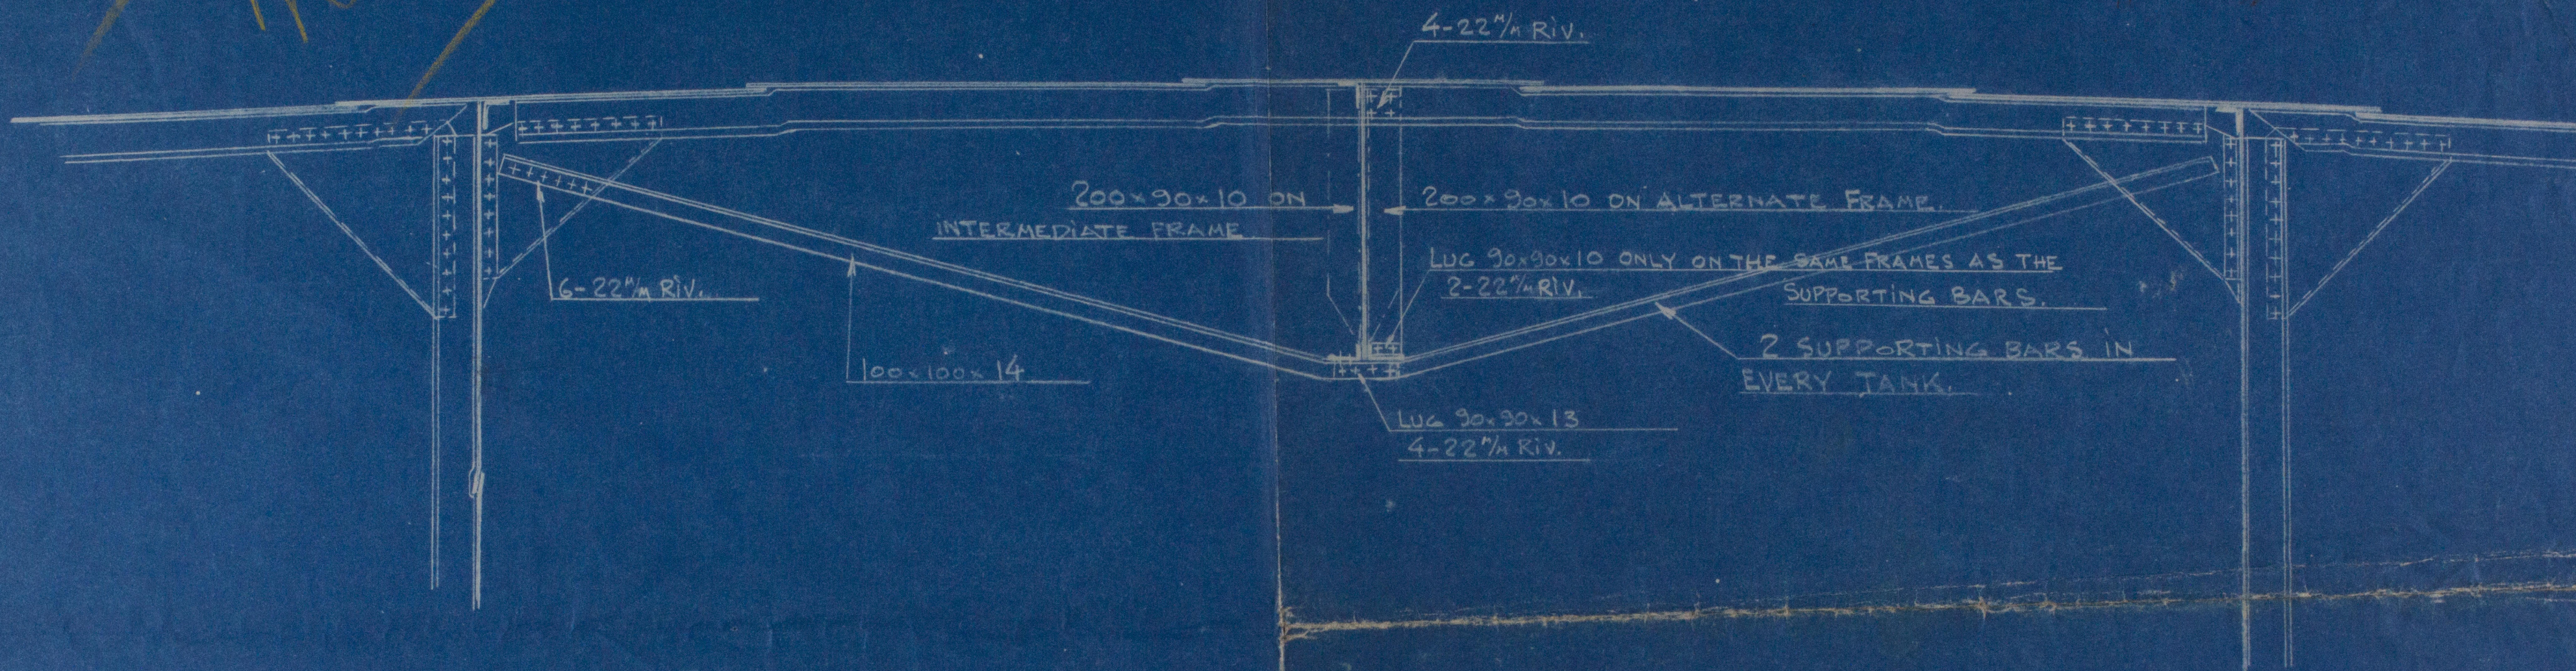

*Plan handed in by Mr Selden 17/5/27
Turner proposal.*

M/S 413-14.

**NOW
"NORSK TANK"**

PROPOSED TRANSVERSE SUPPORTING OF
DECK GIRDER.

SCALE 1:25



12-5-27

Rgr.

*Not considered
satisfactory, but Mr Selden
did not want official
decision.*