



Office Copy

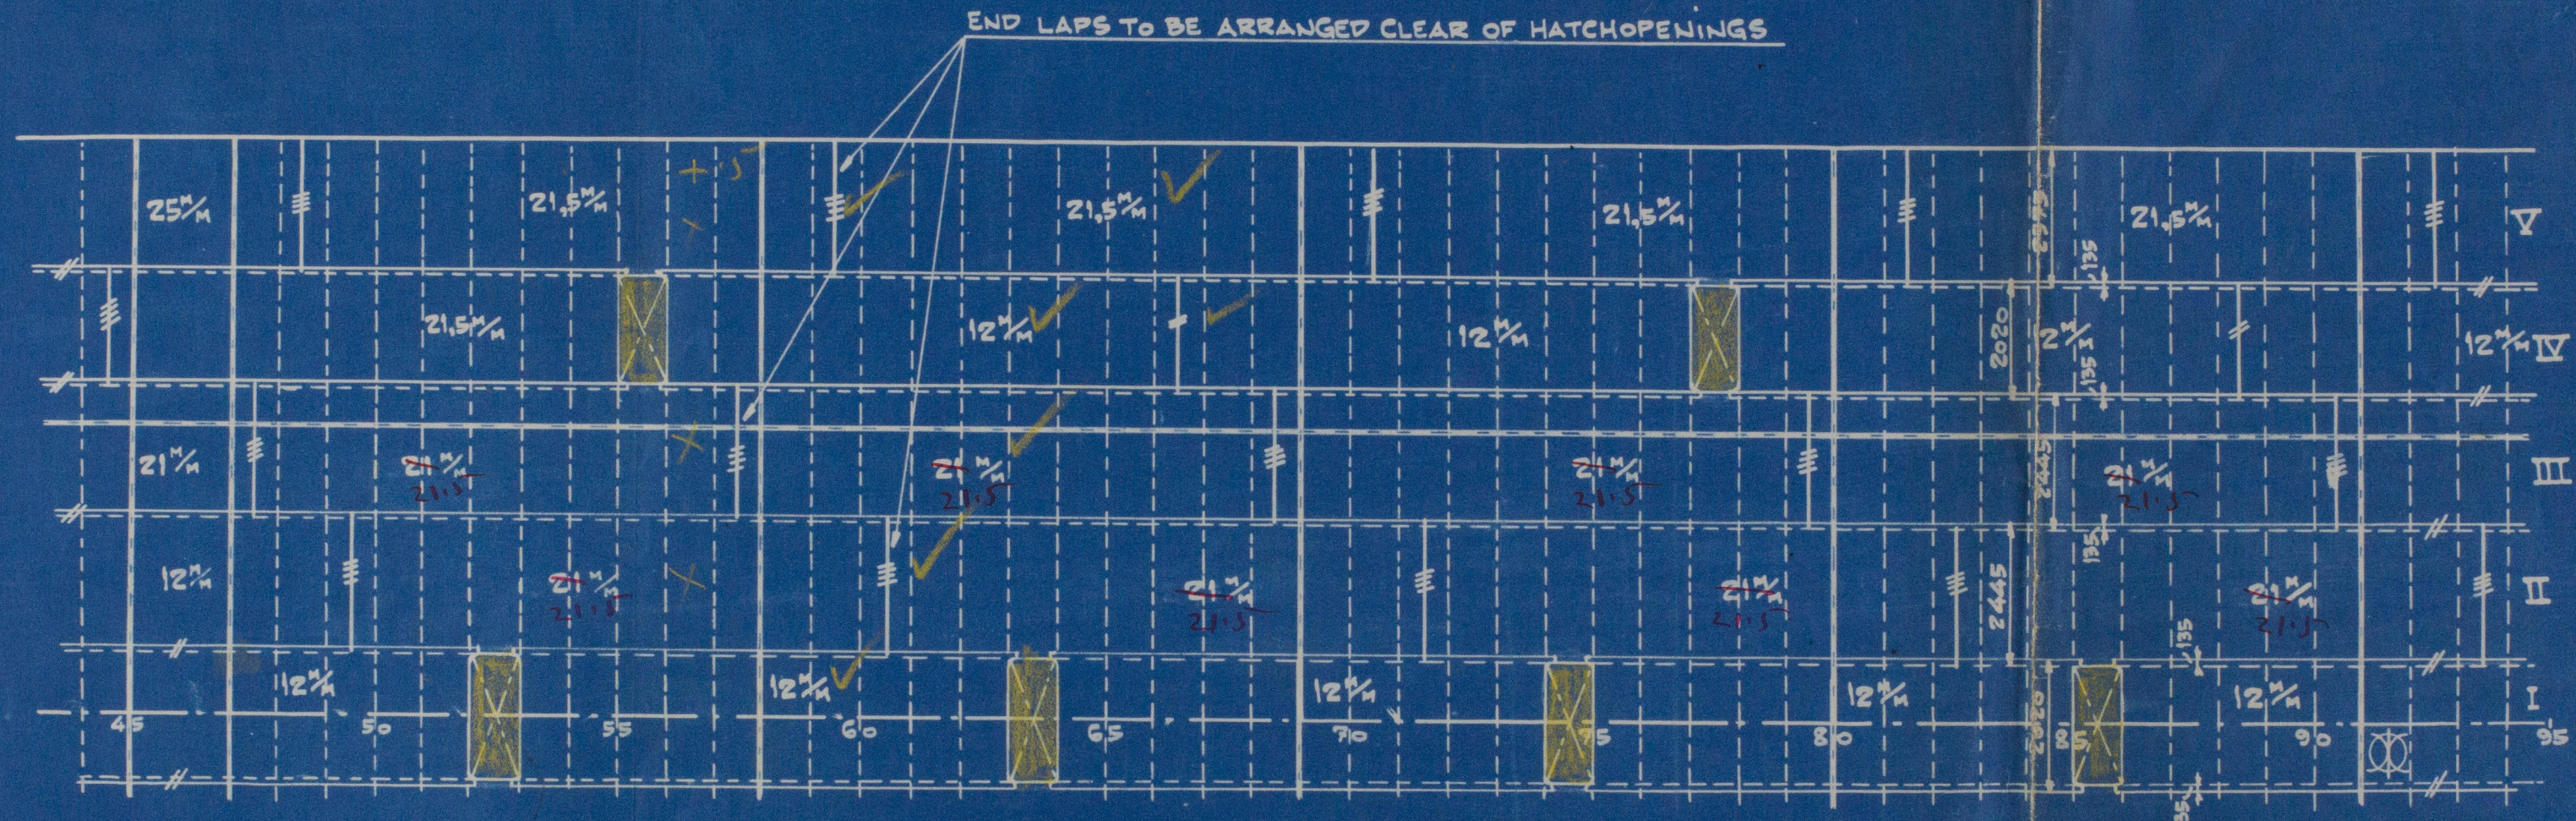

PLAN OF UPPER DECK

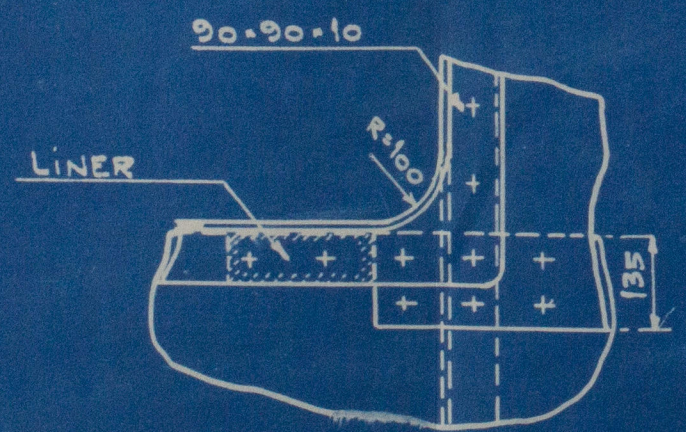

DETAIL OF HATCH CORNER


PROPOSED ARRANGEMENT
OF OIL HATCHES IN UPPER DECK

SKALA: 1:100 1-10



GÖTEBORG DEN 12/4 27

NOW
"NORSK TANK"

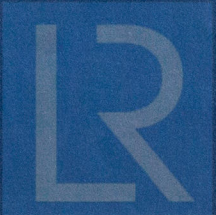

1028-0215