

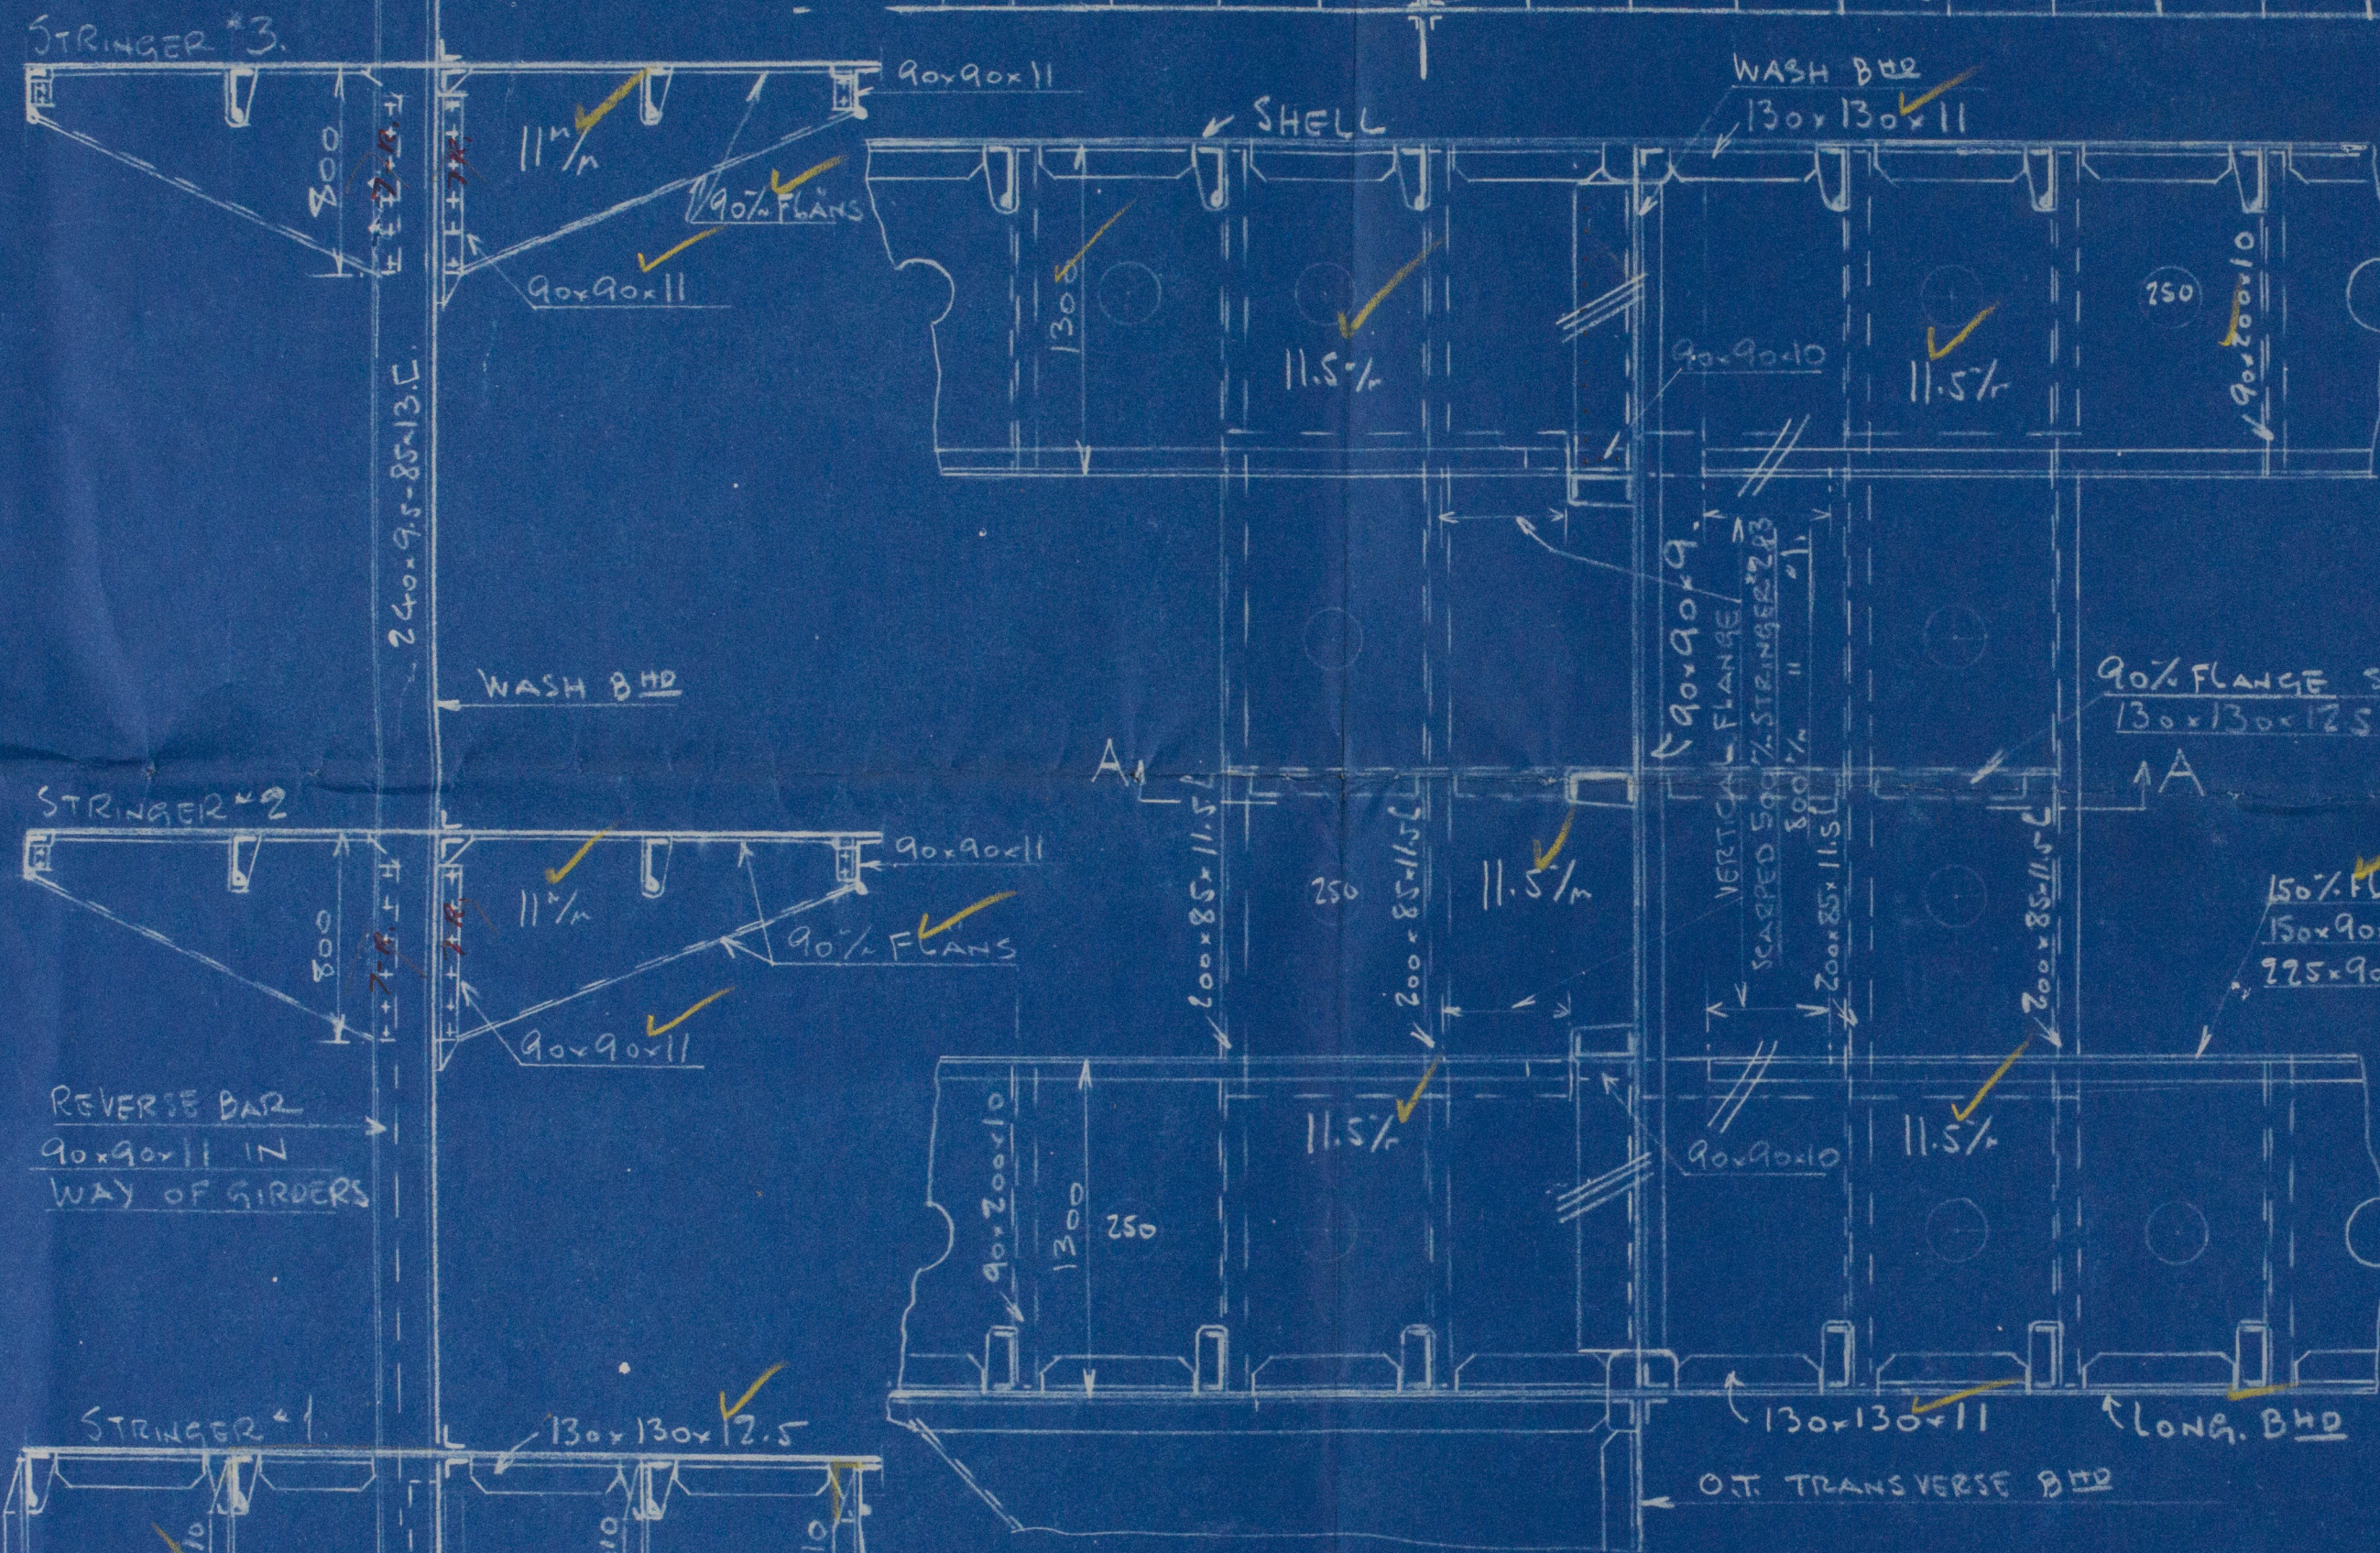


Off the Copy

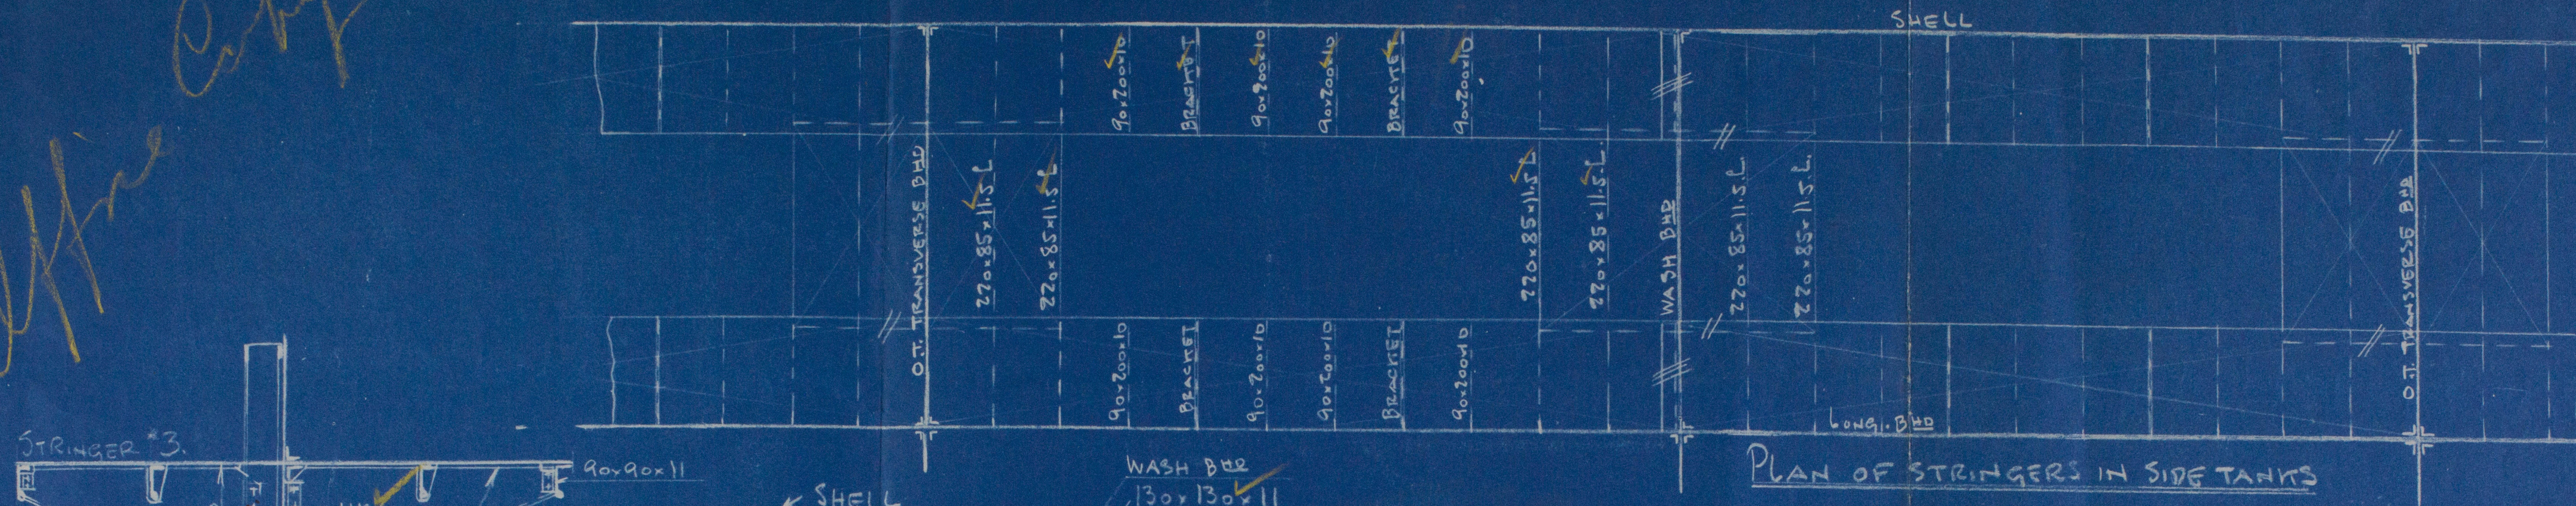

PLAN OF STRINGER "2"  
STRINGERS "1" & "3" SIMILAR

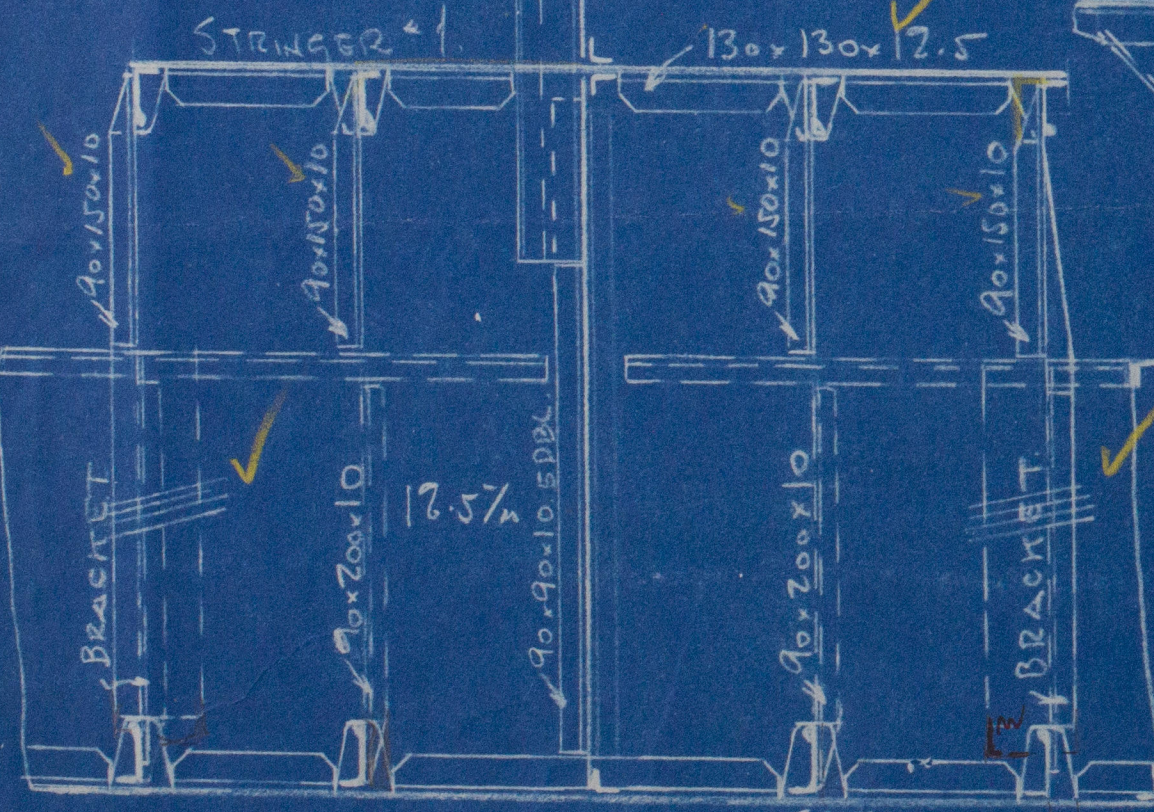

SECTION A-A

PLAN OF STRINGERS IN SIDE TANKS

M/5413-14  
ARRANGEMENT OF STRINGERS  
IN SIDE TANKS IN WAY OF WASH BHD'S  
SUPPLEMENT TO DRAWING # 53482  
SCALE 1/25 & 1/50.



6.5.27



53641

53641



Gatavirkin 4/13 & 14


Side Stingers in way  
of wash bulkheads

NOW

'NORSK TANK'

Office Copy

*"Mike"*  
GEN. BOX NO. 865

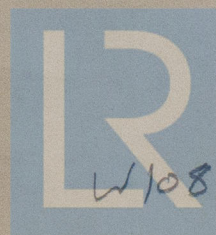

© 2020

Lloyd's Register  
Foundation

W1088-0216