

13.4.07.
20.4.07.


S. N^o 404.


MIDSHIP SECTION

DIMENSIONS AS PER RULE

LENGTH 368.00
BREADTH 49.79
DEPTH AT CENTRE 28.00
MOULDED 27.00
CLASS 100 A.1. 3. 200. RULE SPECIAL SURVEY

JOHN READHEAD & SONS,
SHIPBUILDERS,
SOUTH SHIELDS.

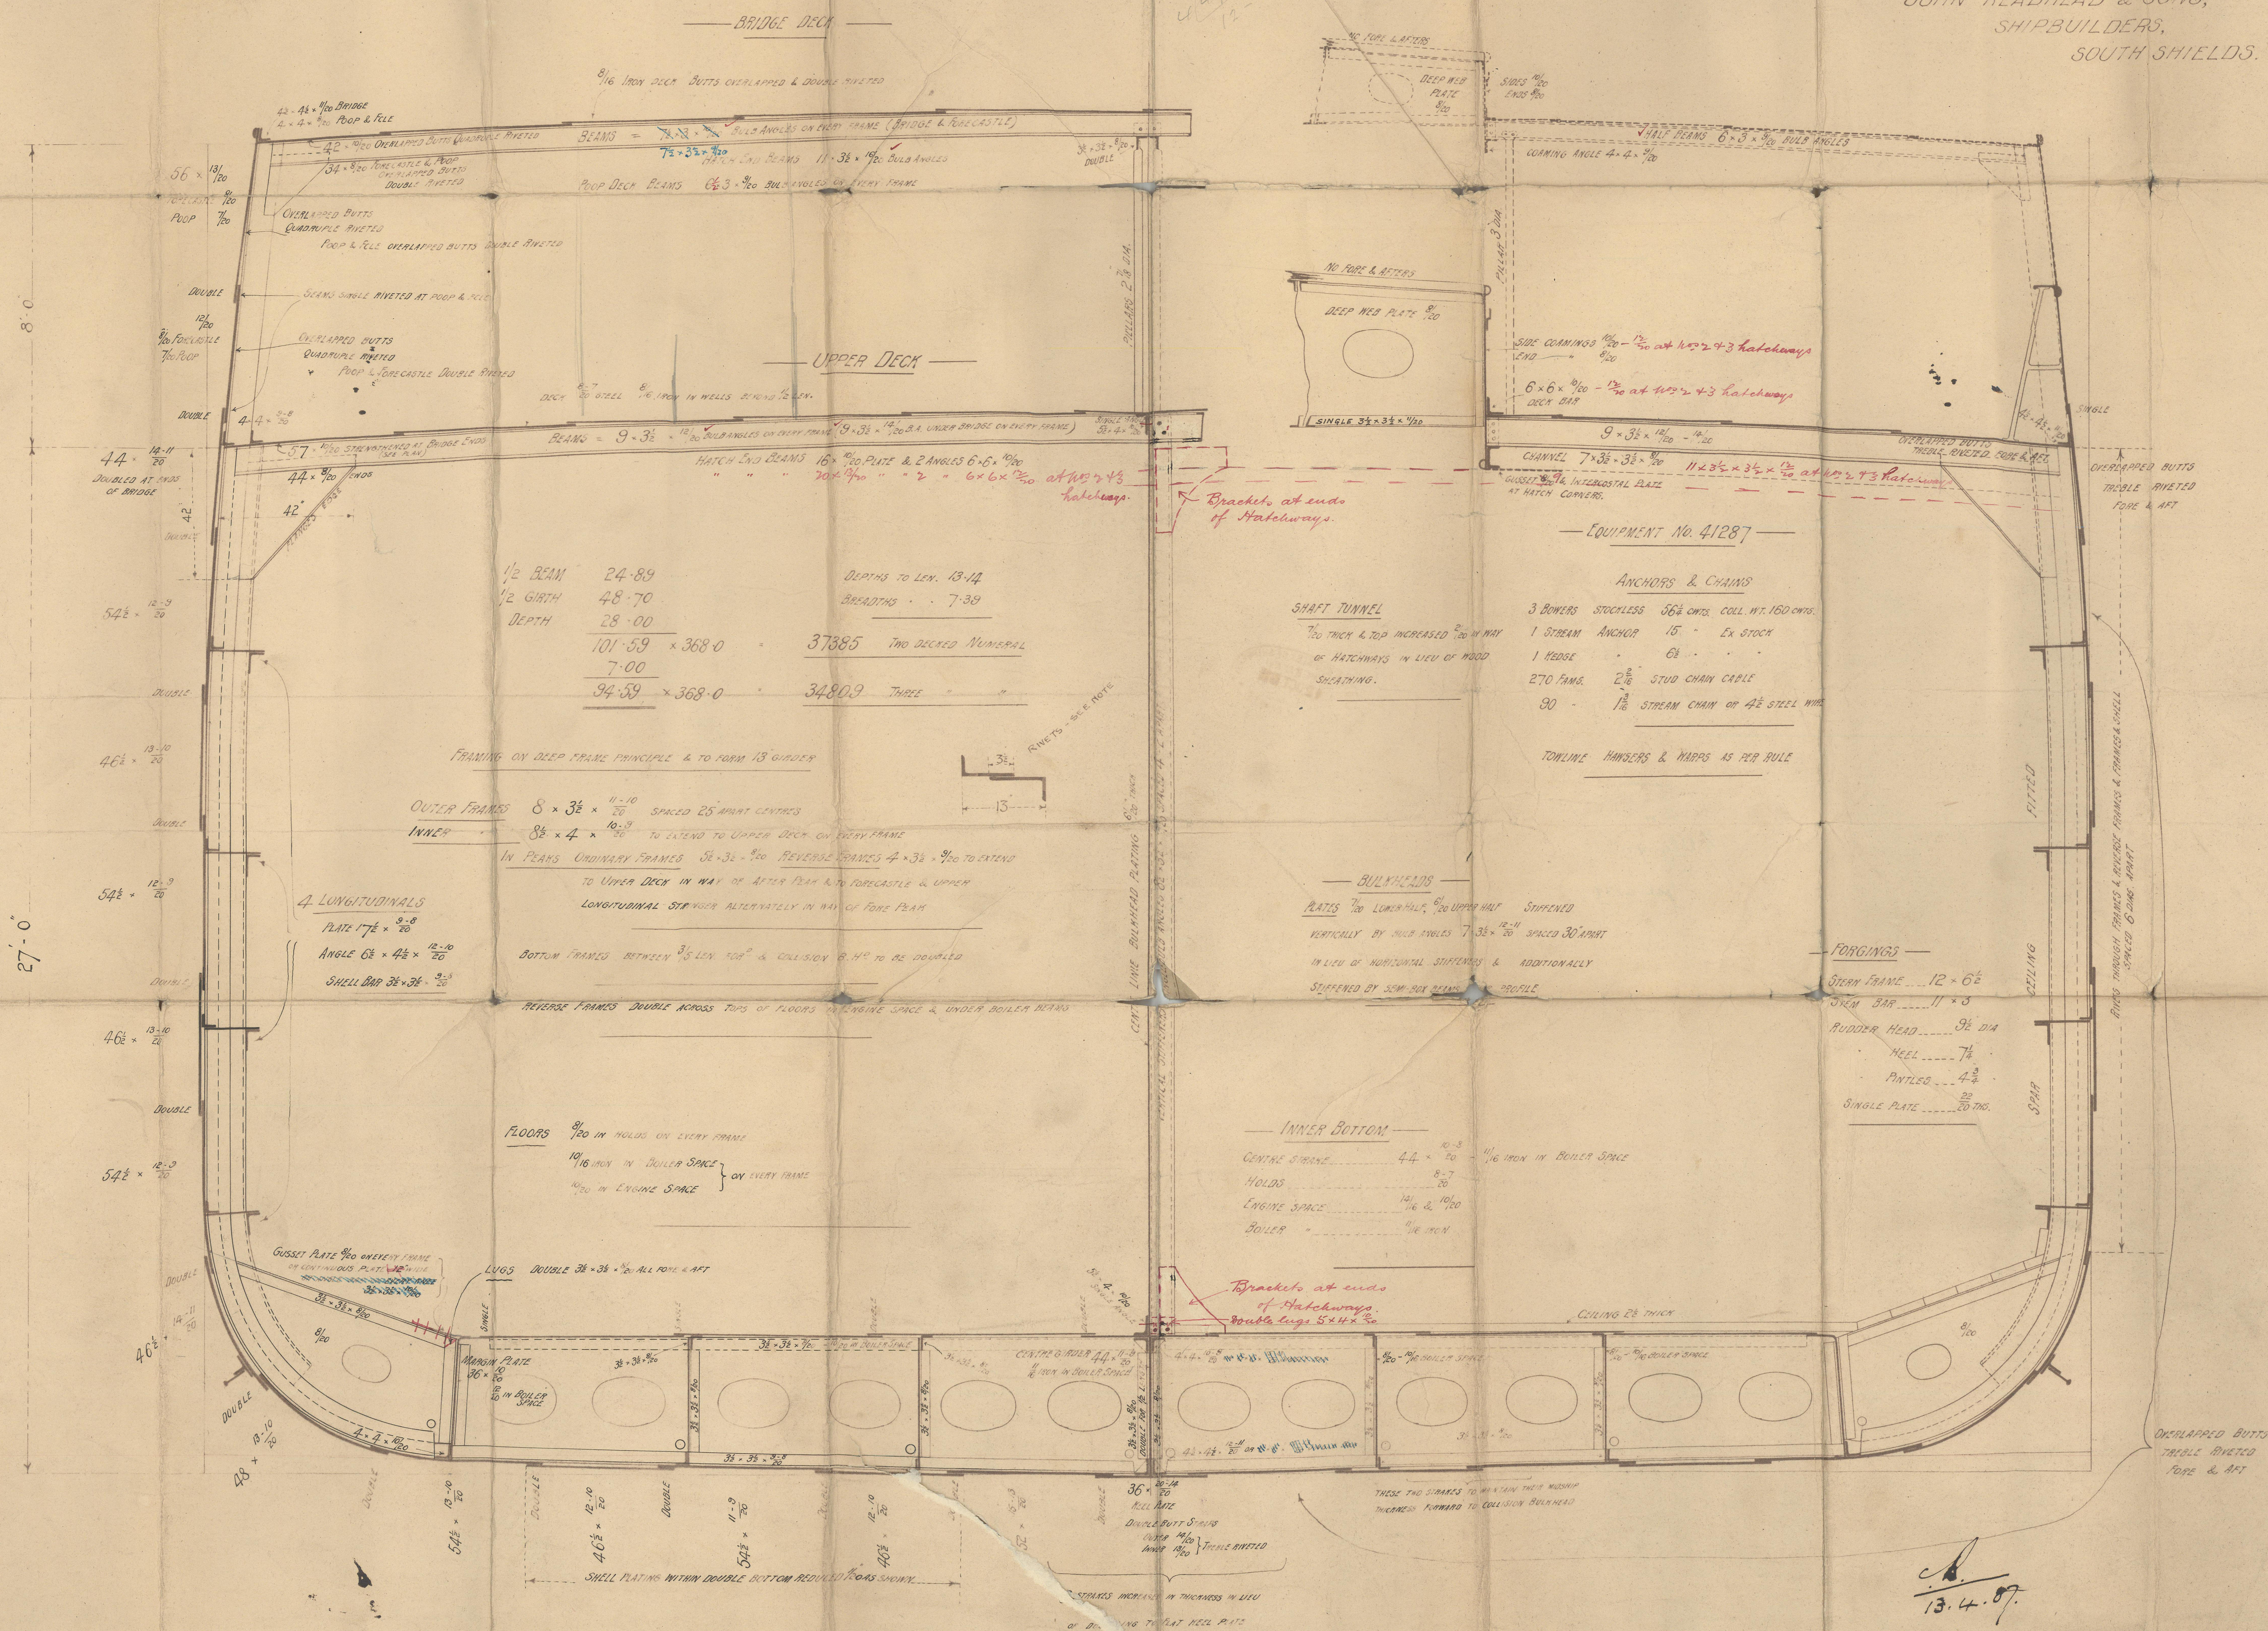

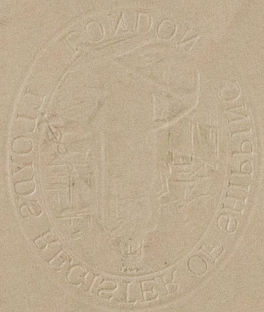

1.
3-5th
T 14
56

W 109 - 0001



© 2020

Lloyd's Register
Foundation


J Readhead & Sons

$\frac{5}{s}$ 404


Midship Section

OLYMPIC

S.S. HARPORT EX

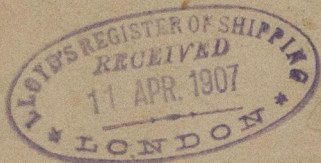

Steel
58 13
Mans.
"Dayton"

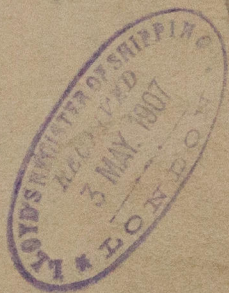

S.S. Harport

Newcastle Report


SP^o 53893

n. n.

$\frac{7}{s}$ Olympic

Gal 4137.

W/109-0001

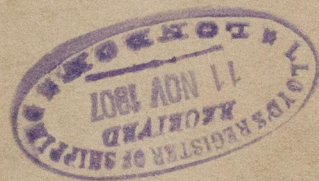

© 2020

Lloyd's Register
Foundation