



27.6.12
1.7.12
9.8.12
16.8.12

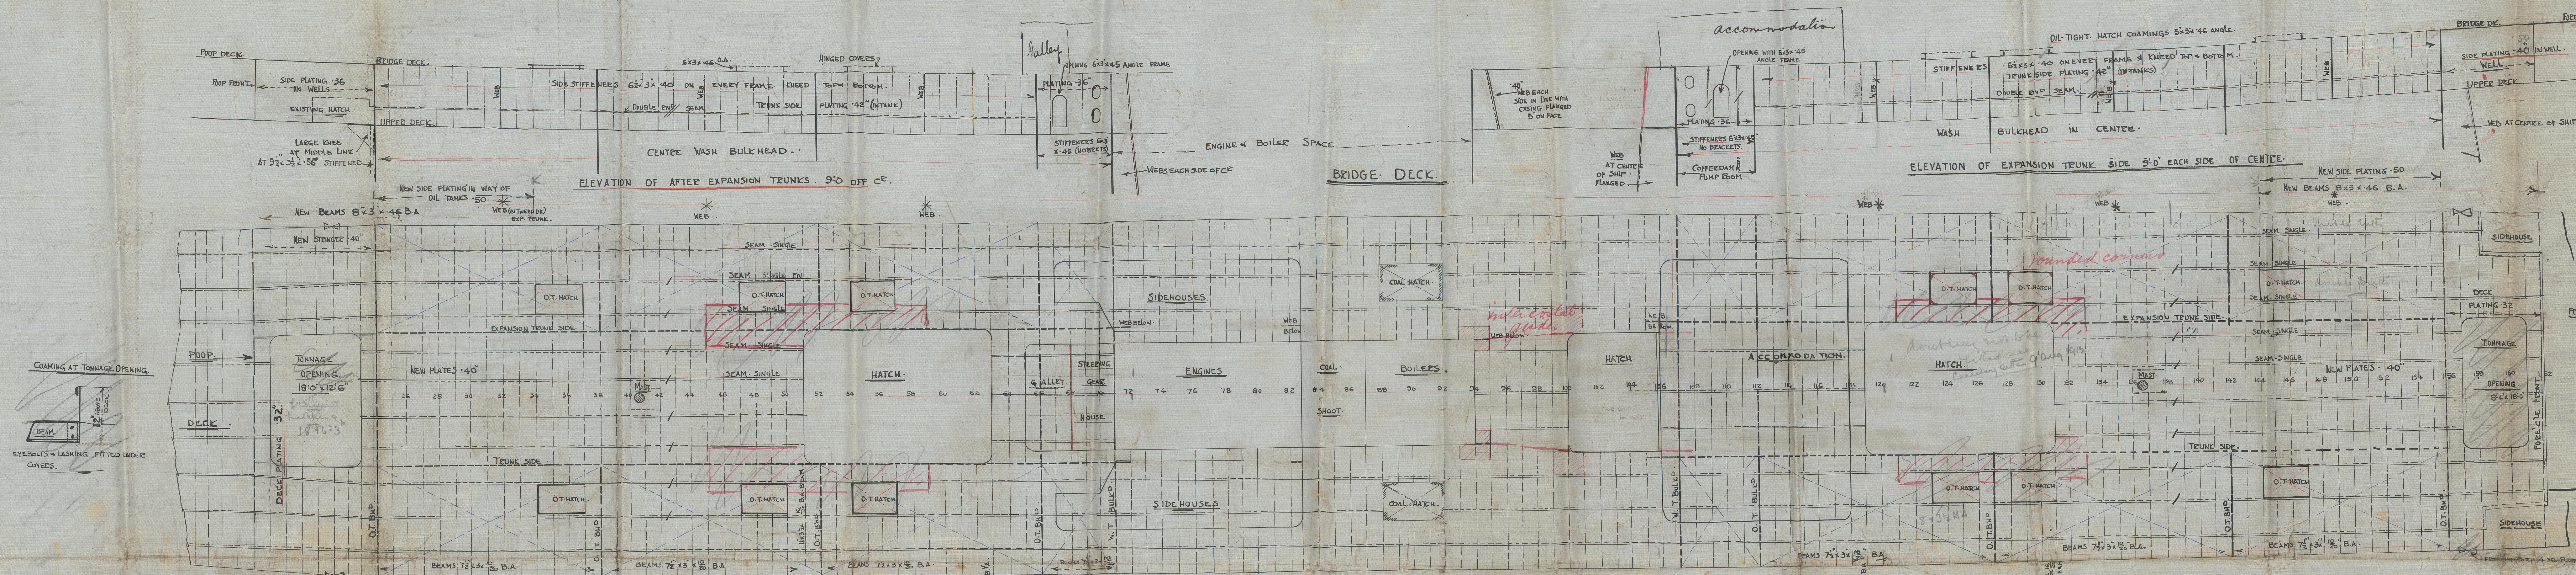

PIVETING	
BRIDGE DECK (EXISTING)	BRIDGE DECK (NEW)
SEAMS $\frac{3}{8}$ " DIA. 4" DIA. APART.	SEAMS $\frac{3}{8}$ " DIA. 3" DIA. APART.
LAPS " " 4 " "	LAPS " " " " "
BEAMS " " 7 " "	NEW BEAMS " " 6 " "
MAIN DECK (EXISTING) AT TANK TOP	MAIN DECK NEW AT TANK TOP
SEAMS $\frac{3}{8}$ " DIA. 4" DIA. APART.	SEAMS $\frac{3}{8}$ " DIA. 3" DIA. APART.
LAPS " " 4 " "	LAPS " " " " "
BEAMS " " 7 " "	NEW BEAMS " " 6 " "

SKETCH SHEWING ARRANGEMENT OF DECK PLATING

SCALE 1" = 10'

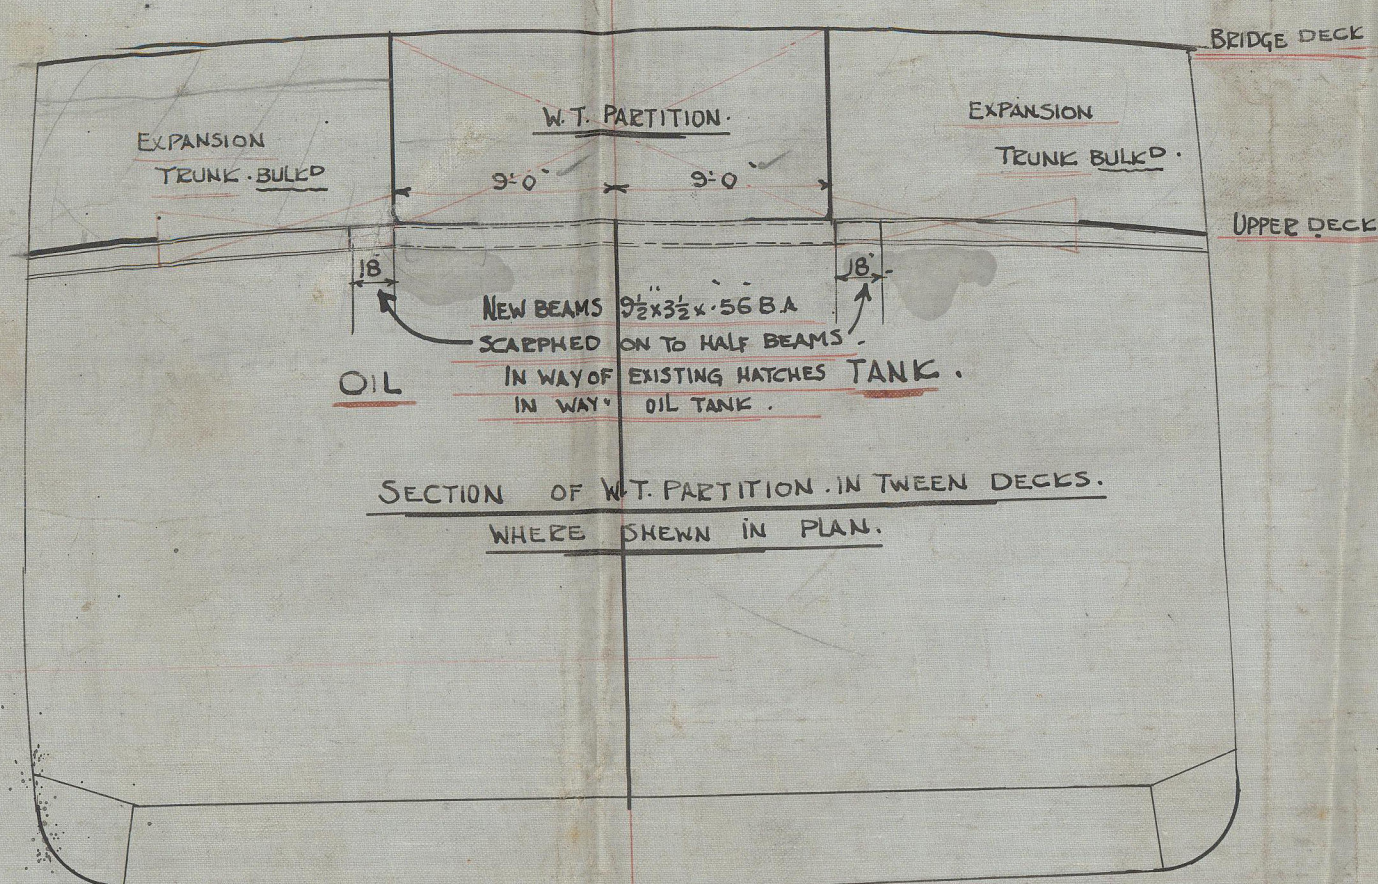

C.B.
27.6.12

109-0005

Dear Smith Dock 60 2

S. S. Harport

Arrangement of Deck plating

Med. Report 7623



BRIDGE DECK (EXISTING)

SEAMS 3/4 DIA.

LAYS


BEAMS

MAIN DECK (EXISTING)


SEAMS 3/4 DIA.

LAYS

BEAMS

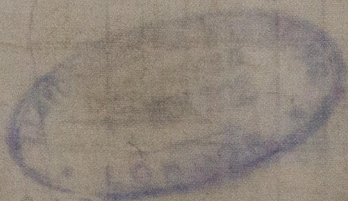

2 1/2 HAR

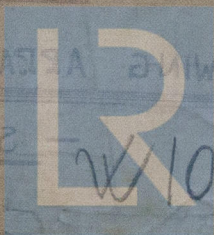

© 2020

Lloyd's Register Foundation