

TRANSVERSE N° = 76.66
BHD DEPTH ~~8~~ = 25.46
RULE FLOORS FOR OIL BOAT = 31 x 48 = 38

1/3 HARPOT

ONE TIGHT TRANSVERSE BULKHEADS

SCALE 1/2" = 1 FOOT

DIMENSIONS 370' x 50-0EXT x 27-0 M

W109-0006








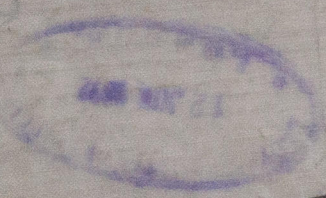


© 2020

W109-0006

Lloyd's Register
Foundation

"Harport"
mab. Report 7623

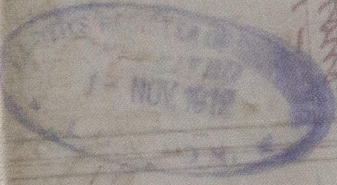

W/109-0006



© 2020

Lloyd's Register
Foundation