


S.S. HARPORT.

CENTRE LINE WASH BULKHEAD.


SCALE $\frac{1}{4}'' = 1 \text{ FOOT.}$

ELEVATION.


ELEVATION OF WEB.

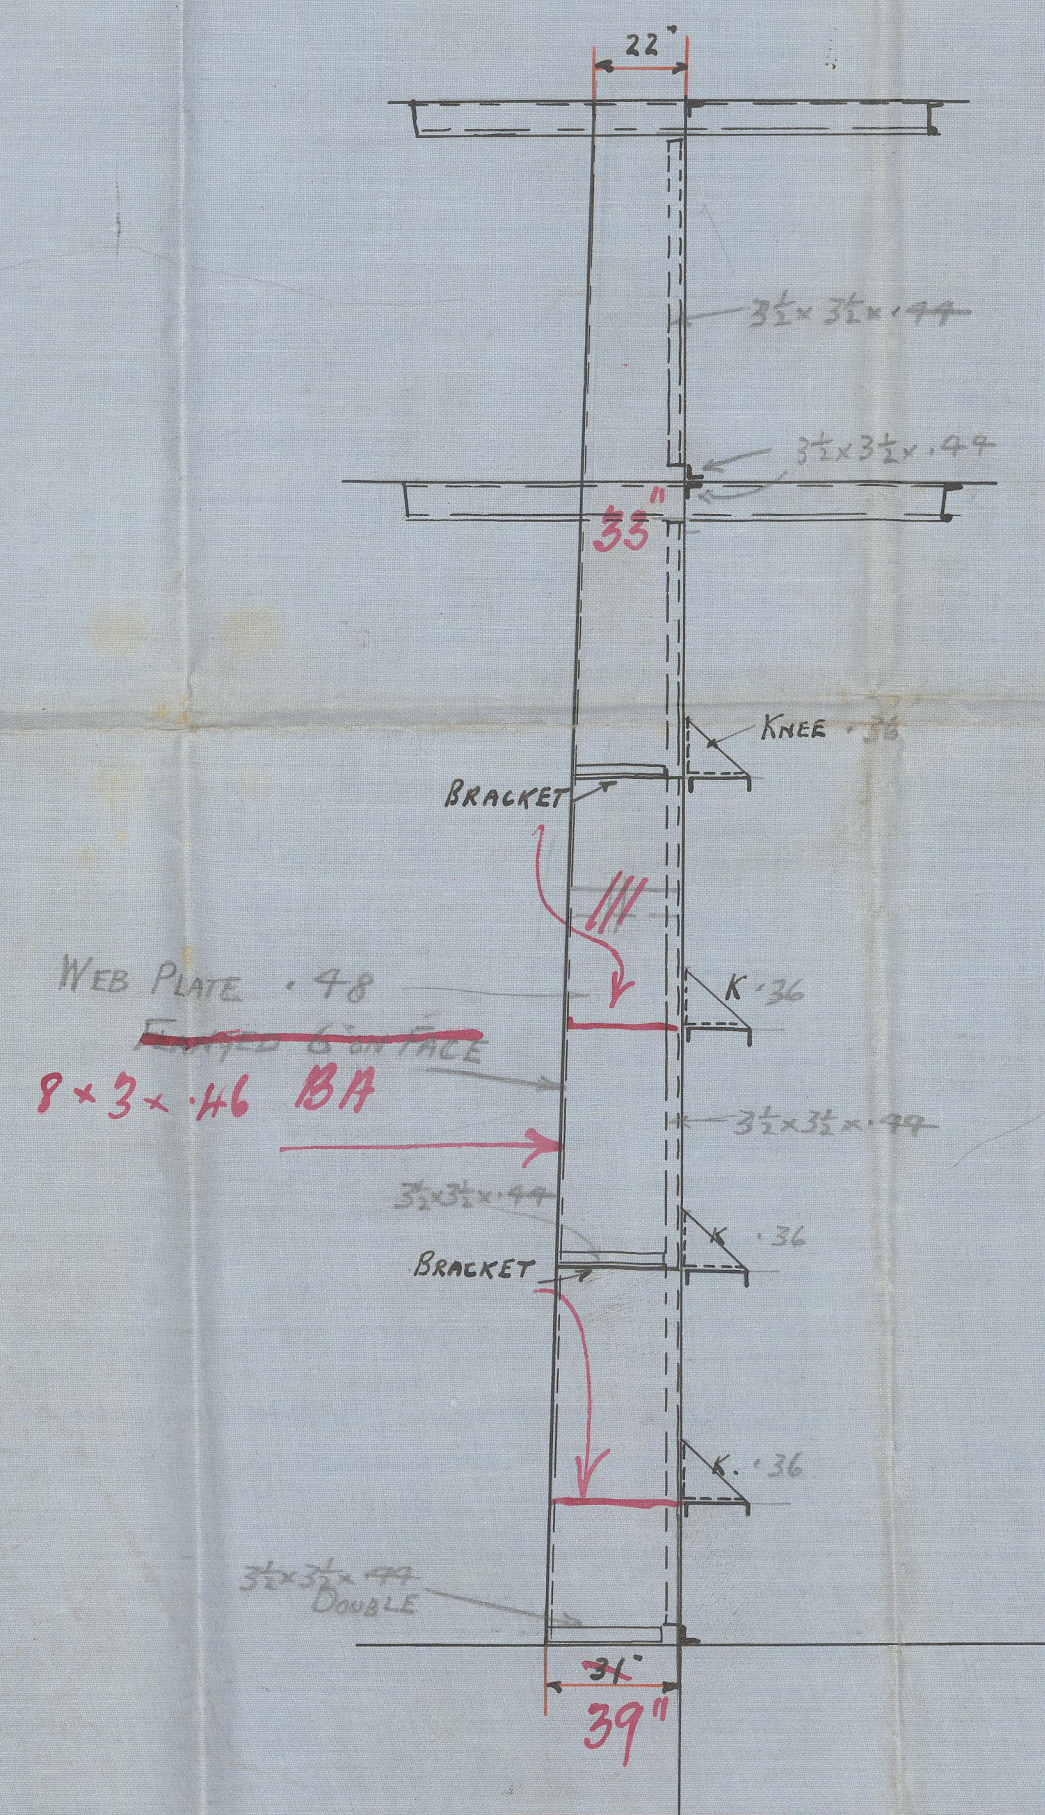


НАТСН ТОР.

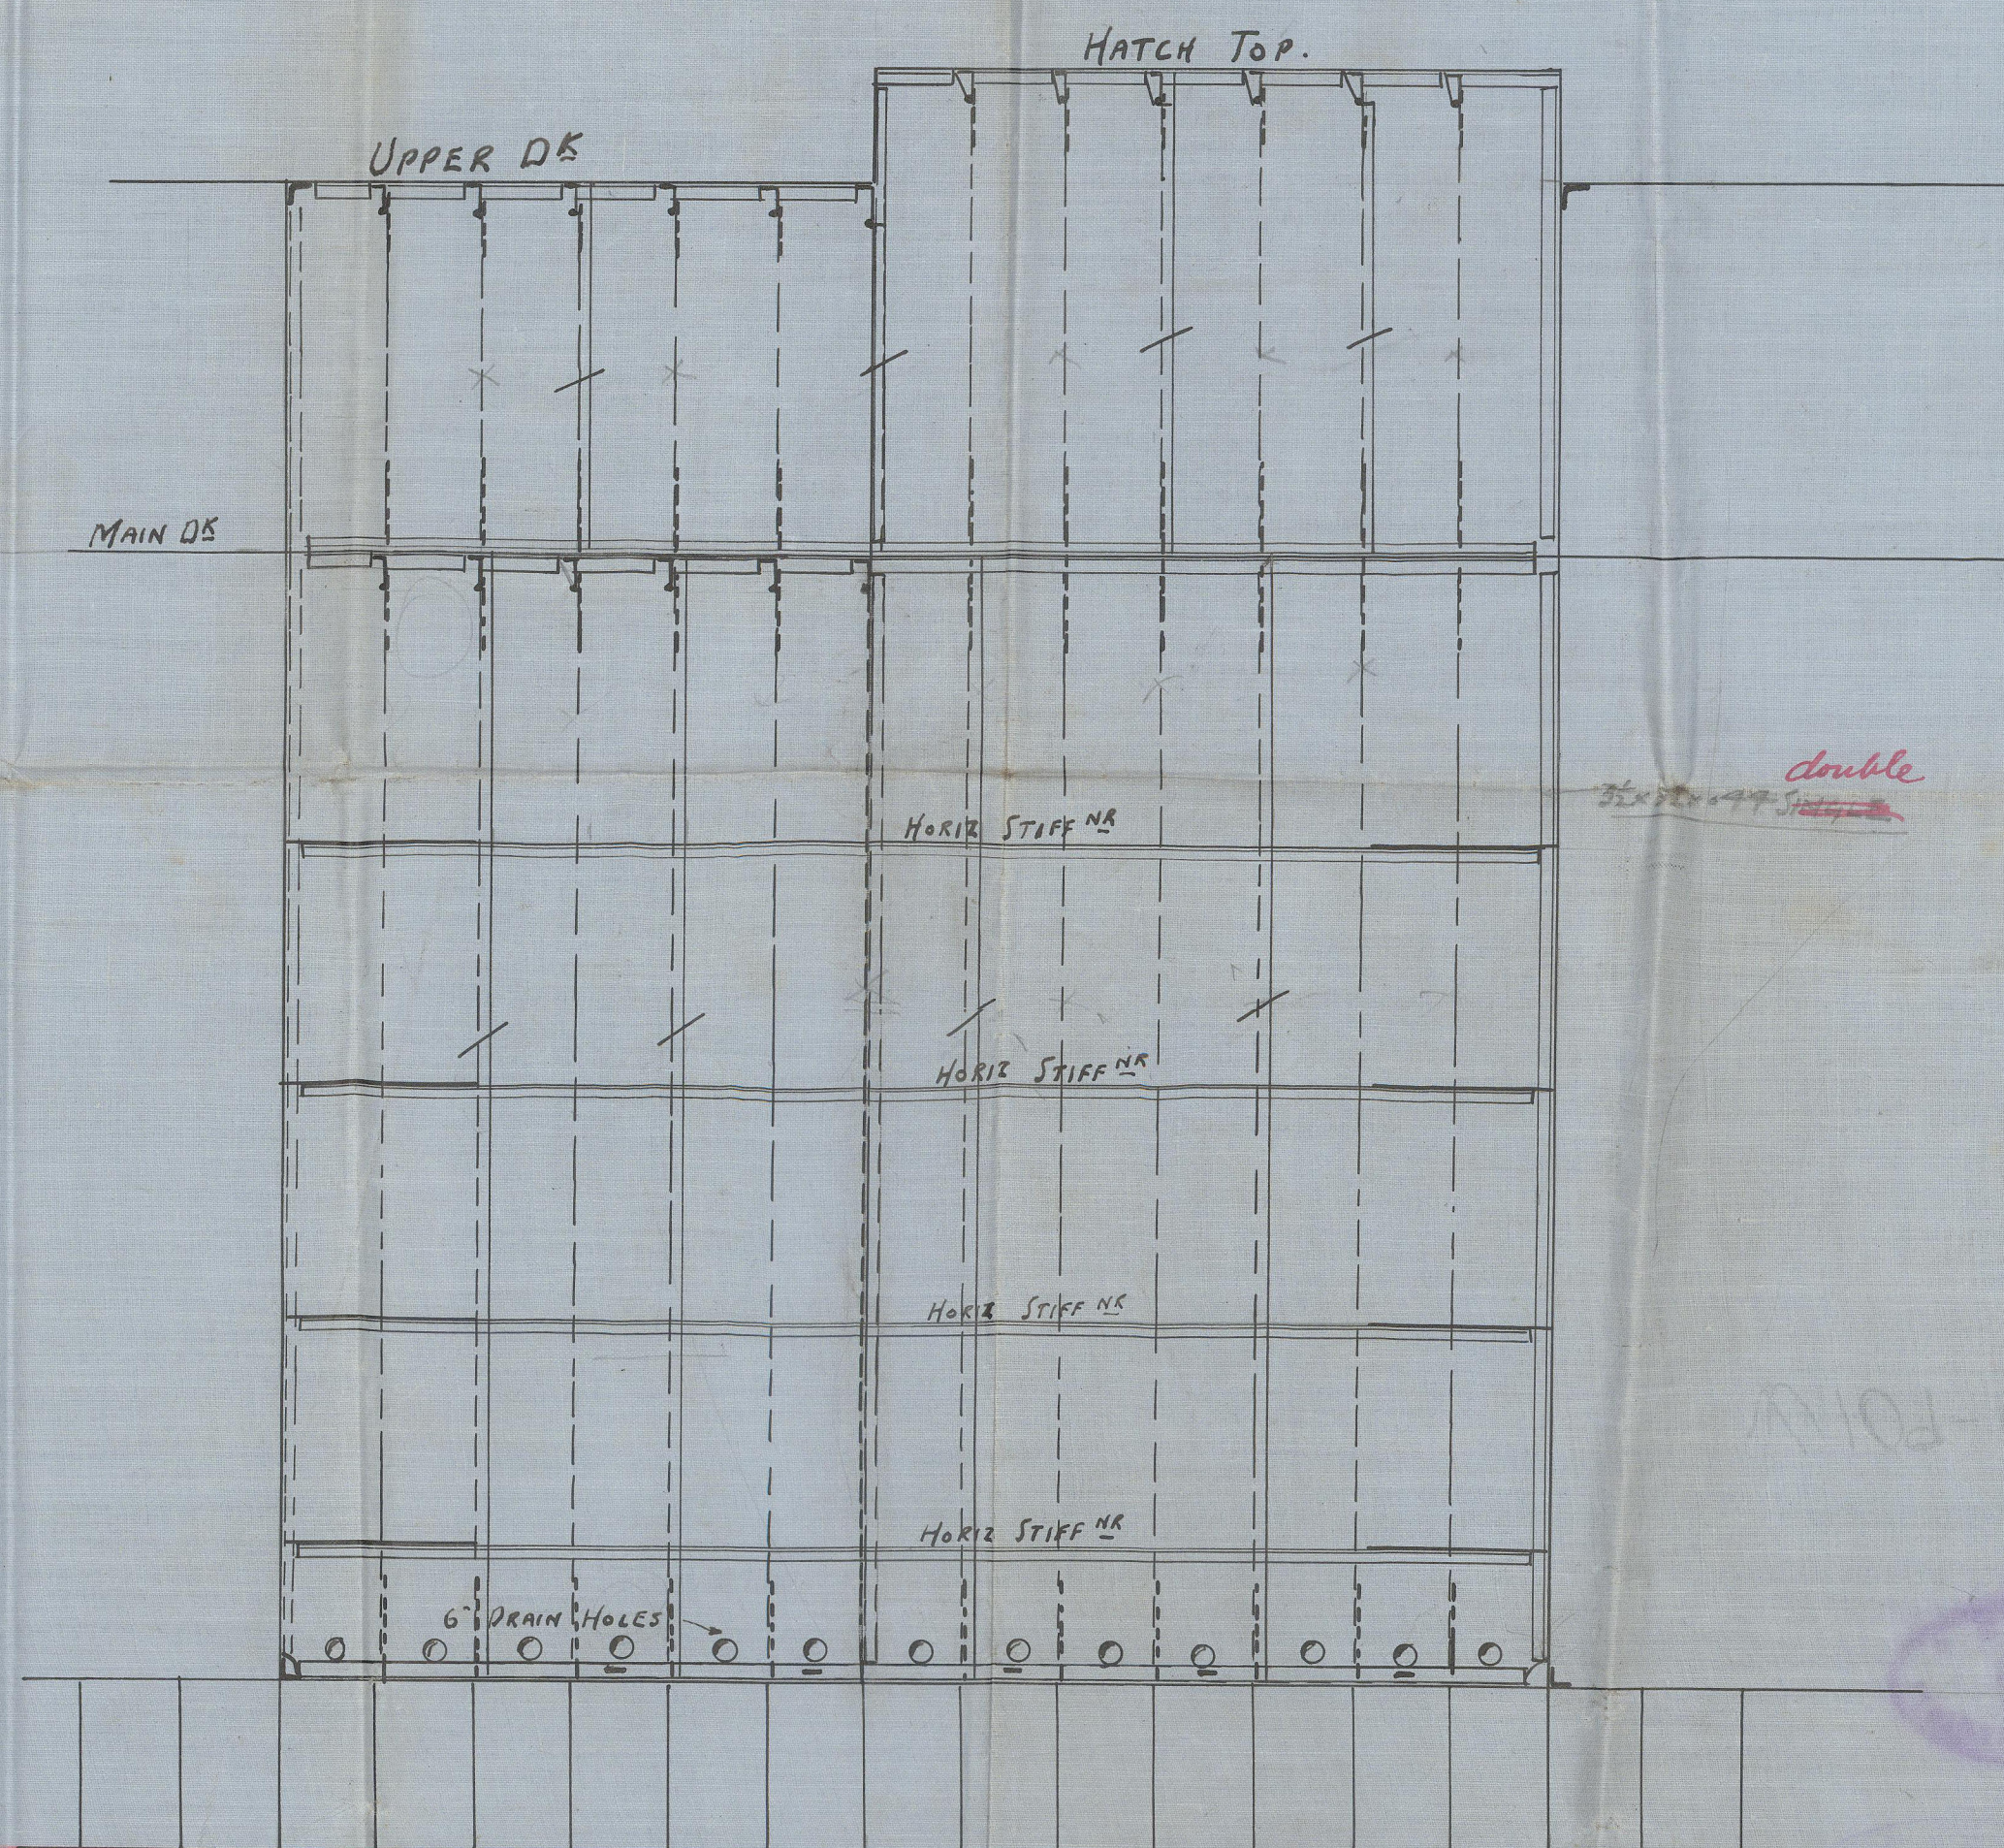

ELEVATION AT STIFFENERS

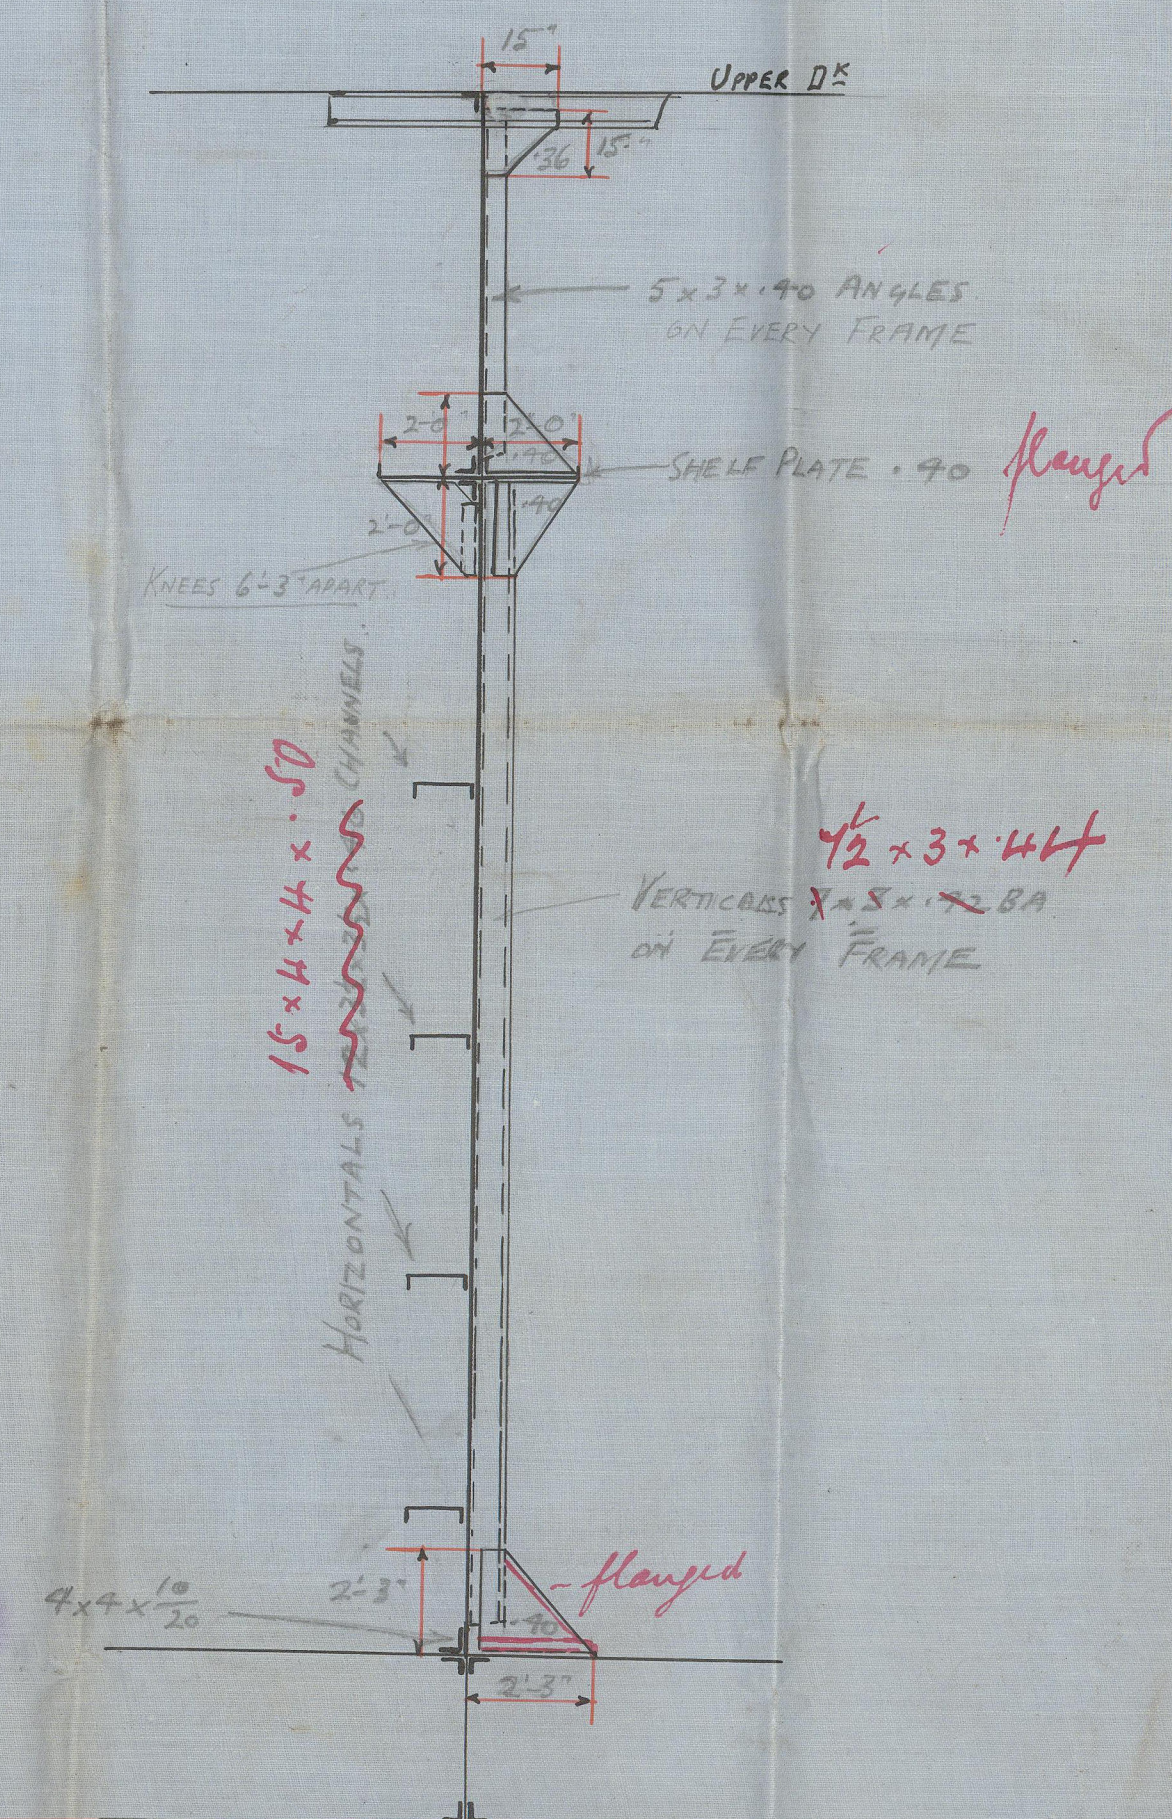

PLAN.

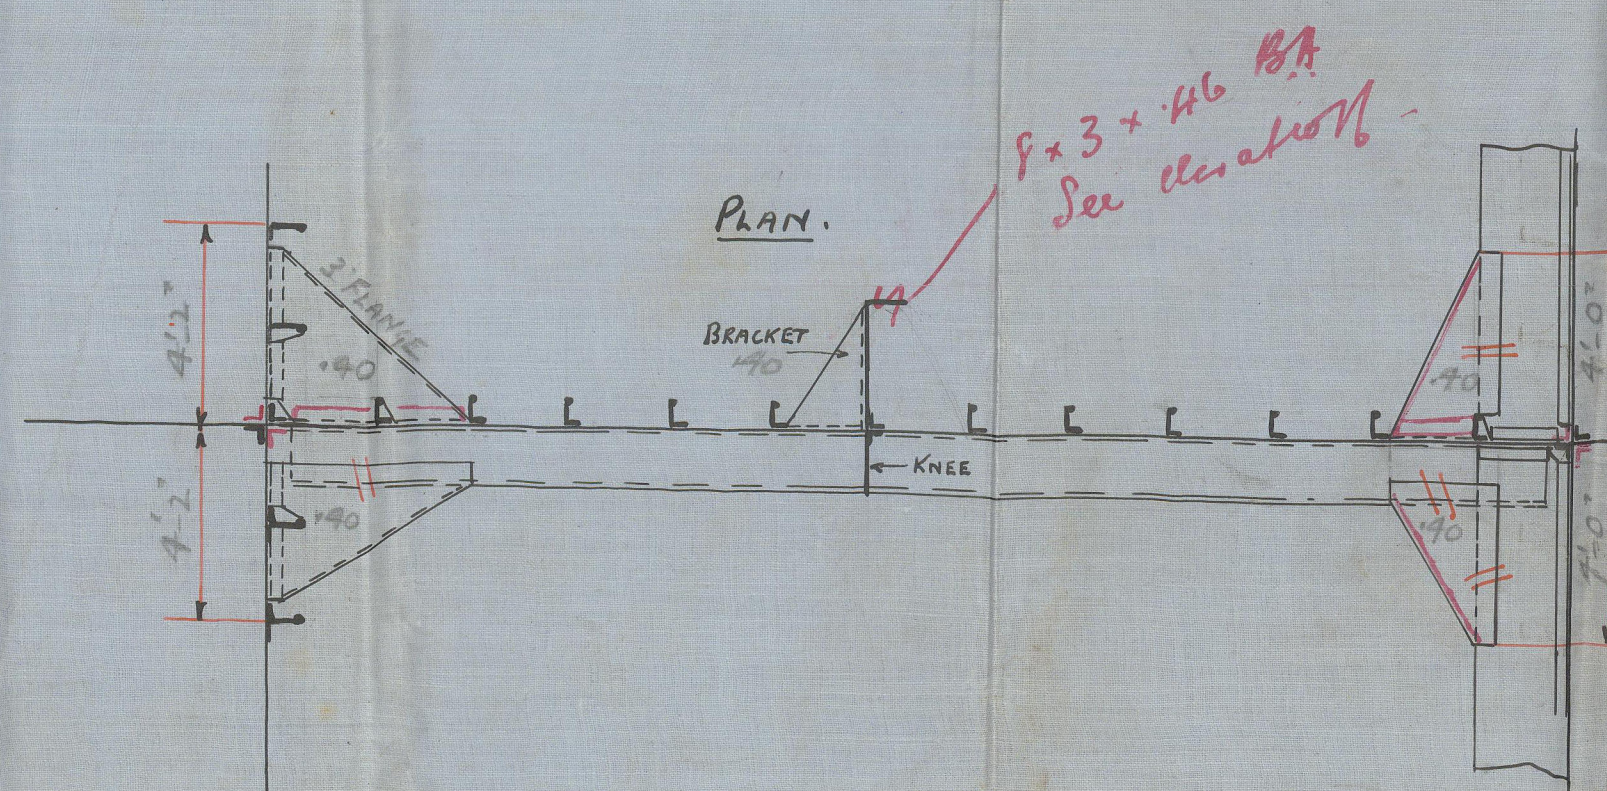

W/109-0007

REPORT.

WASH

$\frac{1}{4} = 1500$

ELEVATION

UPPER DR



© 2020

Lloyd's Register
Foundation