




16.8.12

S/S HARPORT.

ARRANGEMENT OF OIL FUEL TANKS.

SCALE $\frac{1}{8}'' = 1$ FOOT.

226
13/8/12
17/11

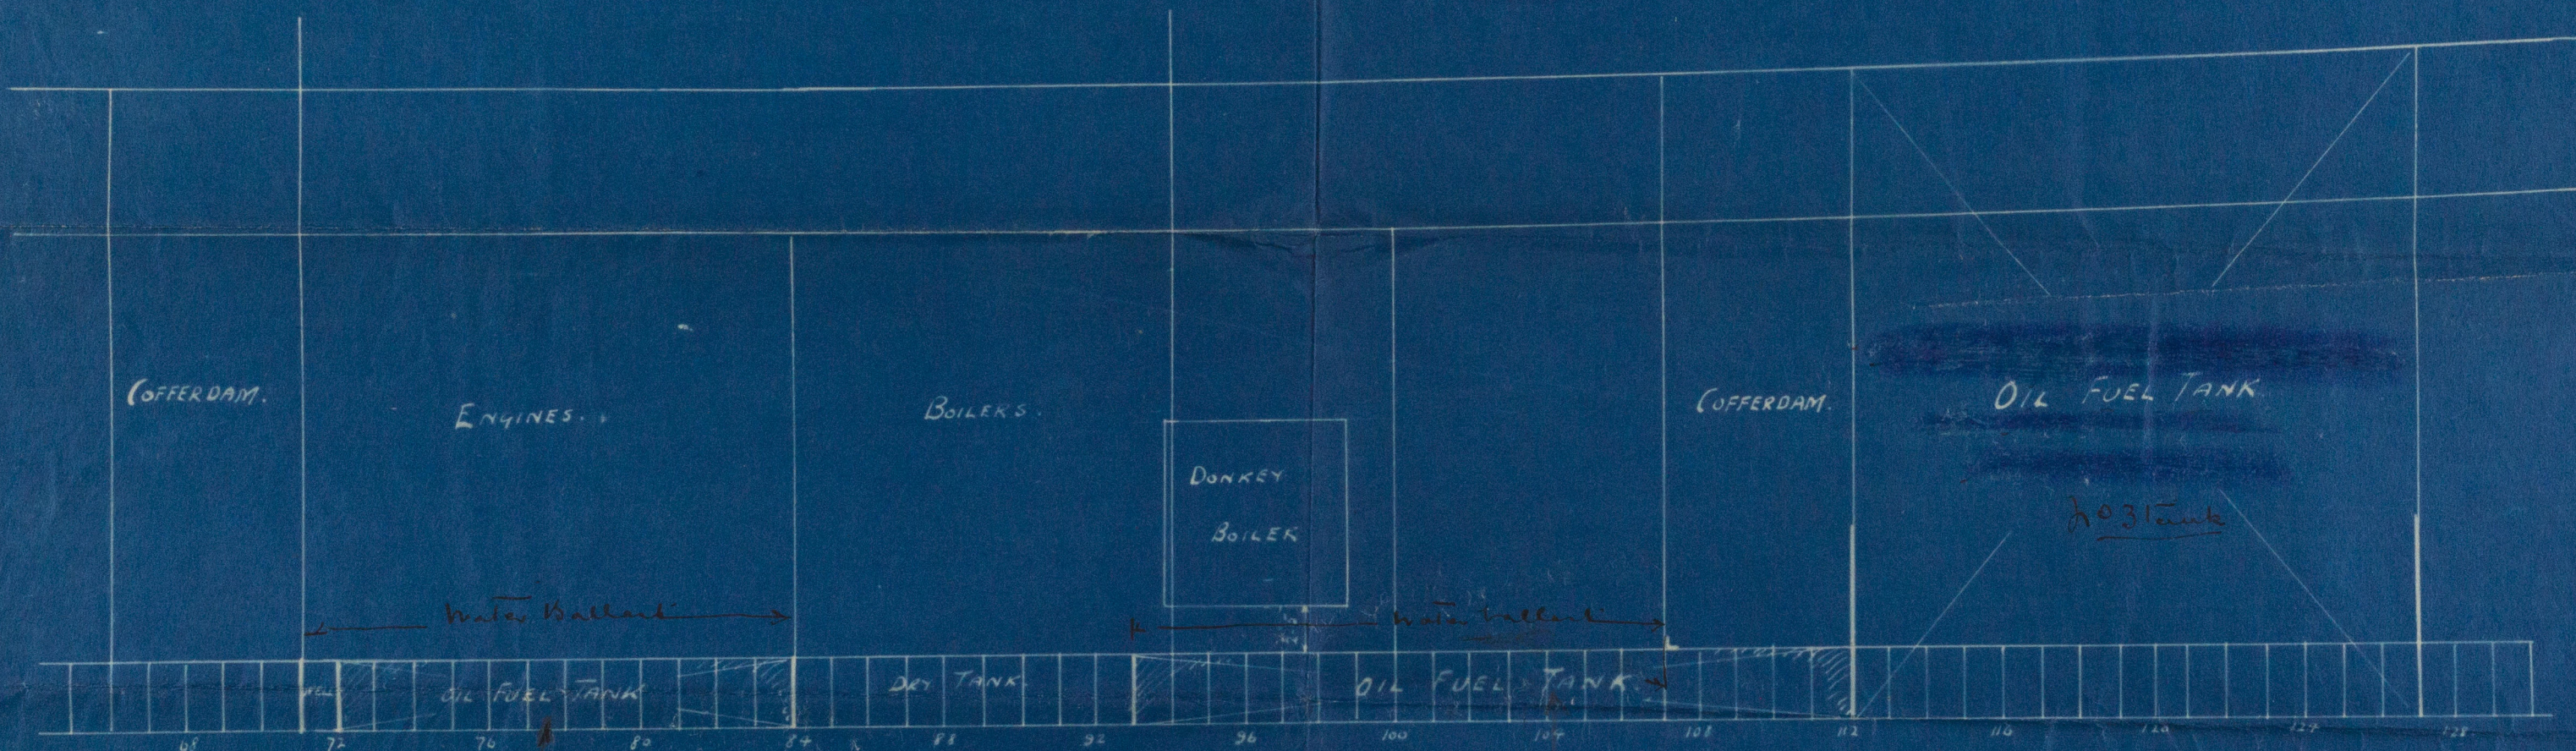

0105-0008




16.8.12

S. S. Harport

General Arrangements

g. Oil Fuel Tank

Dist. Report 7627

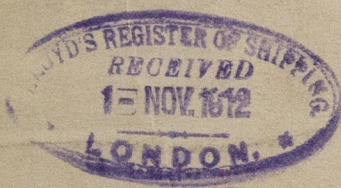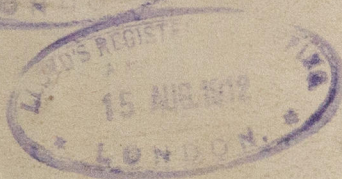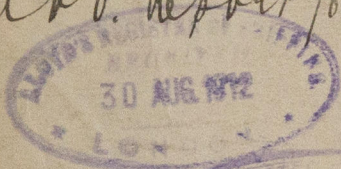

X1109-0008

© 2020

Lloyd's Register
Foundation