


1/5 HARPORT.

SECTION AT WEB FRAMES + C.


SCALE 1/2" = 1 FOOT.

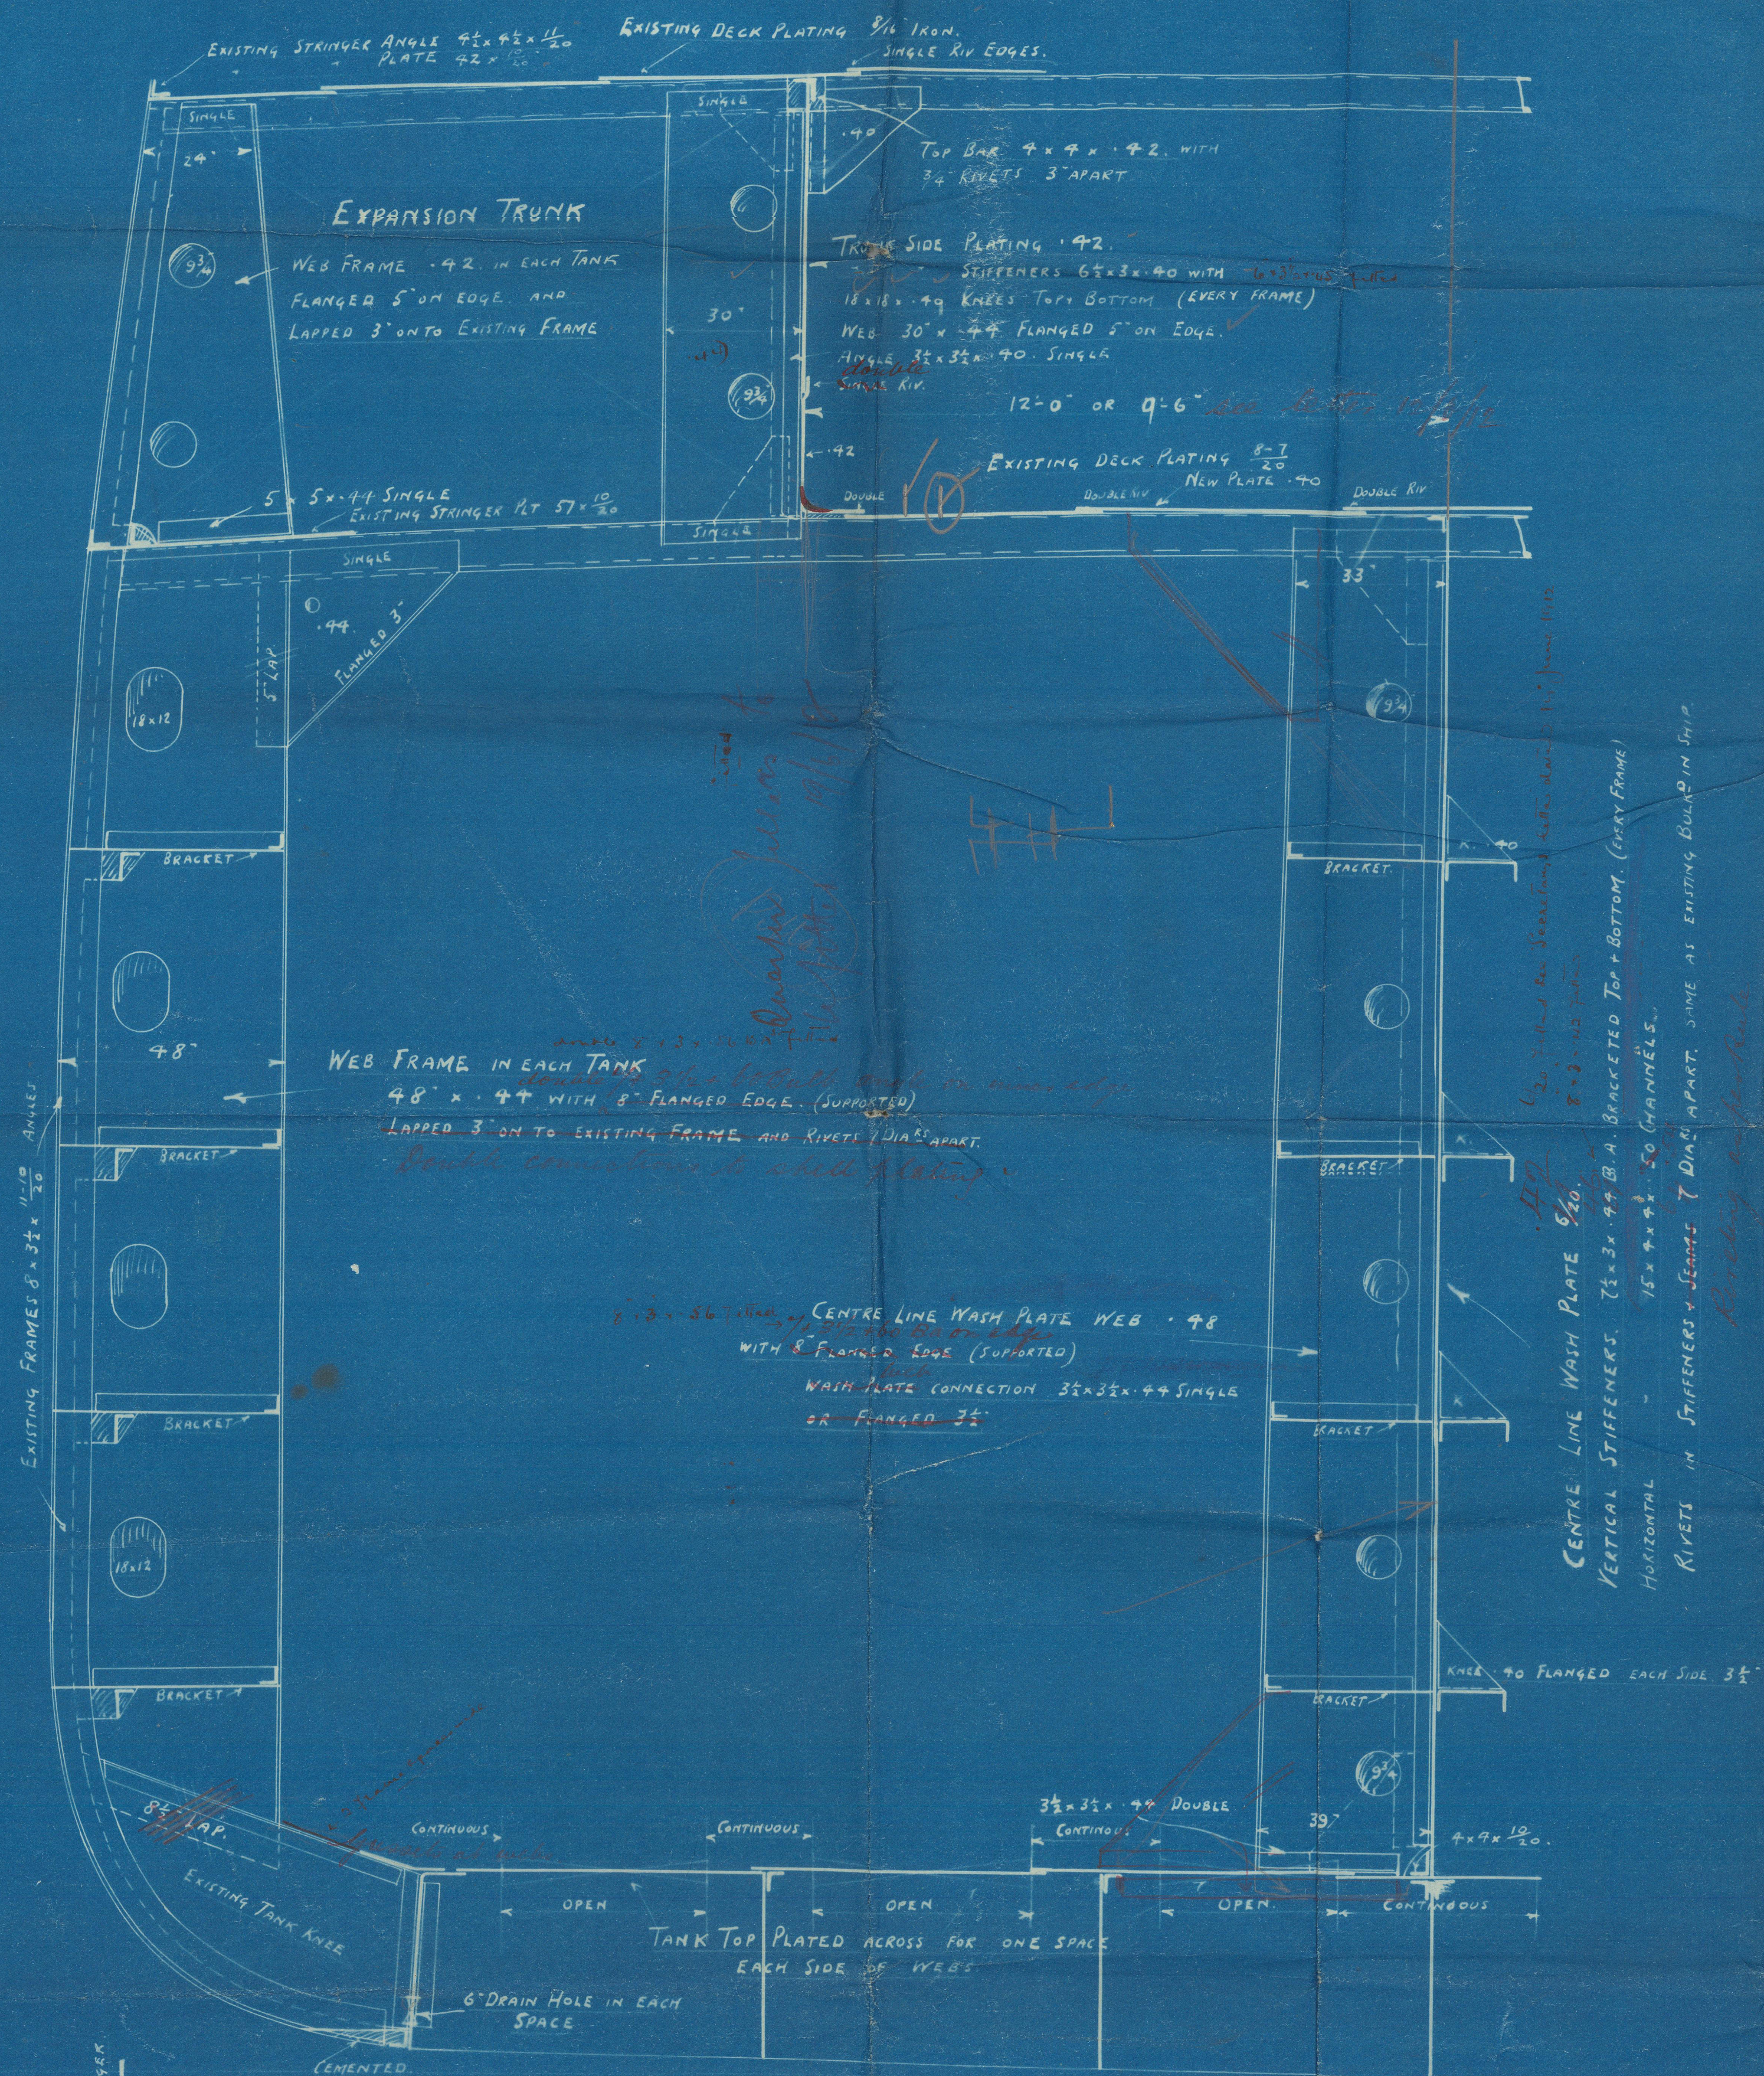




RIVETING. *Refer Rule 21, 22*
 IN ALL BRACKET KNEES, TO WEBS + ALSO ENDS OF ALL WEBS (LAP INCLUDED)
 RIVETS 3/4" DIA NOT MORE THAN 3 3/4" APART
 IN ALL CONNECTING BARS (EXCEPT WHERE OTHERWISE STATED)
 RIVETS 3/4" DIA NOT MORE THAN 4 1/2" APART.

CENTRE LINE WASH PLATE IN WAY
 OF SHAFT TUNNEL.

SCALE 1/2" = 1 FOOT.

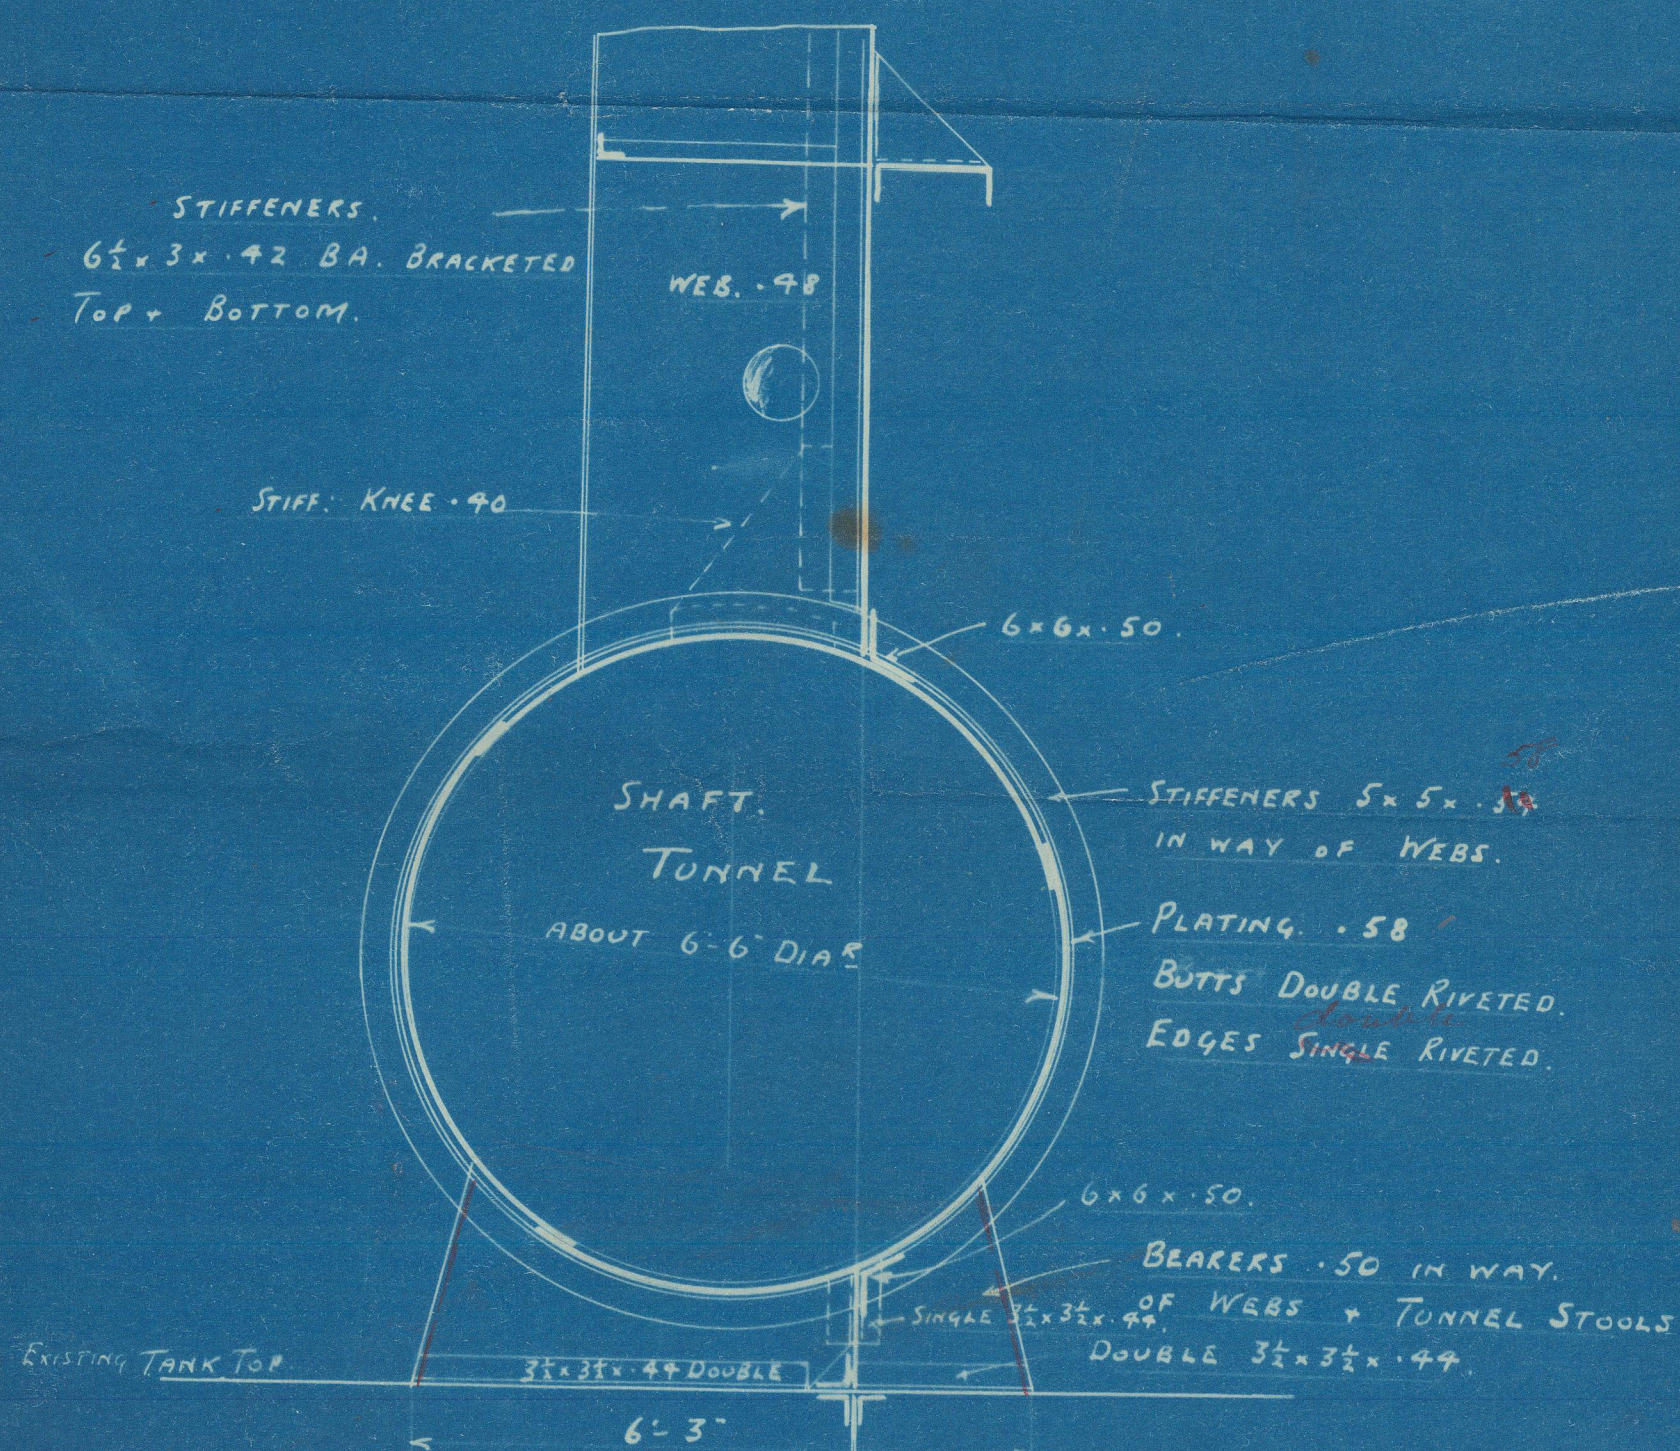


ALTERNATIVE
 TUNNEL WITH 2 PLATES IN THE ROUND
 ARRANGED THUS:-

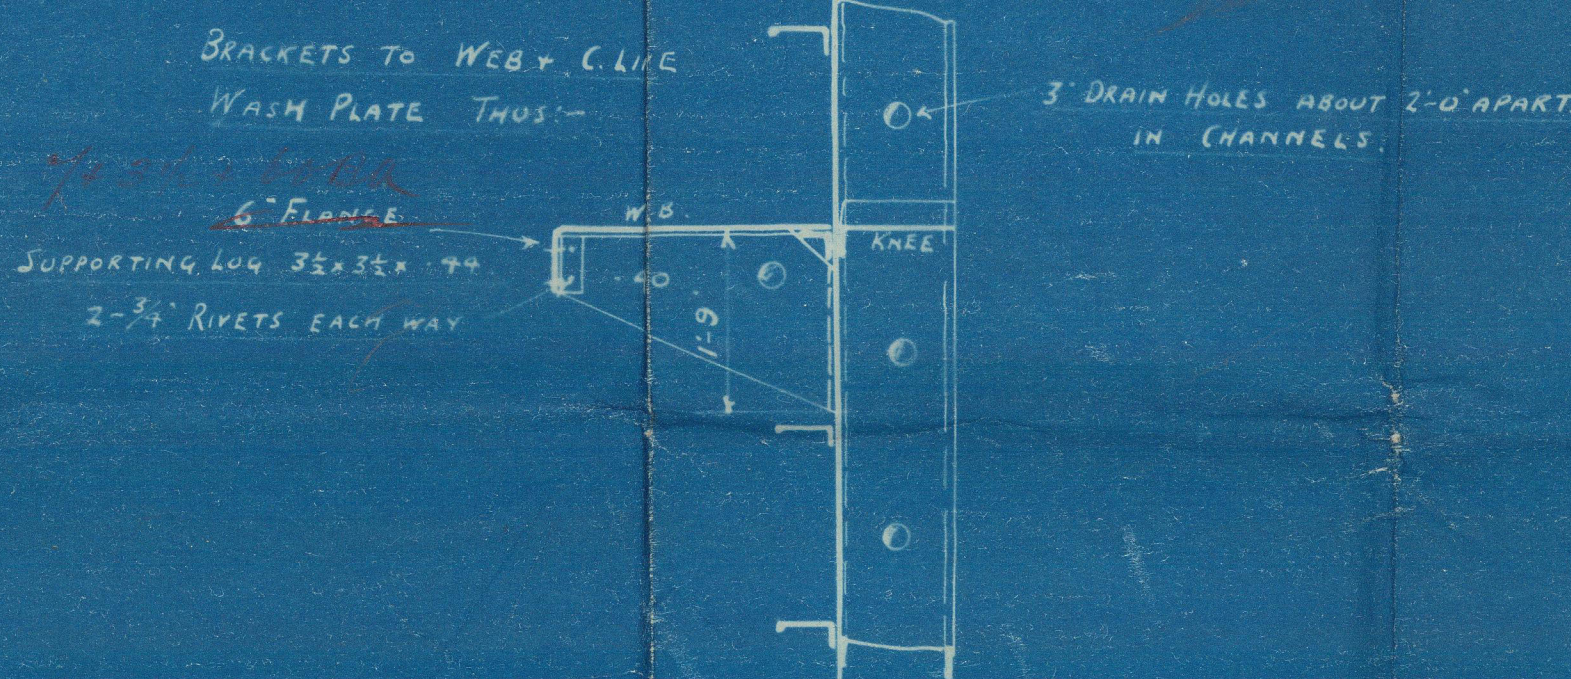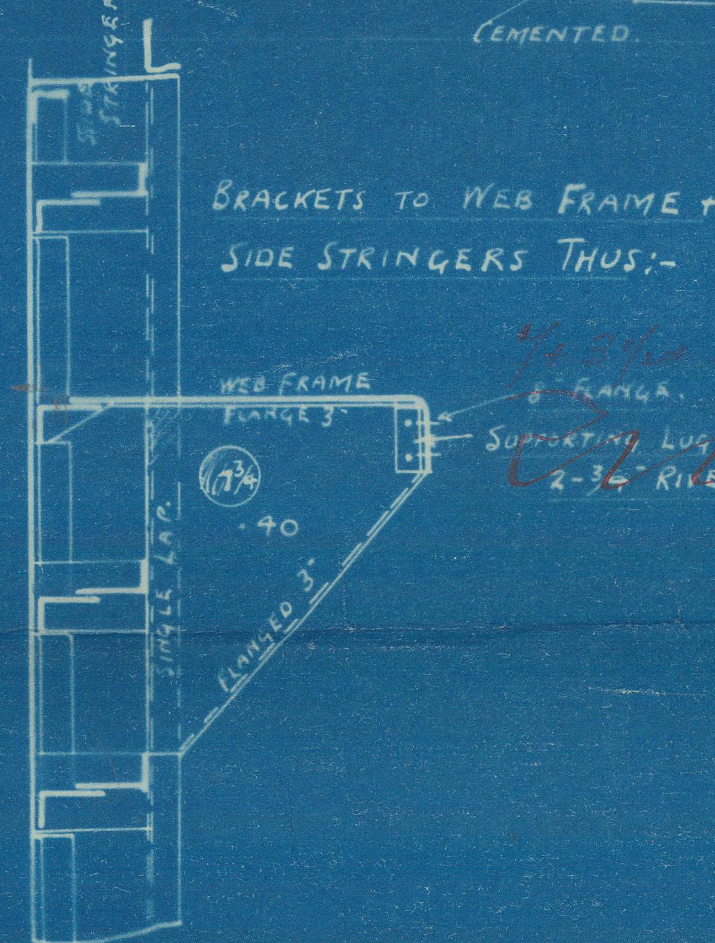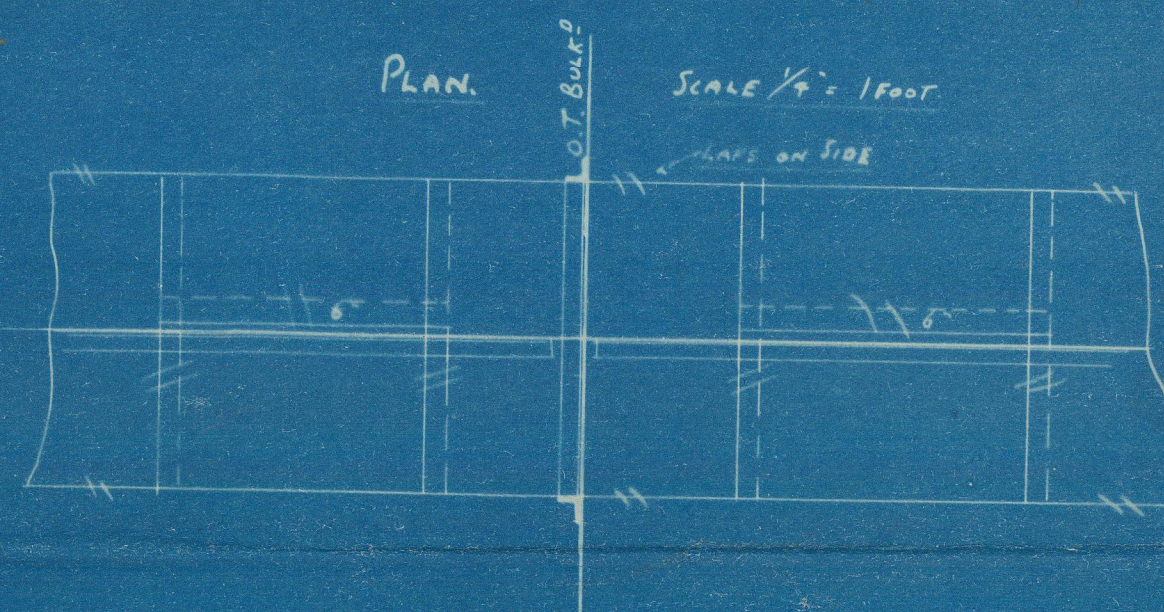

C2
 13/11/12




P. S. Harport

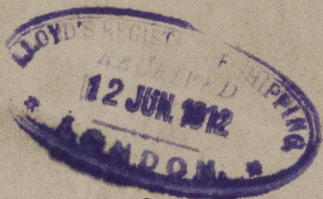

Section at. Web. Frame

+ Section of. Jewel

Web. Report 7623

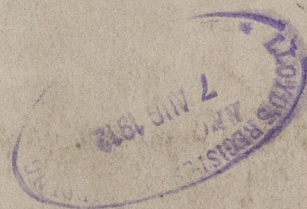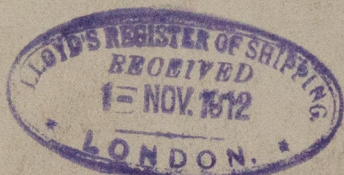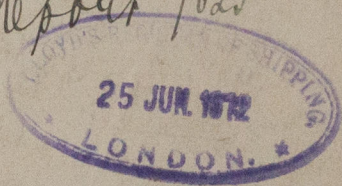

W/109-0010



© 2020

Lloyd's Register
Foundation