



31.7.12


S/S HARPORT

PLAN VIEW AT CASING TOP





PLAN SHOWING PROPOSED ENTRANCE

TO AFTER PUMP ROOM

SCALE 1/4" = 1 FOOT

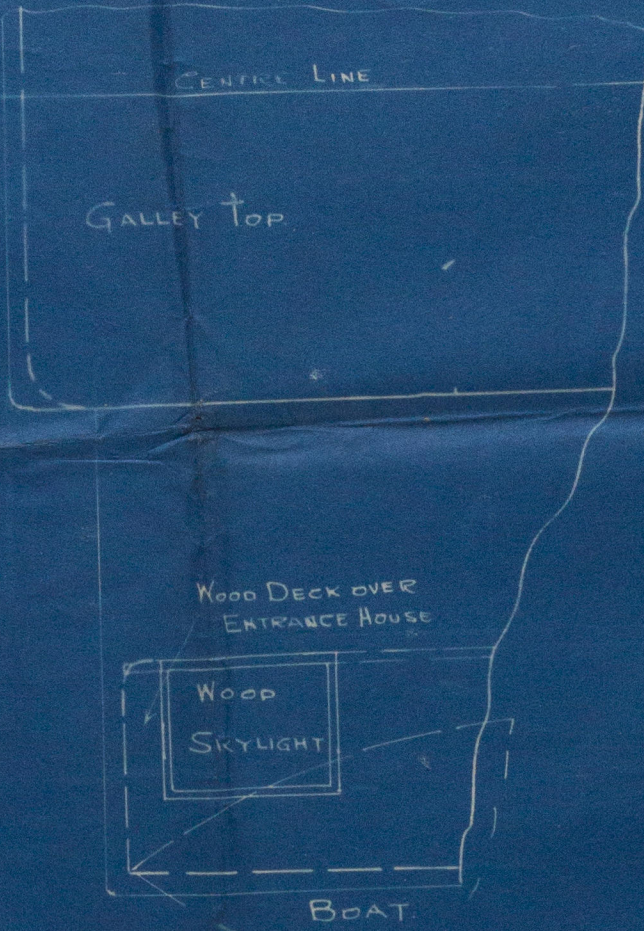

PLAN VIEW AT BRIDGE DECK

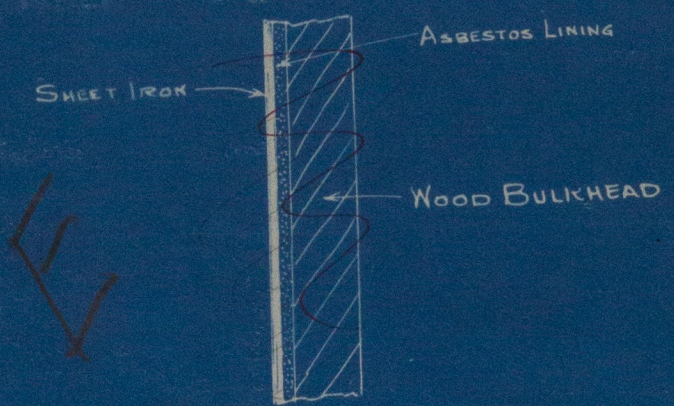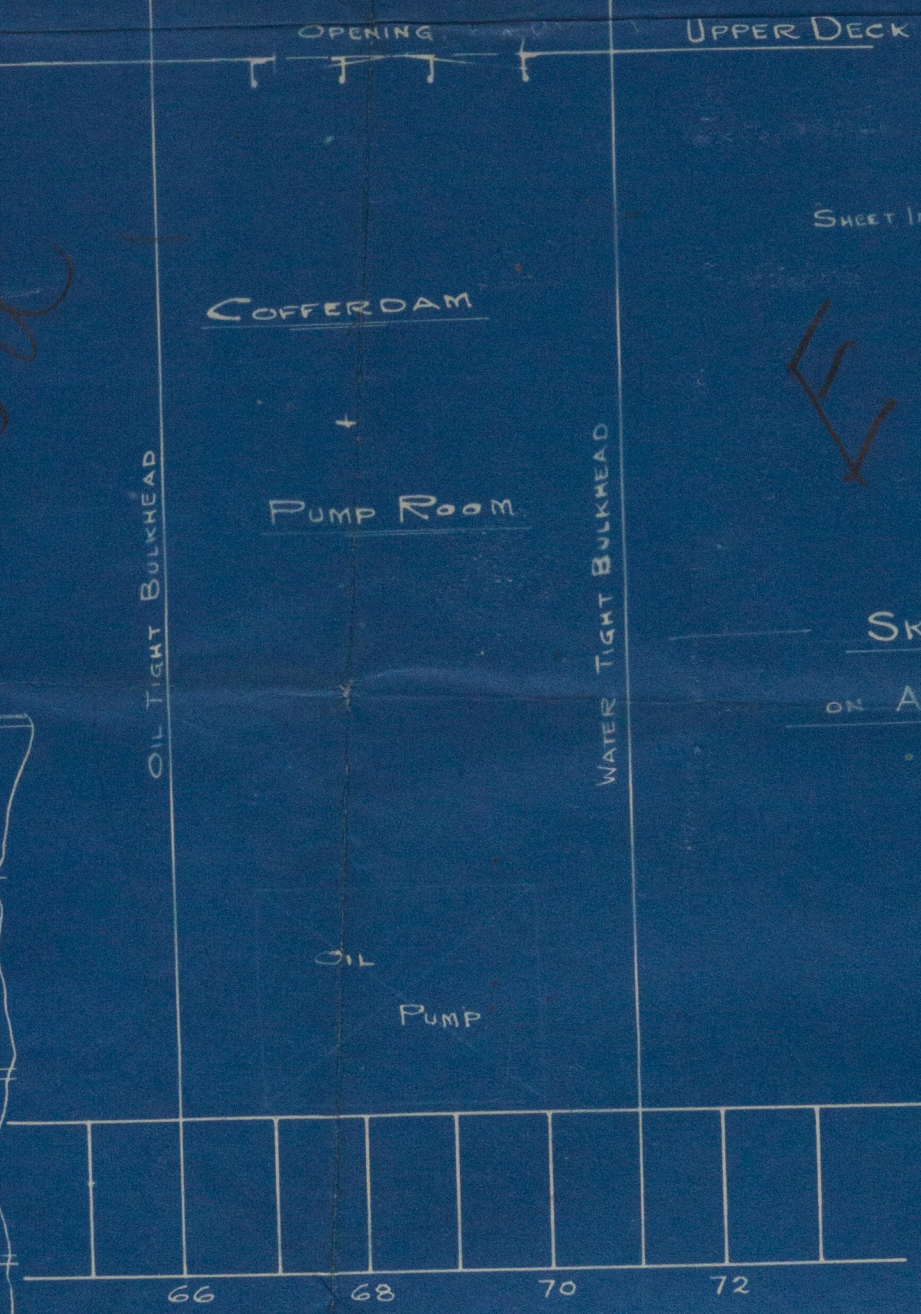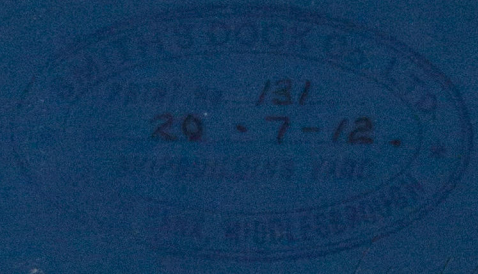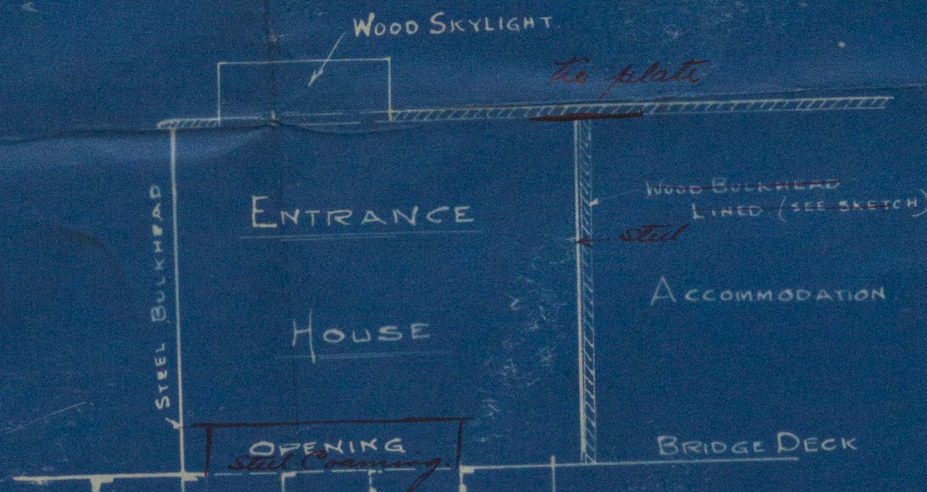


SKETCH OF LINING

ON ATHARTSHIP BULKHEAD

PLAN VIEW AT UPPER DECK

C.B.
30.7.12.

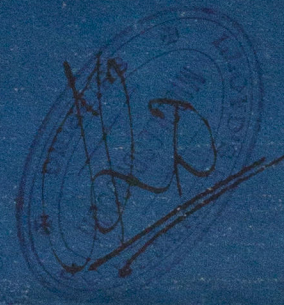


4414-0012

S.S. "Harport"

Proposed Entrance

Life Pump Room

Inst. Report 7623

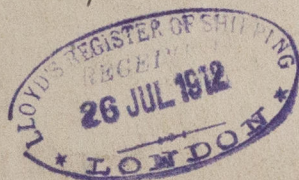

W 109 - 0012



© 2020

Lloyd's Register
Foundation